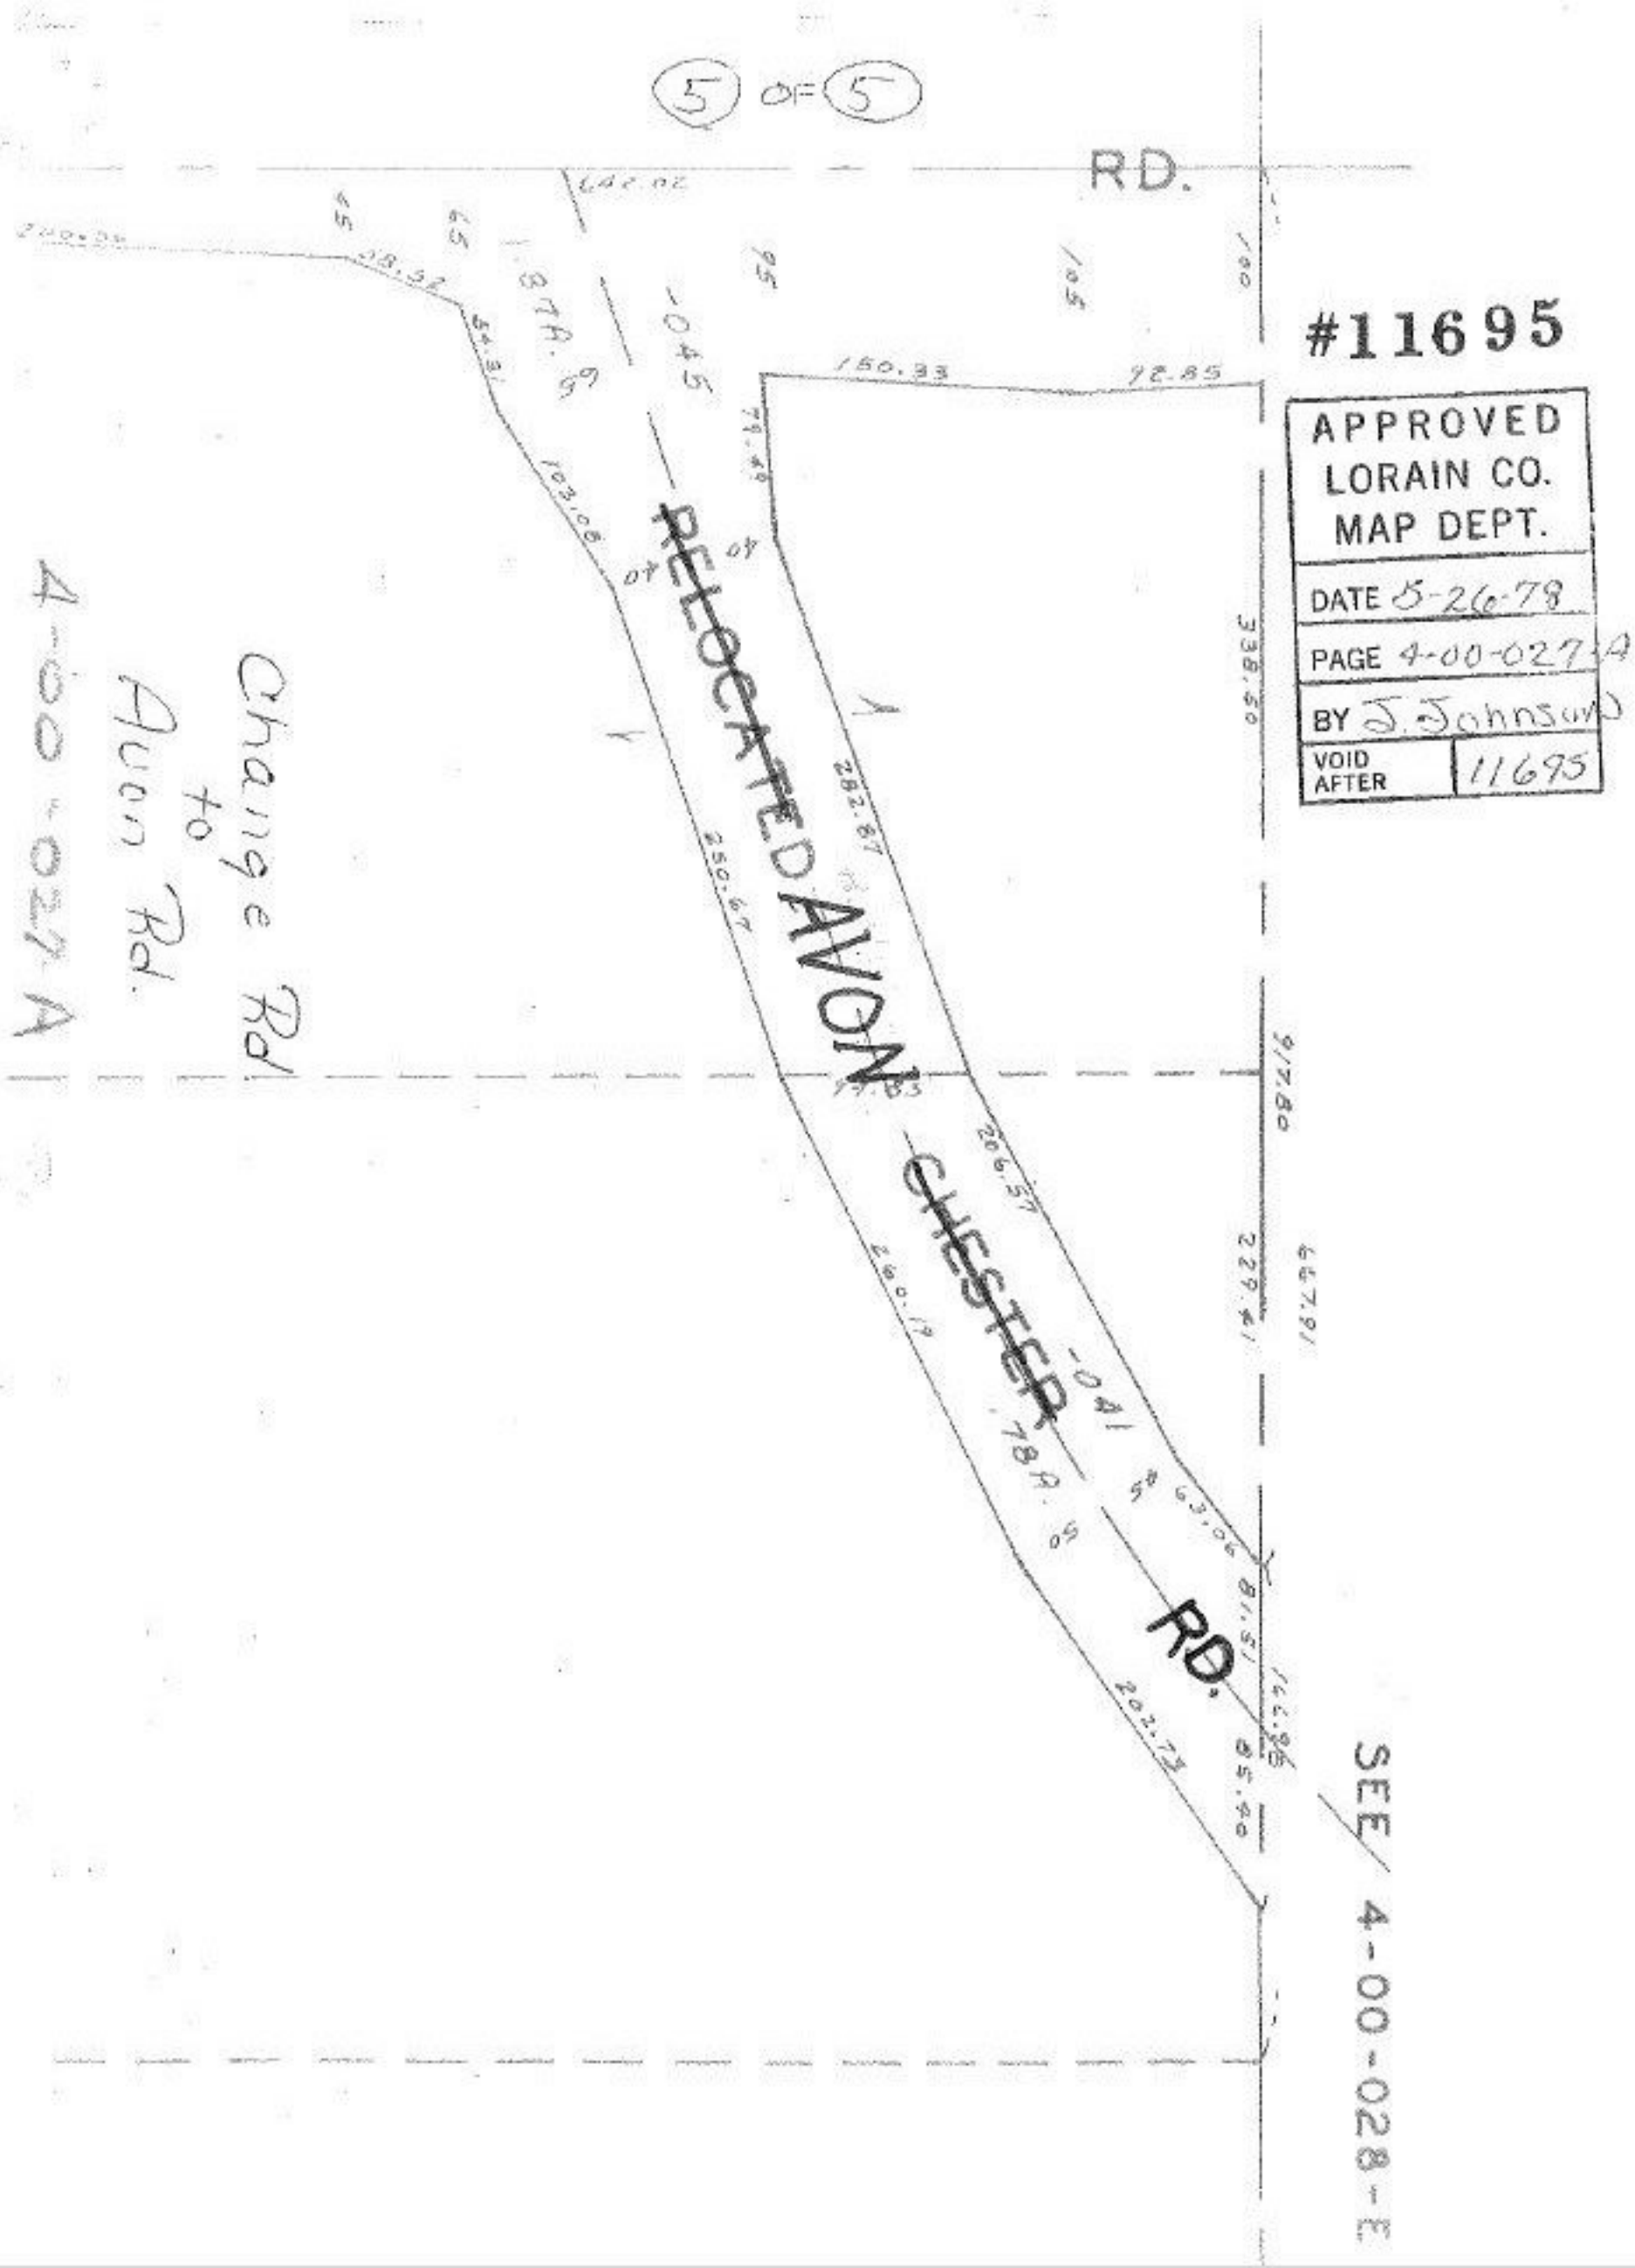
5 OF 5
RD.
#11695
APPROVED
LORAIN CO.
MAP DEPT.
DATE 5-26-78
PAGE 4-00-027-A
BY J. Johnson
VOID AFTER 11695
RELOCATED AVON CHESTER RD.
Change Rd to Avon Rd.
4-00-027 A
SEE 4-00-028-E