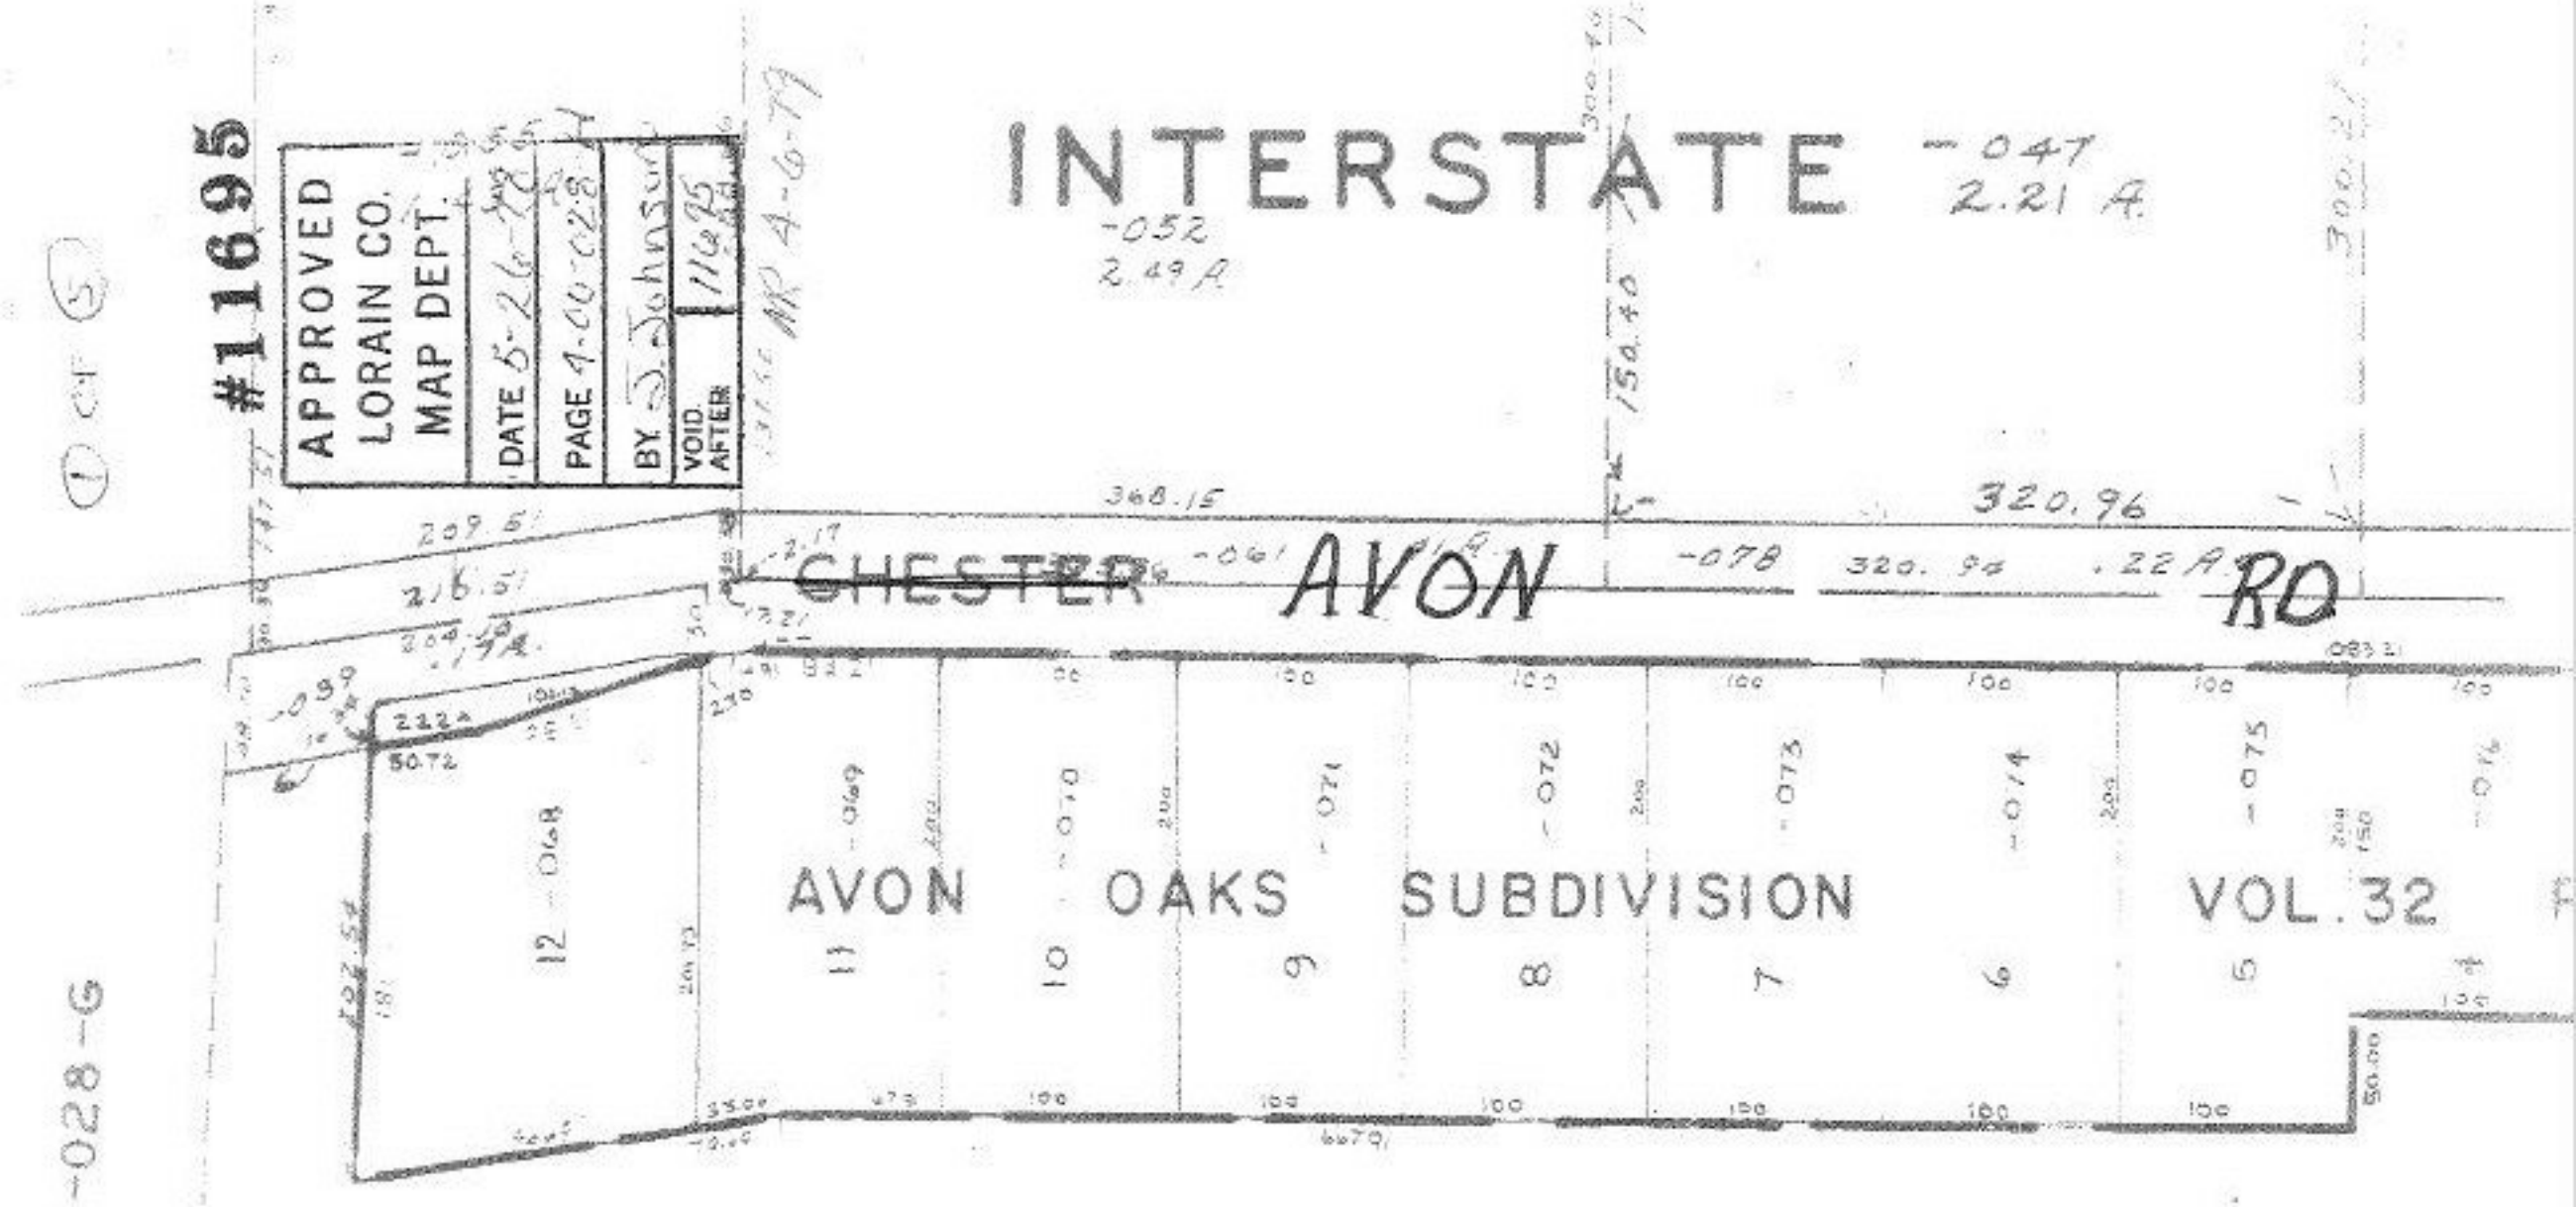

Change ~~Page~~ Rd.
to
Avon Road

102

4-00-028-H