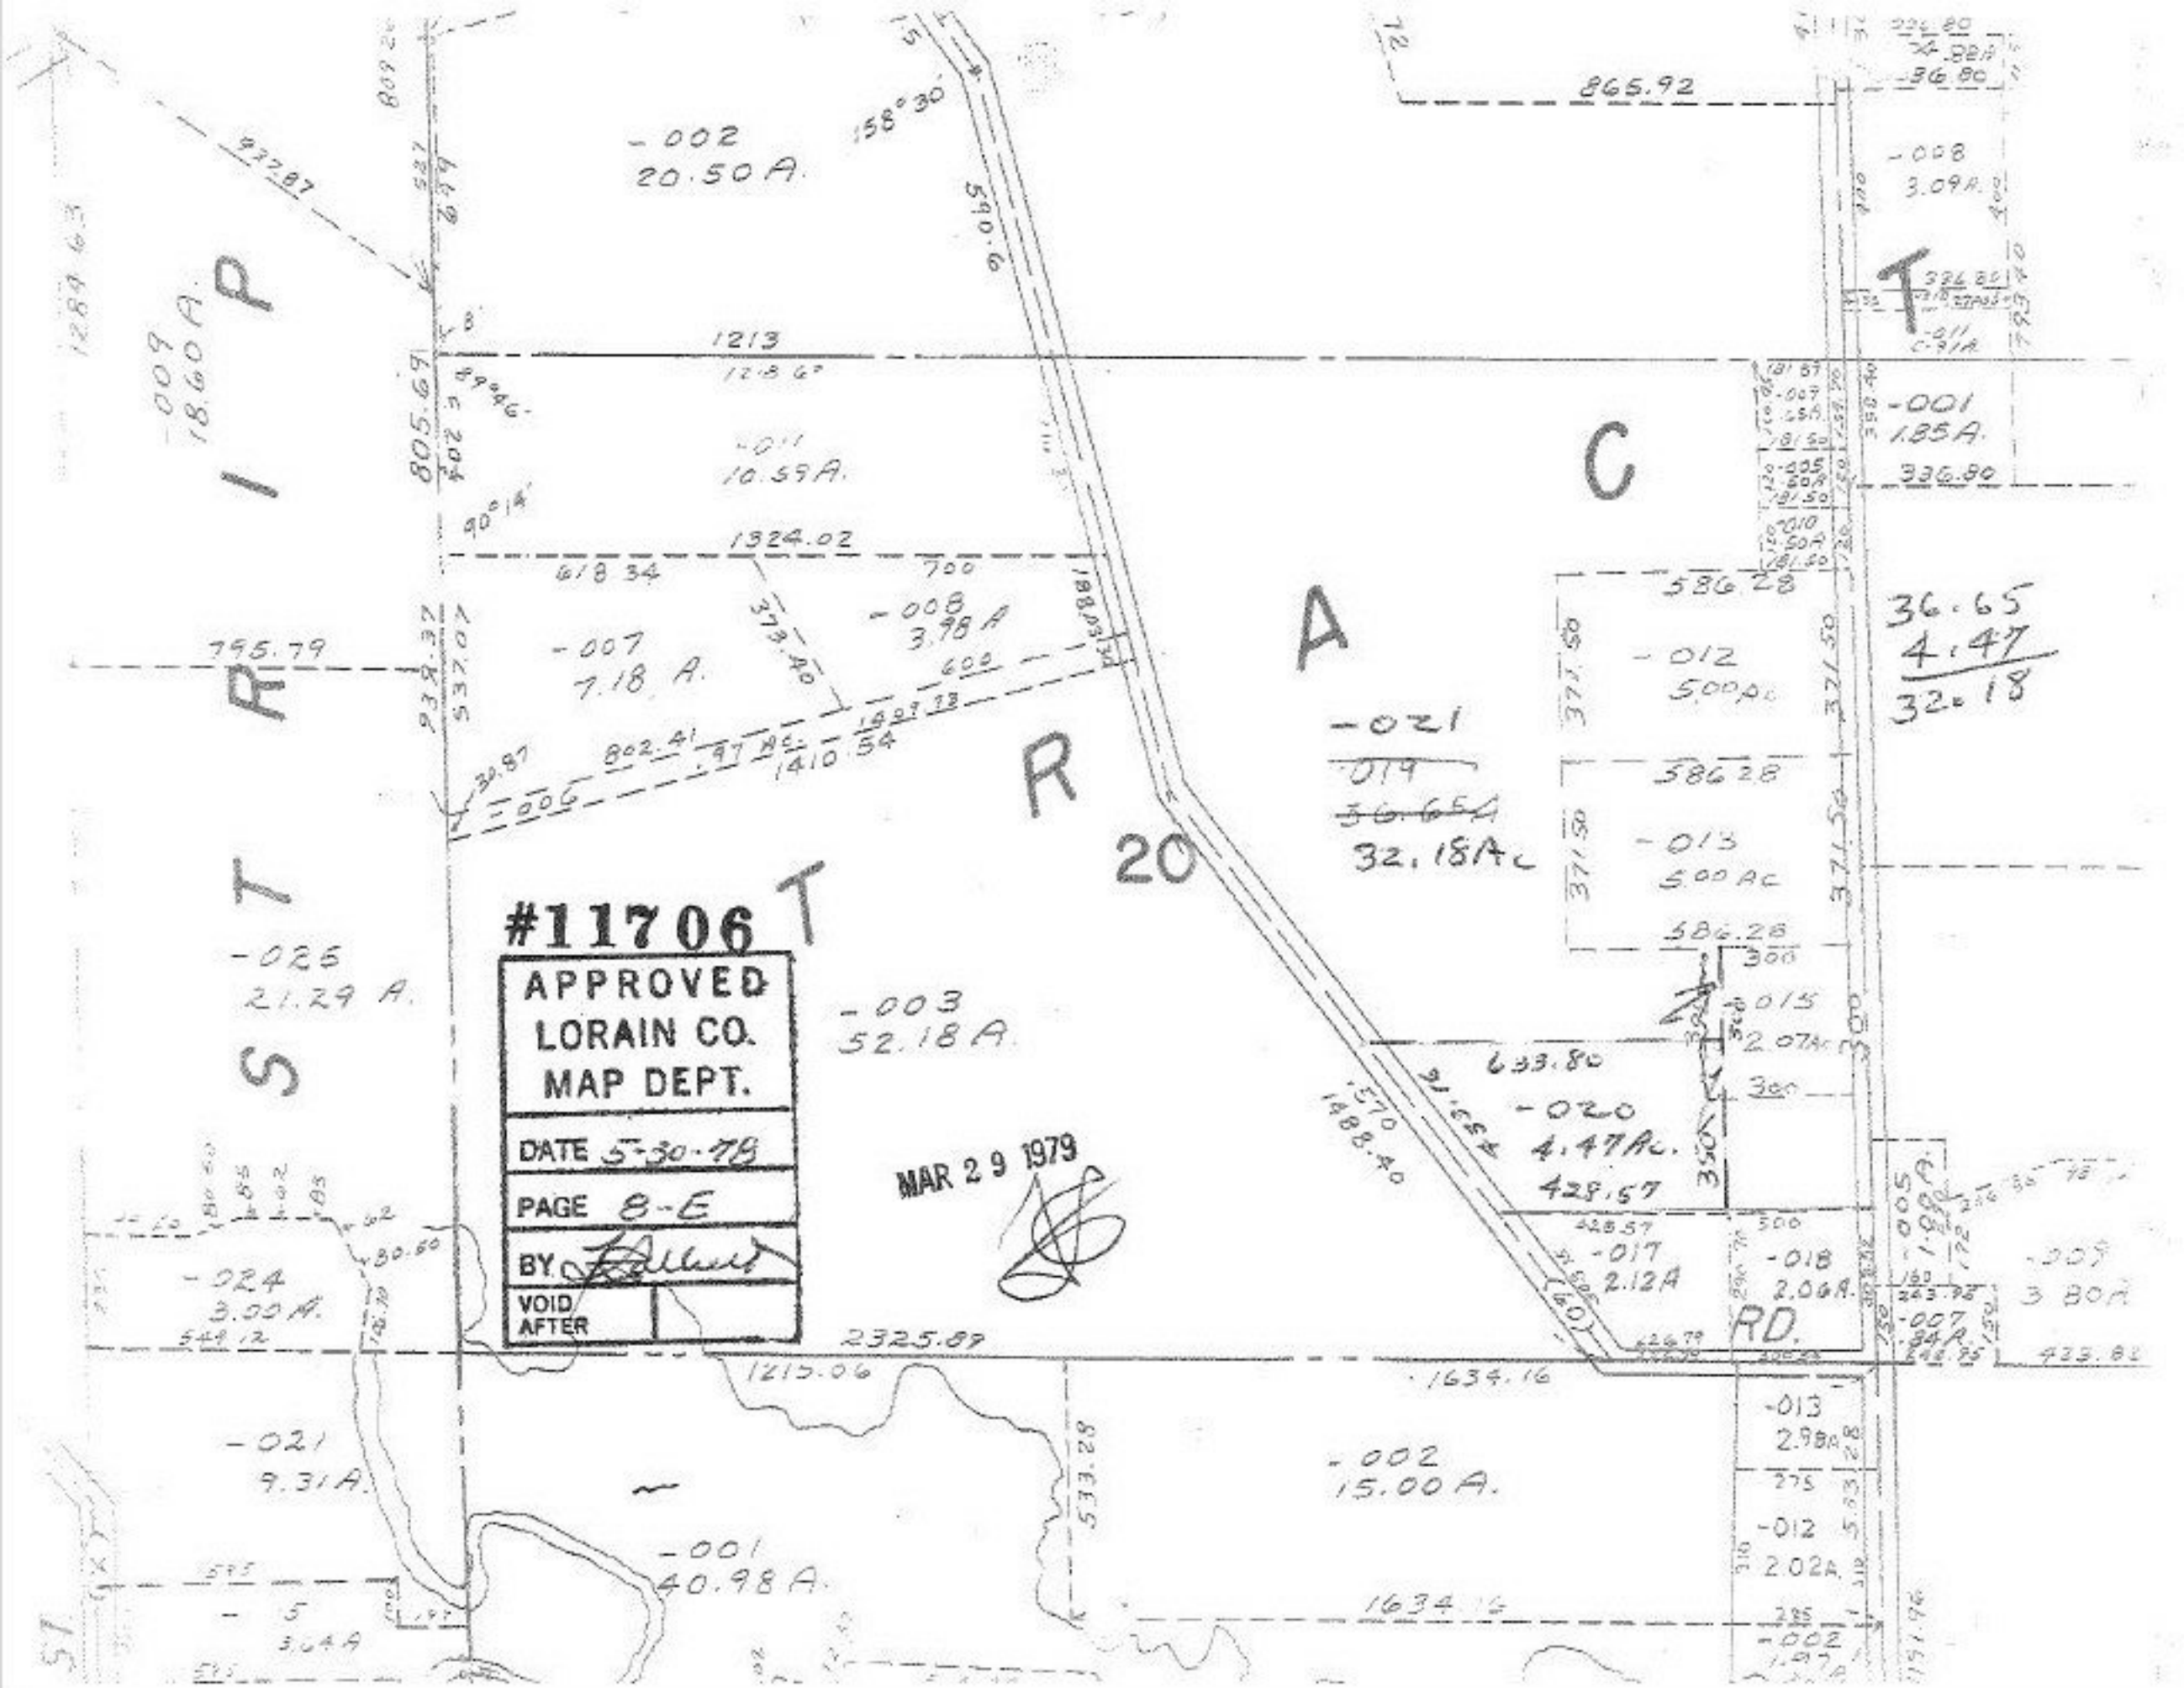

#11706

APPROVED
LORAIN CO.
MAP DEPT.

DATE 5-30-79

PAGE 8-E

BY

VOID AFTER

MAR 29 1979