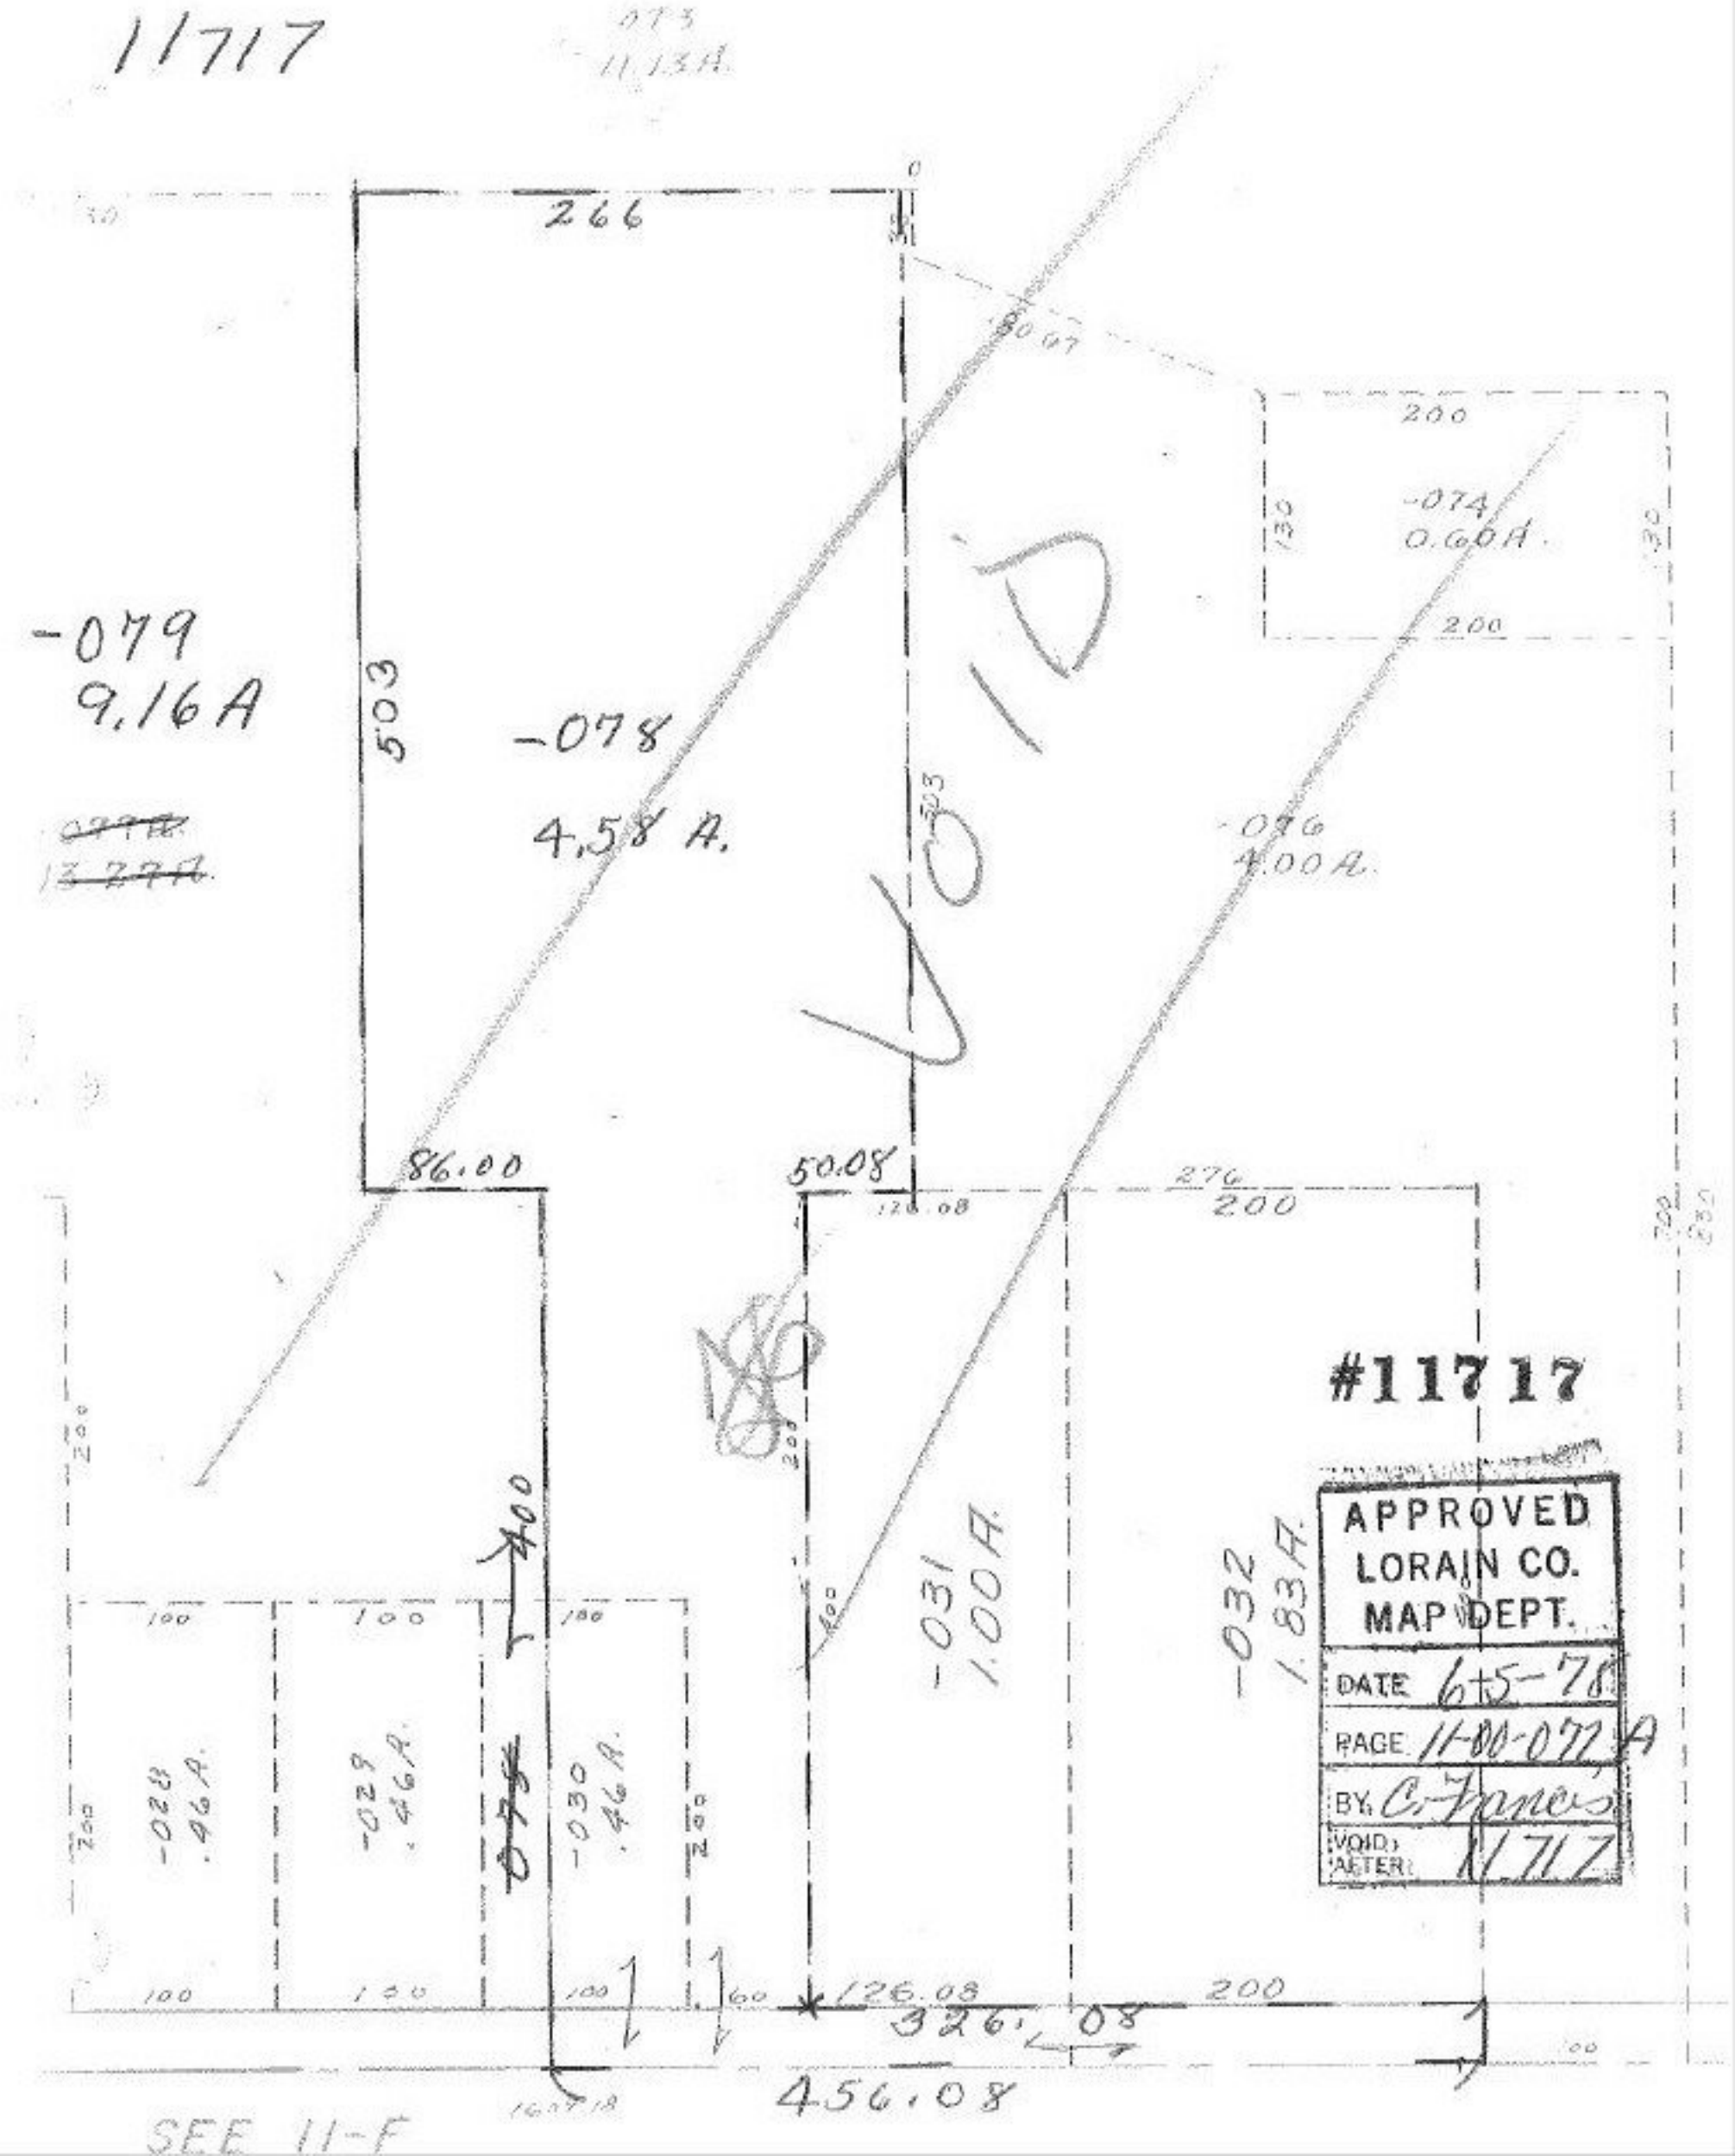
11717
073
11.13A.
266
-079
9.16A
503
-078
4.58 A.
VOID
-074
0.60A.
200
-076
4.00A.
86.00
50.08
276
200
126.08
400
-031
1.00A.
-032
1.83A.
-028
.46A.
-029
.46A.
-030
.46A.
100
60
126.08
200
326.08
456.08
SEE 11-F
#11717
APPROVED
LORAIN CO.
MAP DEPT.
DATE 6-5-78
PAGE 11-00-077 A
BY C. Francis
VOID AFTER 11717