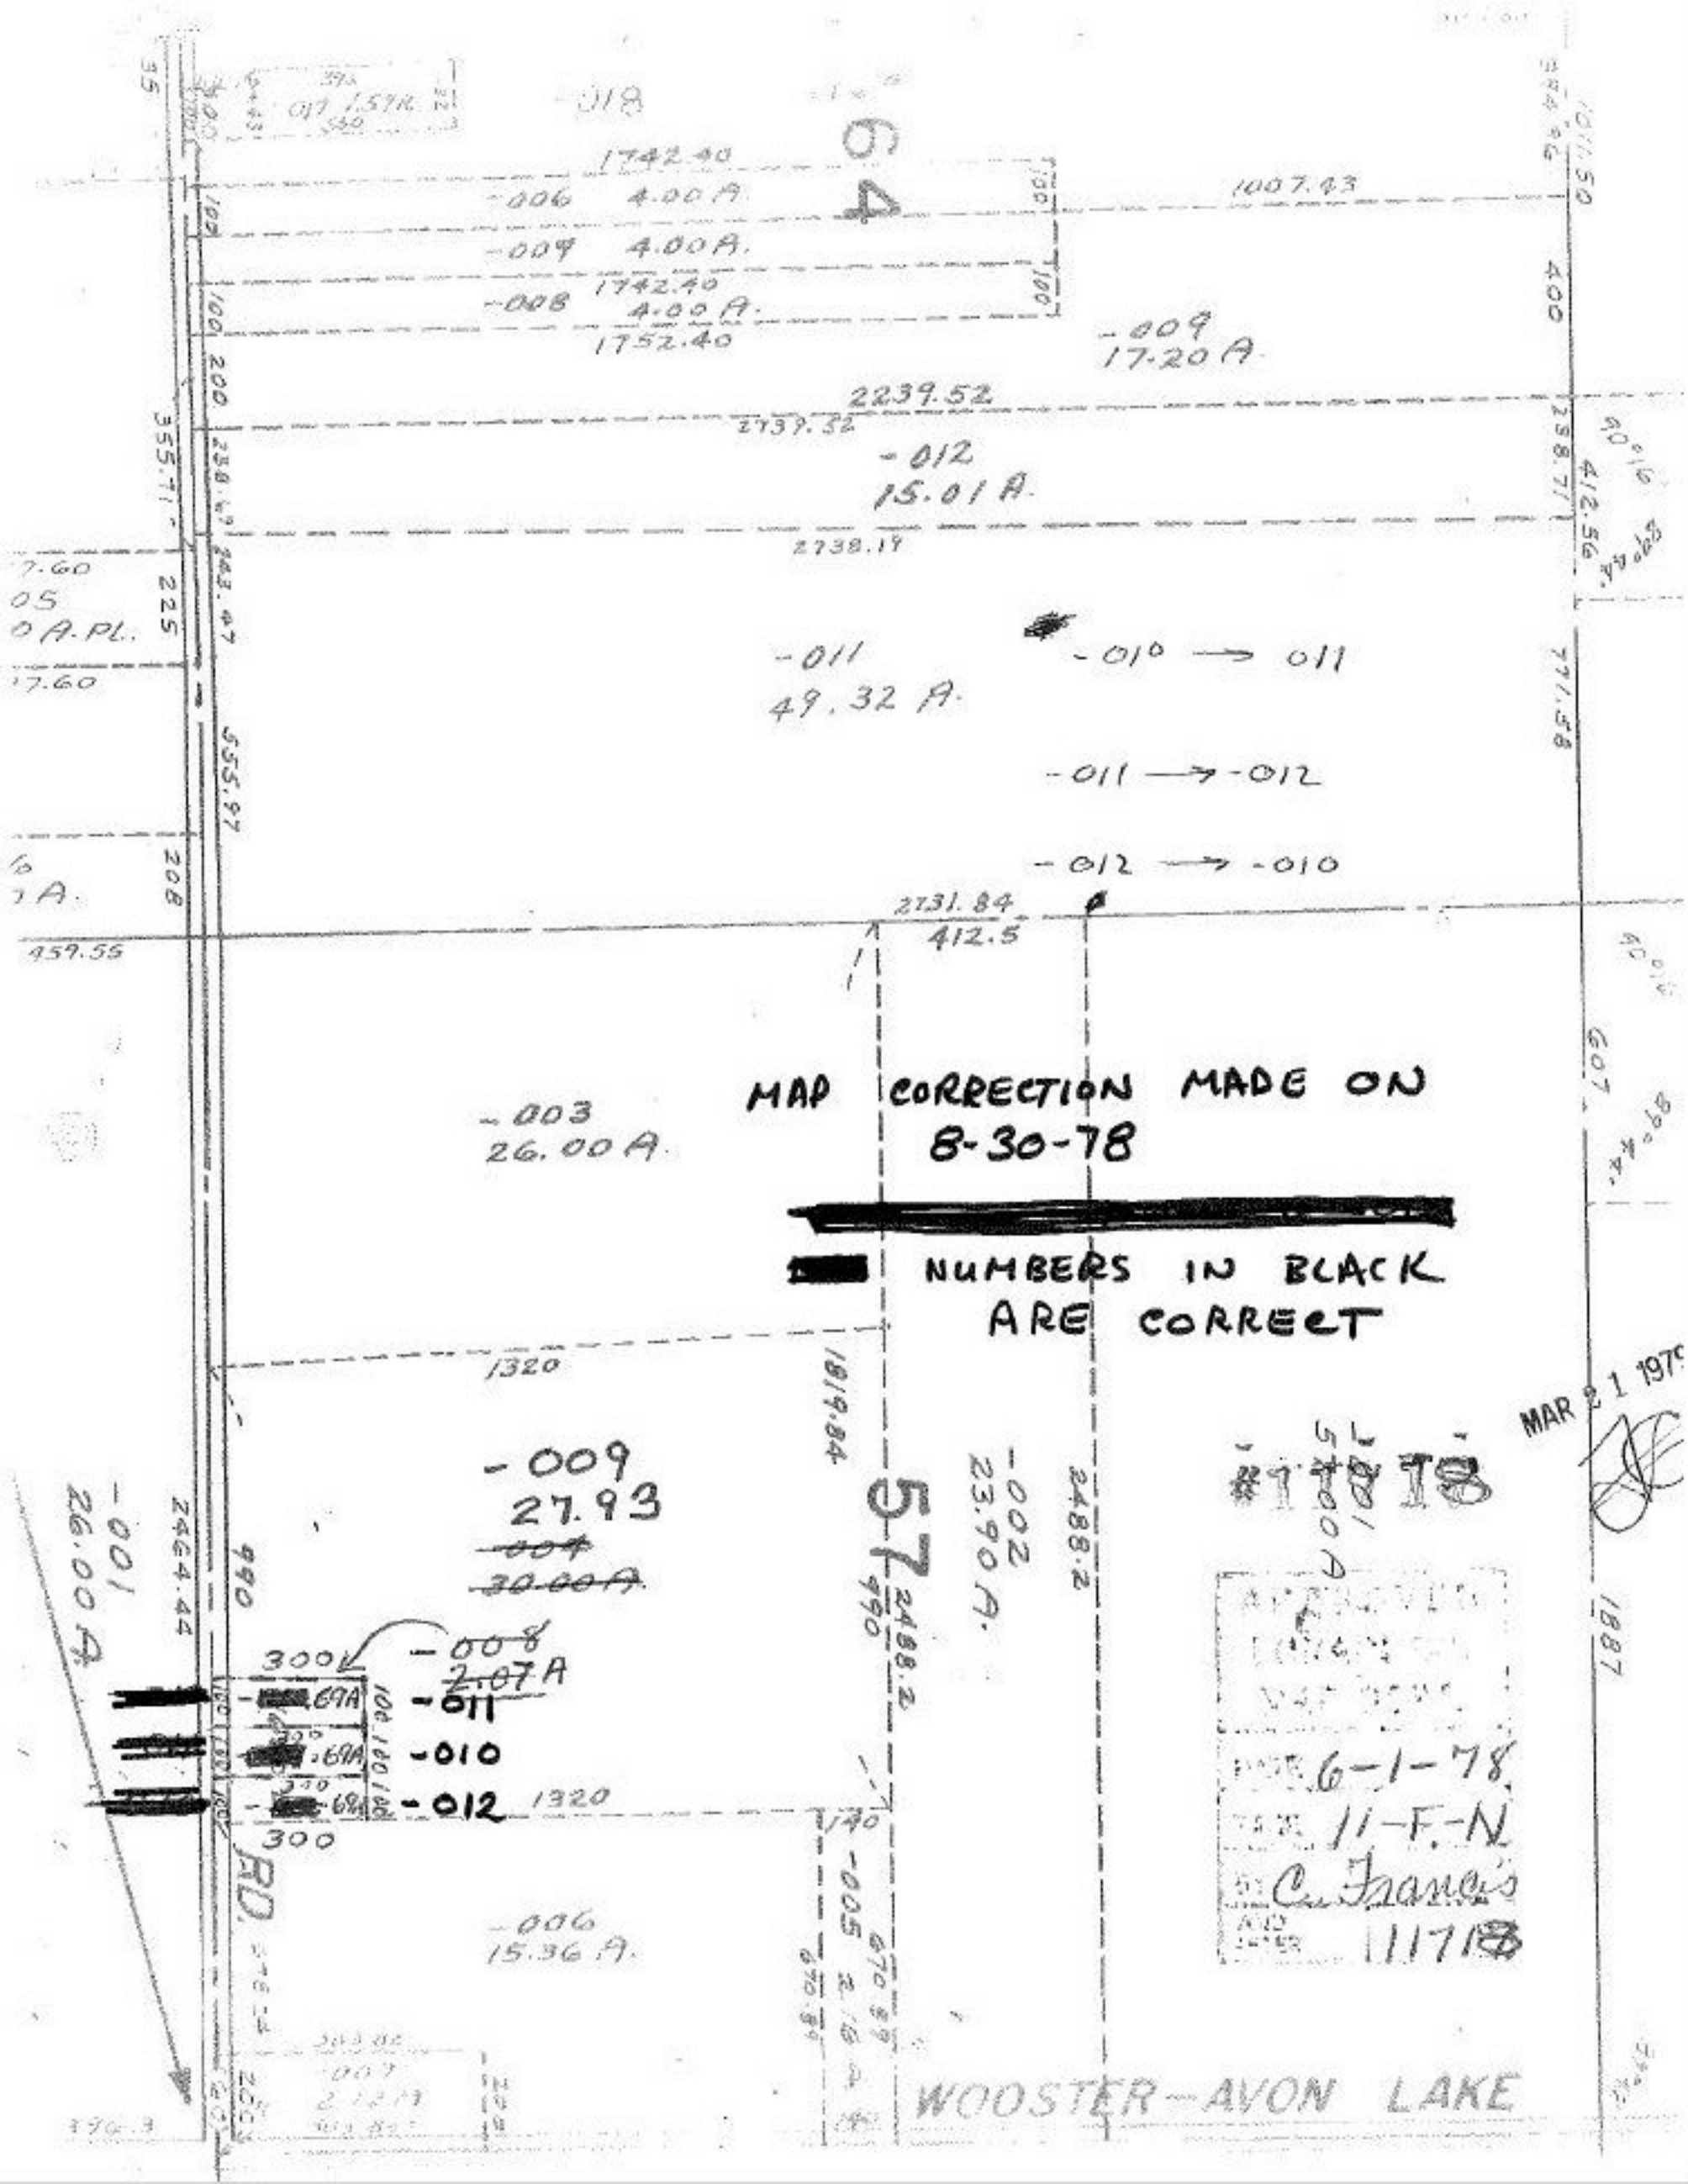

-018
64
1742.40
-006 4.00 A.
-009 4.00 A.
1742.40
-008 4.00 A.
1752.40
1007.43
-009
17.20 A.
2239.52
2739.52
-012
15.01 A.
2738.19
-011
49.32 A.
-010 → 011
-011 → -012
-012 → -010
2731.84
412.5
-003
26.00 A.
MAP CORRECTION MADE ON
8-30-78
[redacted]
[redacted] NUMBERS IN BLACK
ARE CORRECT
1320
-009
27.93
~~-004~~
~~30.00 A.~~
57
-002
23.90 A.
2488.2
#11718
MAR 21 1979
-001
26.00 A.
2464.44
990
300
-008
~~2.07~~ A
[redacted] -011
[redacted] -010
[redacted] -012
1320
300
-006
15.36 A.
-005
WOOSTER-AVON LAKE
6-1-78
11-F-N
C. Francis
11718