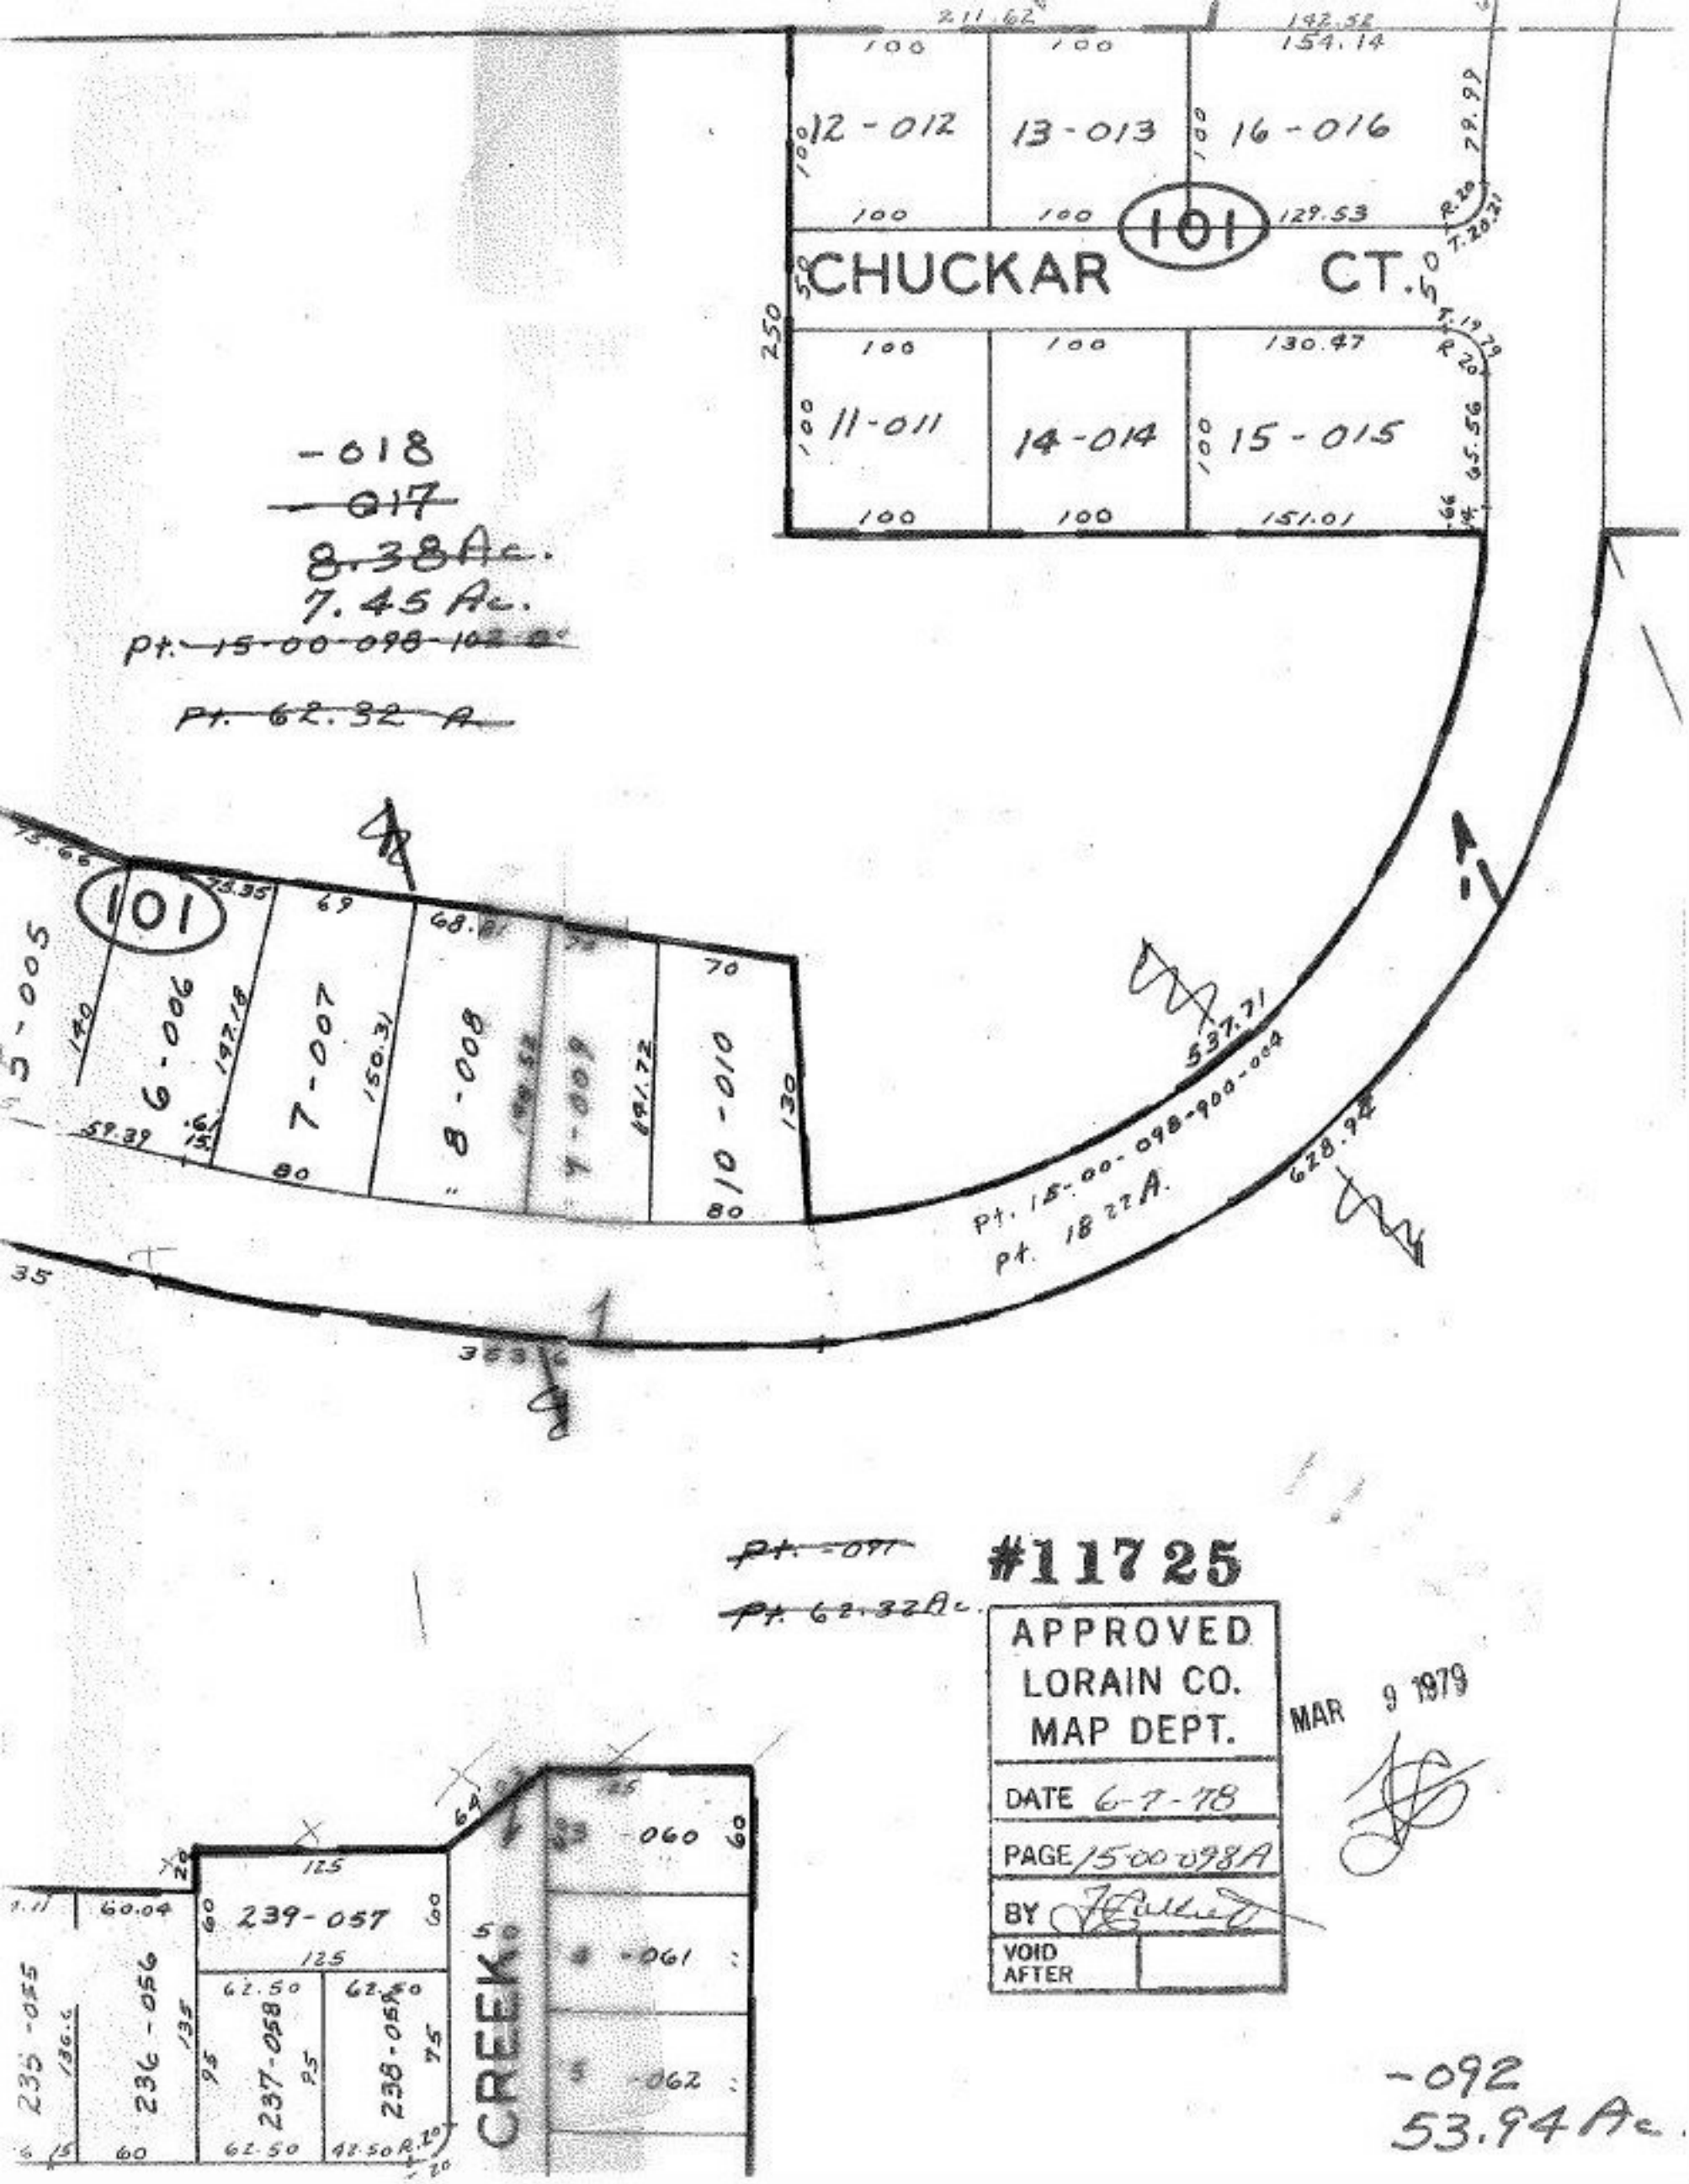

~~Pt. -097~~

~~Pt. 62.32 Ac.~~

#11725

APPROVED
LORAIN CO.
MAP DEPT.
MAR 9 1979

DATE 6-7-78

PAGE 15-00-098A

BY