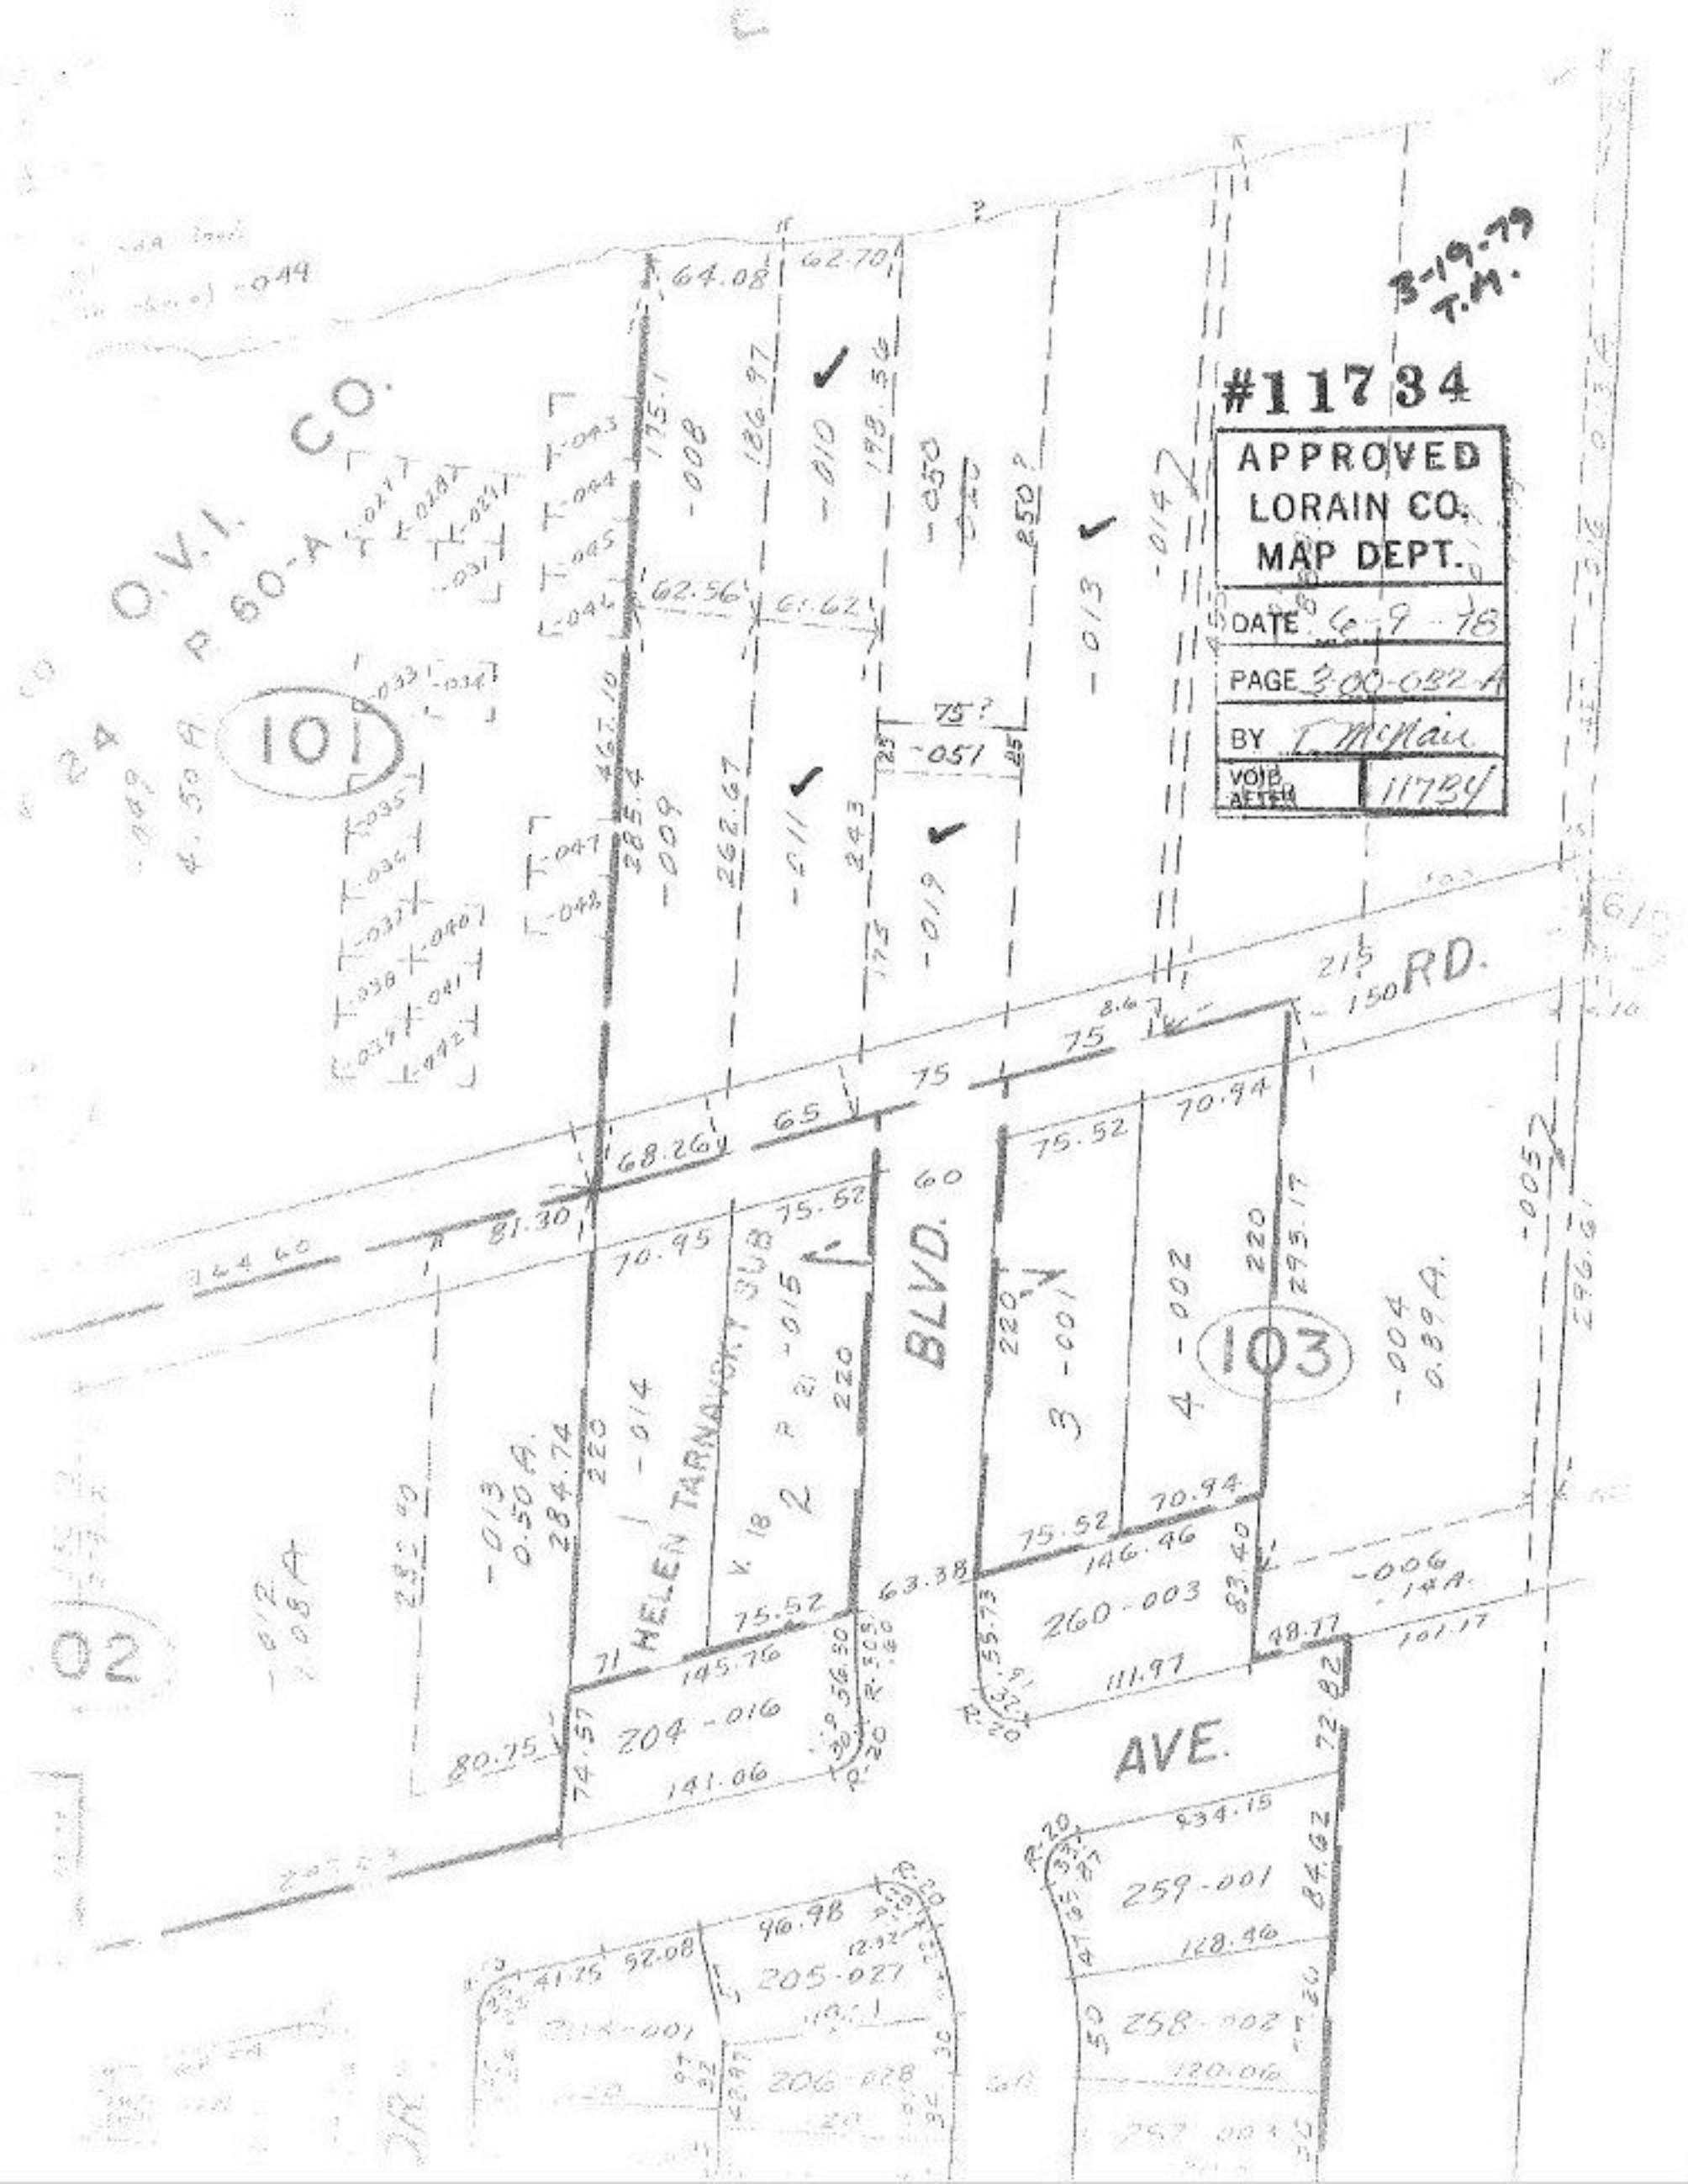

3-19-79
T.M.
#11734
APPROVED
LORAIN CO.
MAP DEPT.
DATE 6-9-78
PAGE 3-00-032-A
BY T. McNair
VOID AFTER 11734
O.V.I. CO.
P. 60-A
101
102
103
BLVD.
AVE.
RD.
HELEN TARNAVSKY SUB
204-016
260-003
259-001
258-002
205-027
206-028