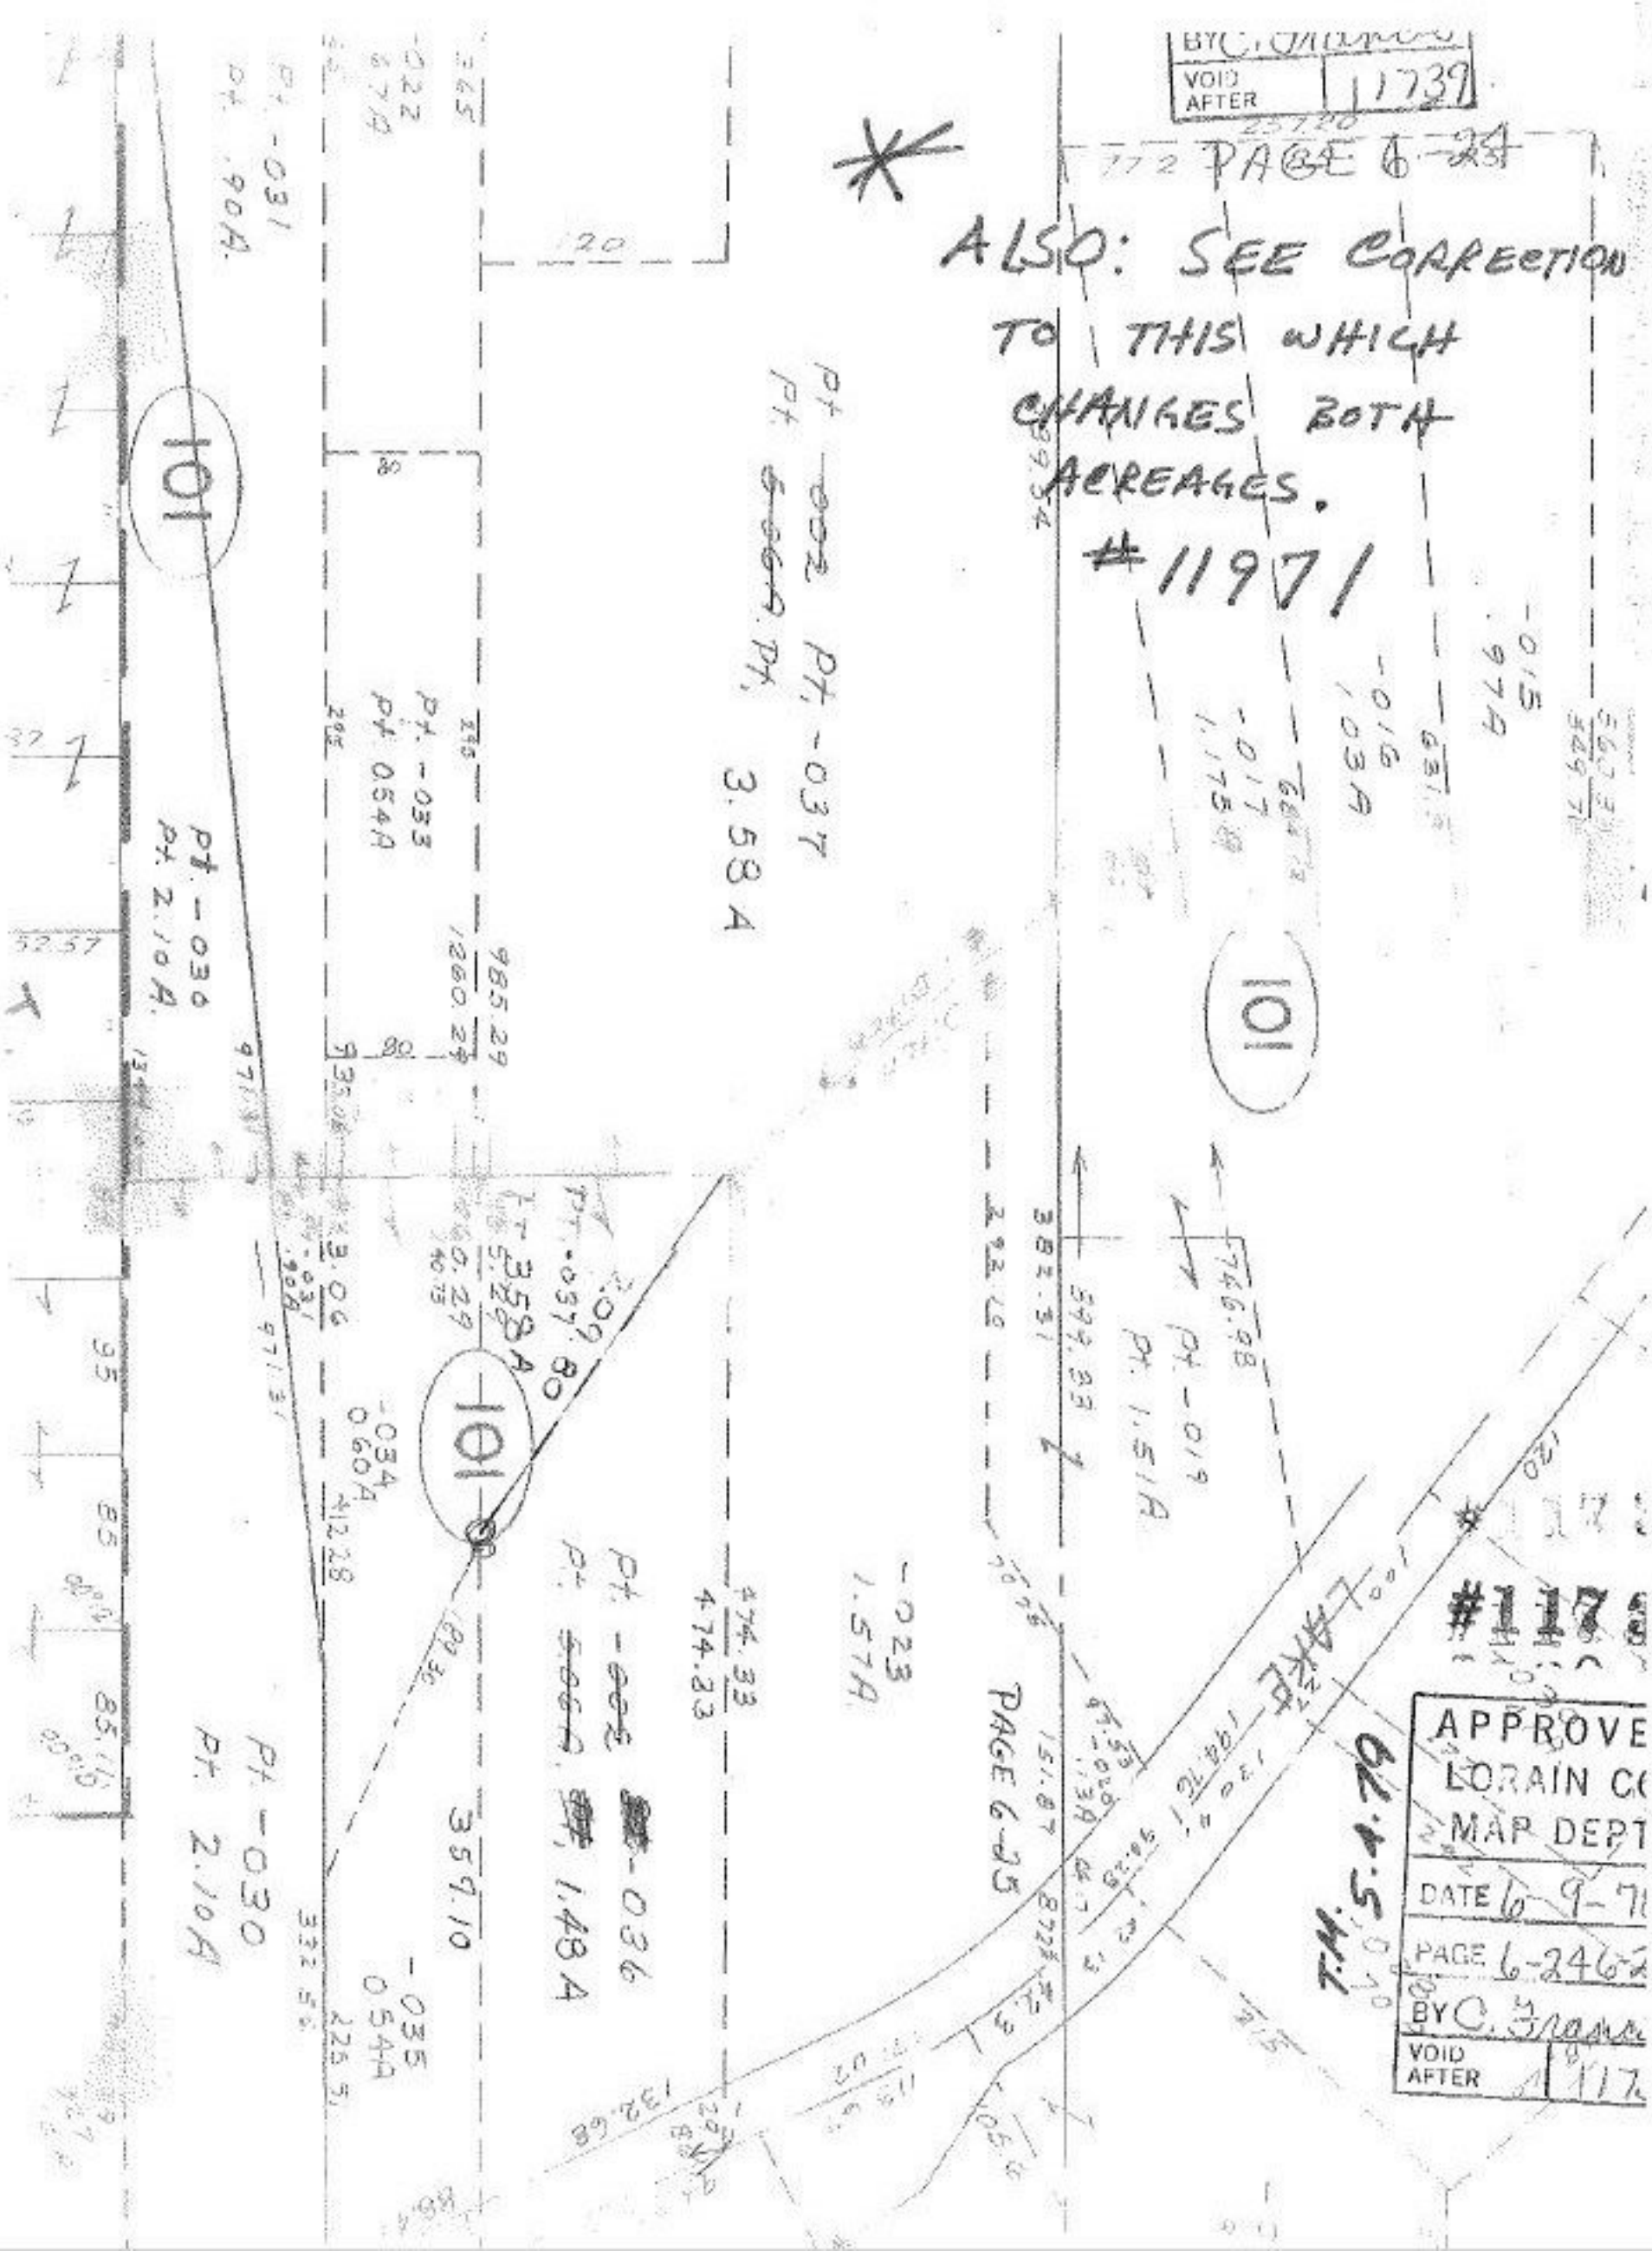
BY C. Franco
VOID AFTER 11739
PAGE 6-24
ALSO: SEE CORRECTION TO THIS WHICH CHANGES BOTH ACREAGES.
#11971
Pt. -037
3.58 A
Pt. -033
Pt. 054A
Pt. -030
Pt. 2.10A
Pt. -031
Pt. .90A
Pt. -019
Pt. 1.51A
Pt. -036
1.48A
Pt. -035
054A
Pt. -030
Pt. 2.10A
PAGE 6-25
LAKE
T.M. 5.4.79
#117
APPROVE
LORAIN C
MAP DEPT
DATE 6-9-7
PAGE 6-246
BY C. Franco
VOID AFTER 117