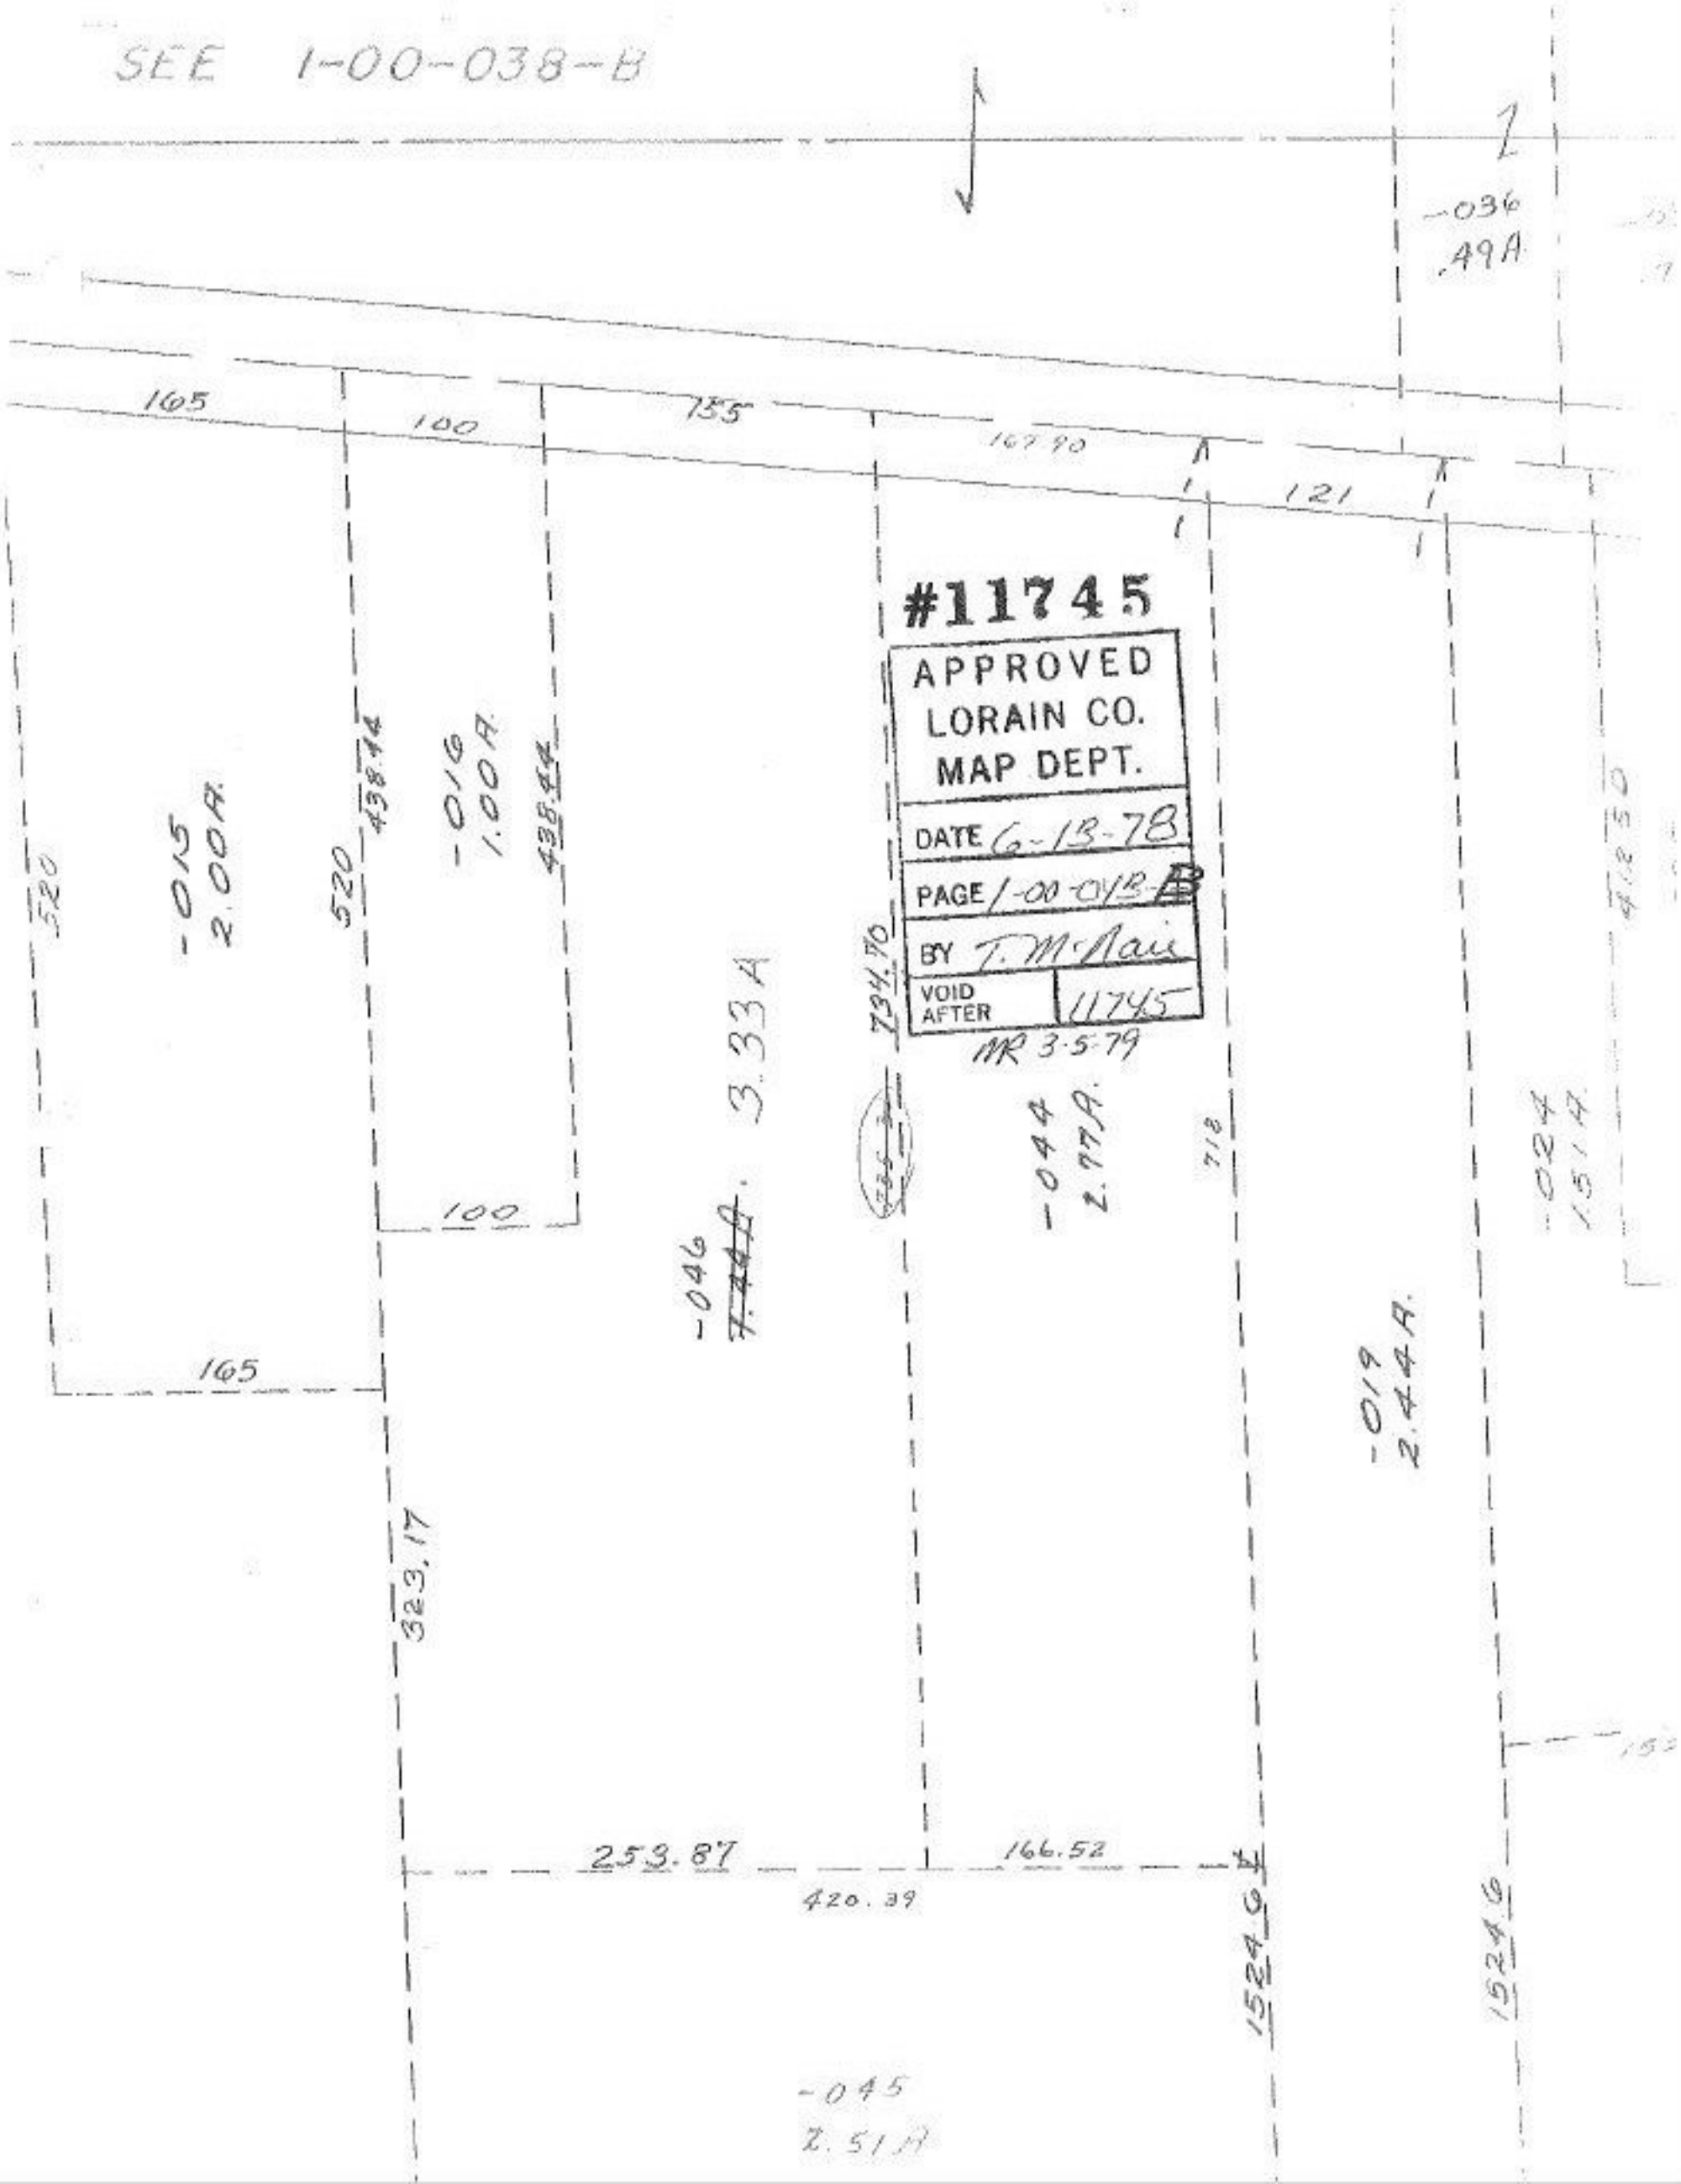
SEE 1-00-038-B
-036
.49A
165
100
155
167.90
121
#11745
APPROVED
LORAIN CO.
MAP DEPT.
DATE 6-13-78
PAGE 1-00-043-B
BY T. McNair
VOID AFTER 11745
MR 3-5-79
520
-015
2.00A
520
438.44
-016
1.00A
438.44
3.33A
734.70
-044
2.77A
718
-024
1.51A
100
-046
165
-019
2.44A
323.17
253.87
166.52
420.39
1524.6
1524.6
-045
2.51A