11753

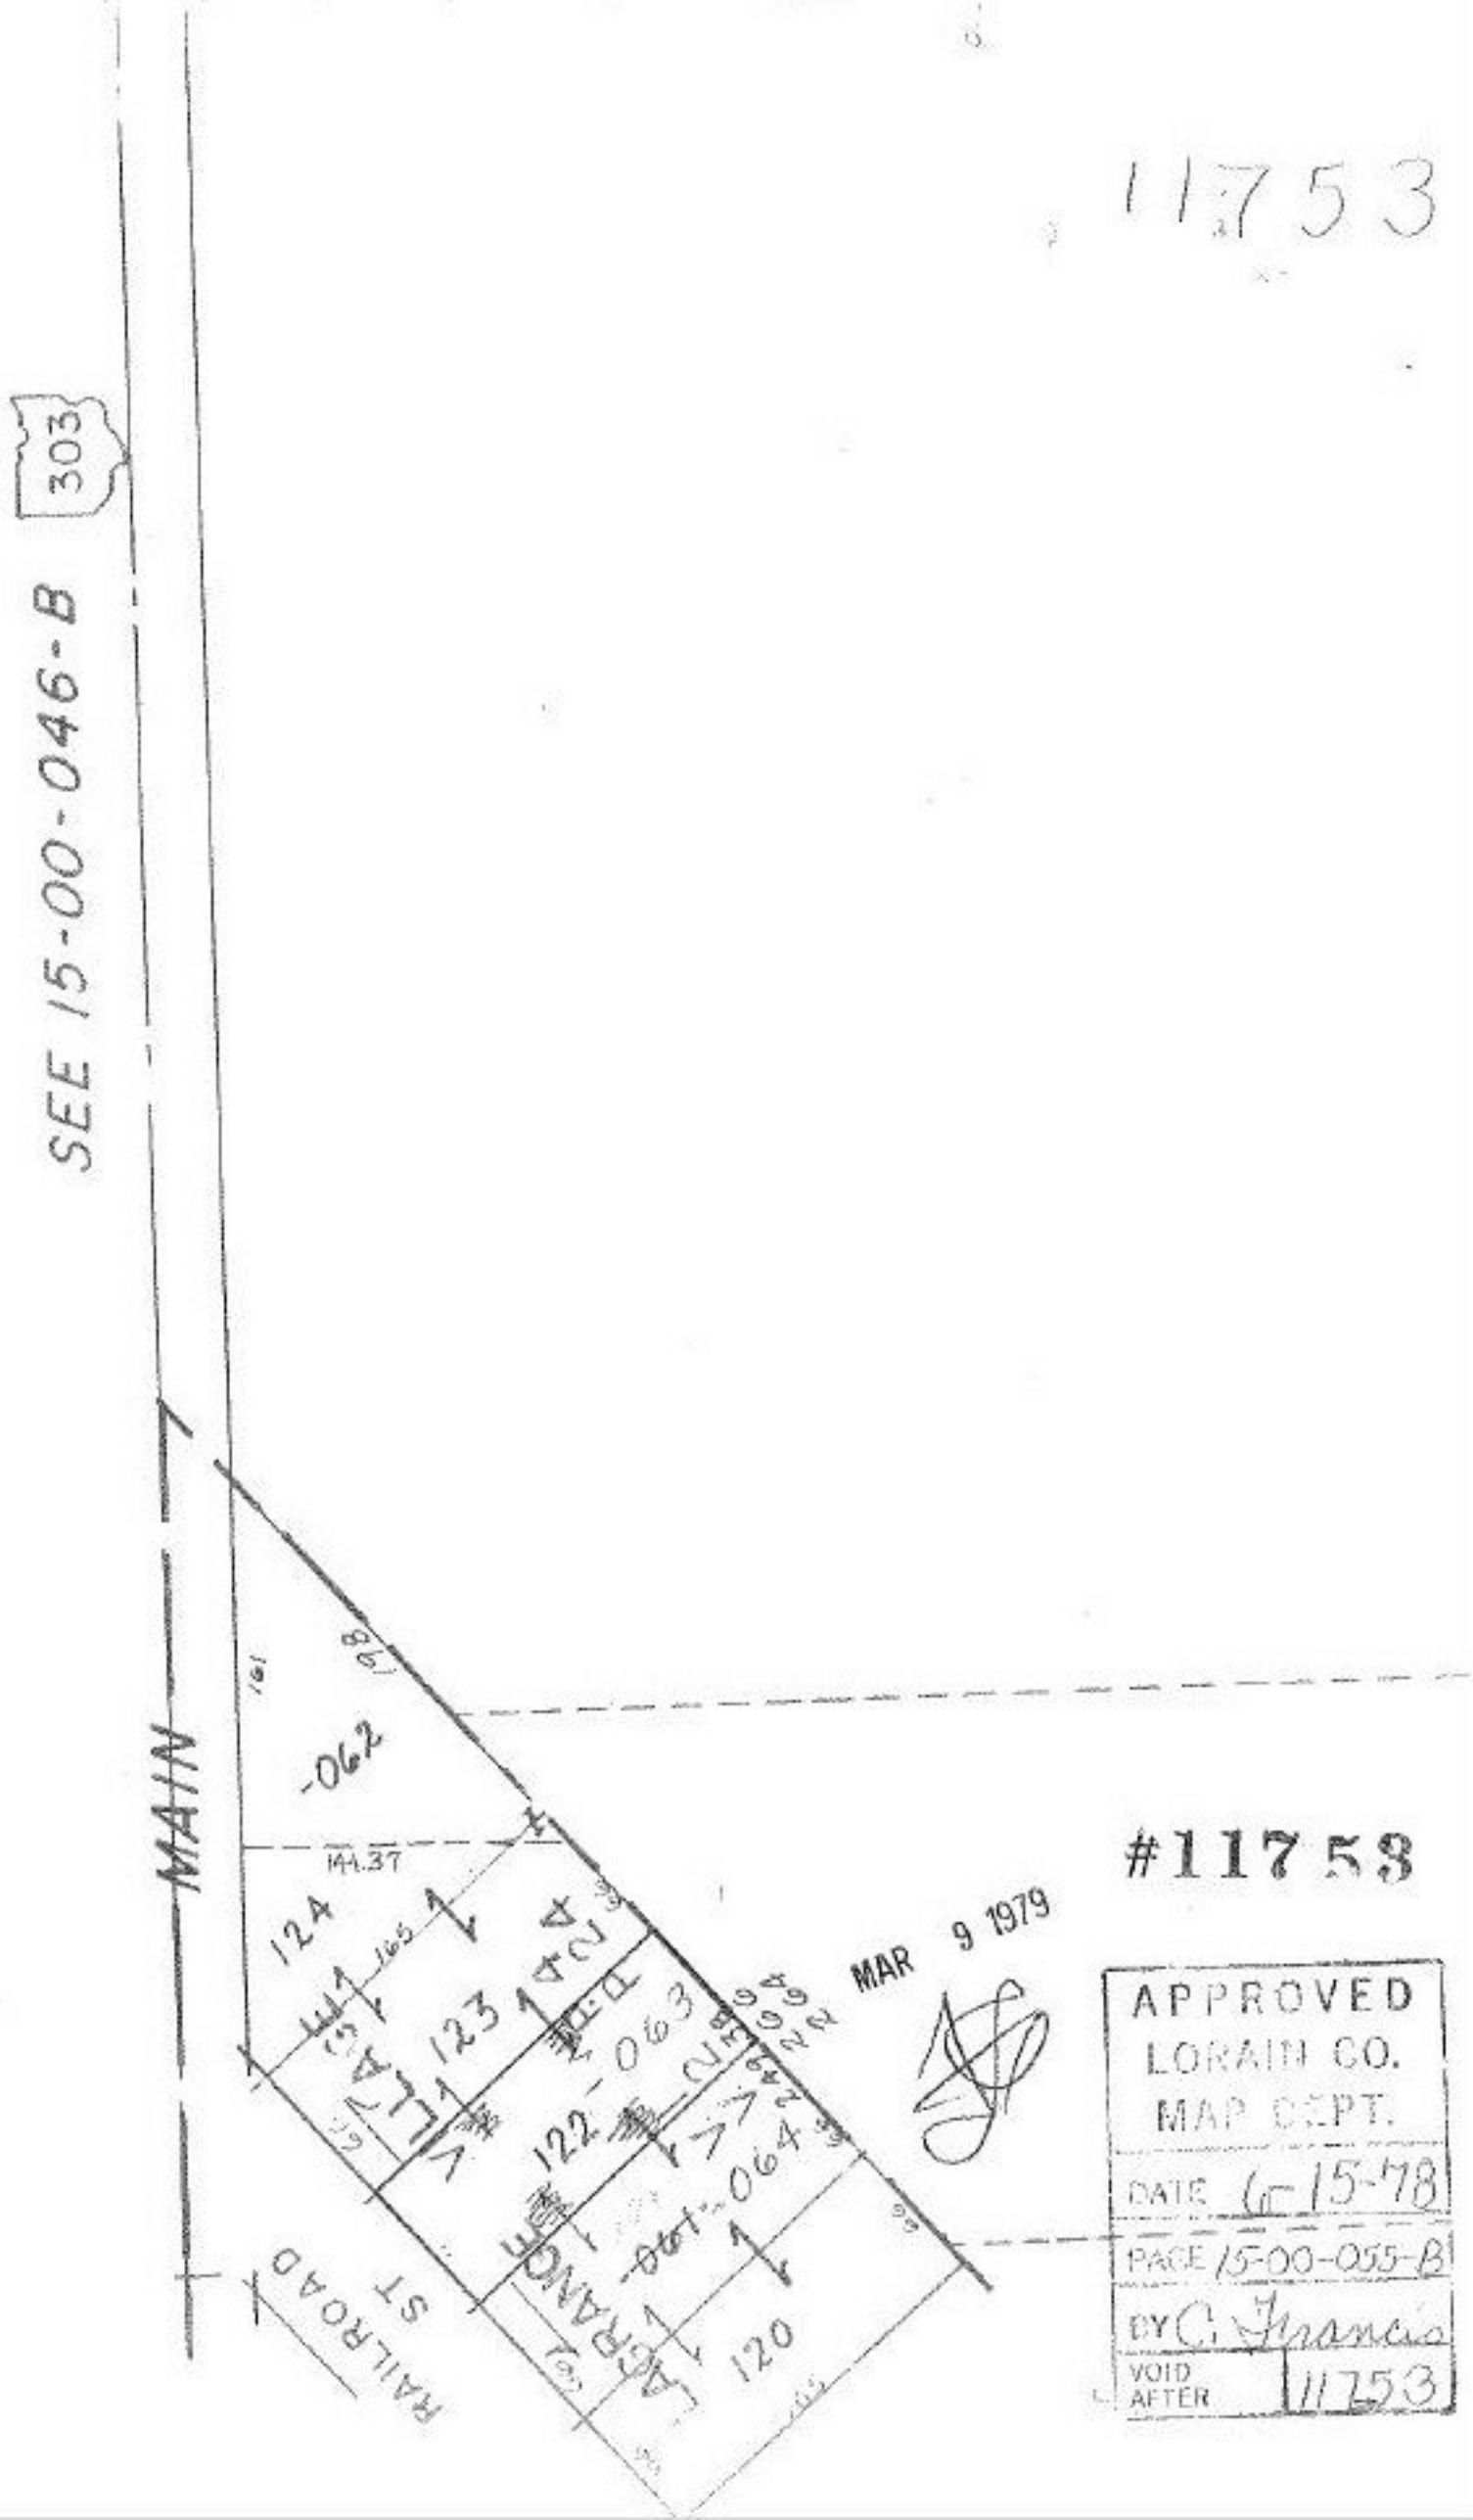

#11753

MAR 9 1979

APPROVED
LORAIN CO.
MAP DEPT.
DATE 6-15-78
PAGE 15-00-055-B
BY C. Francis
VOID AFTER 11753