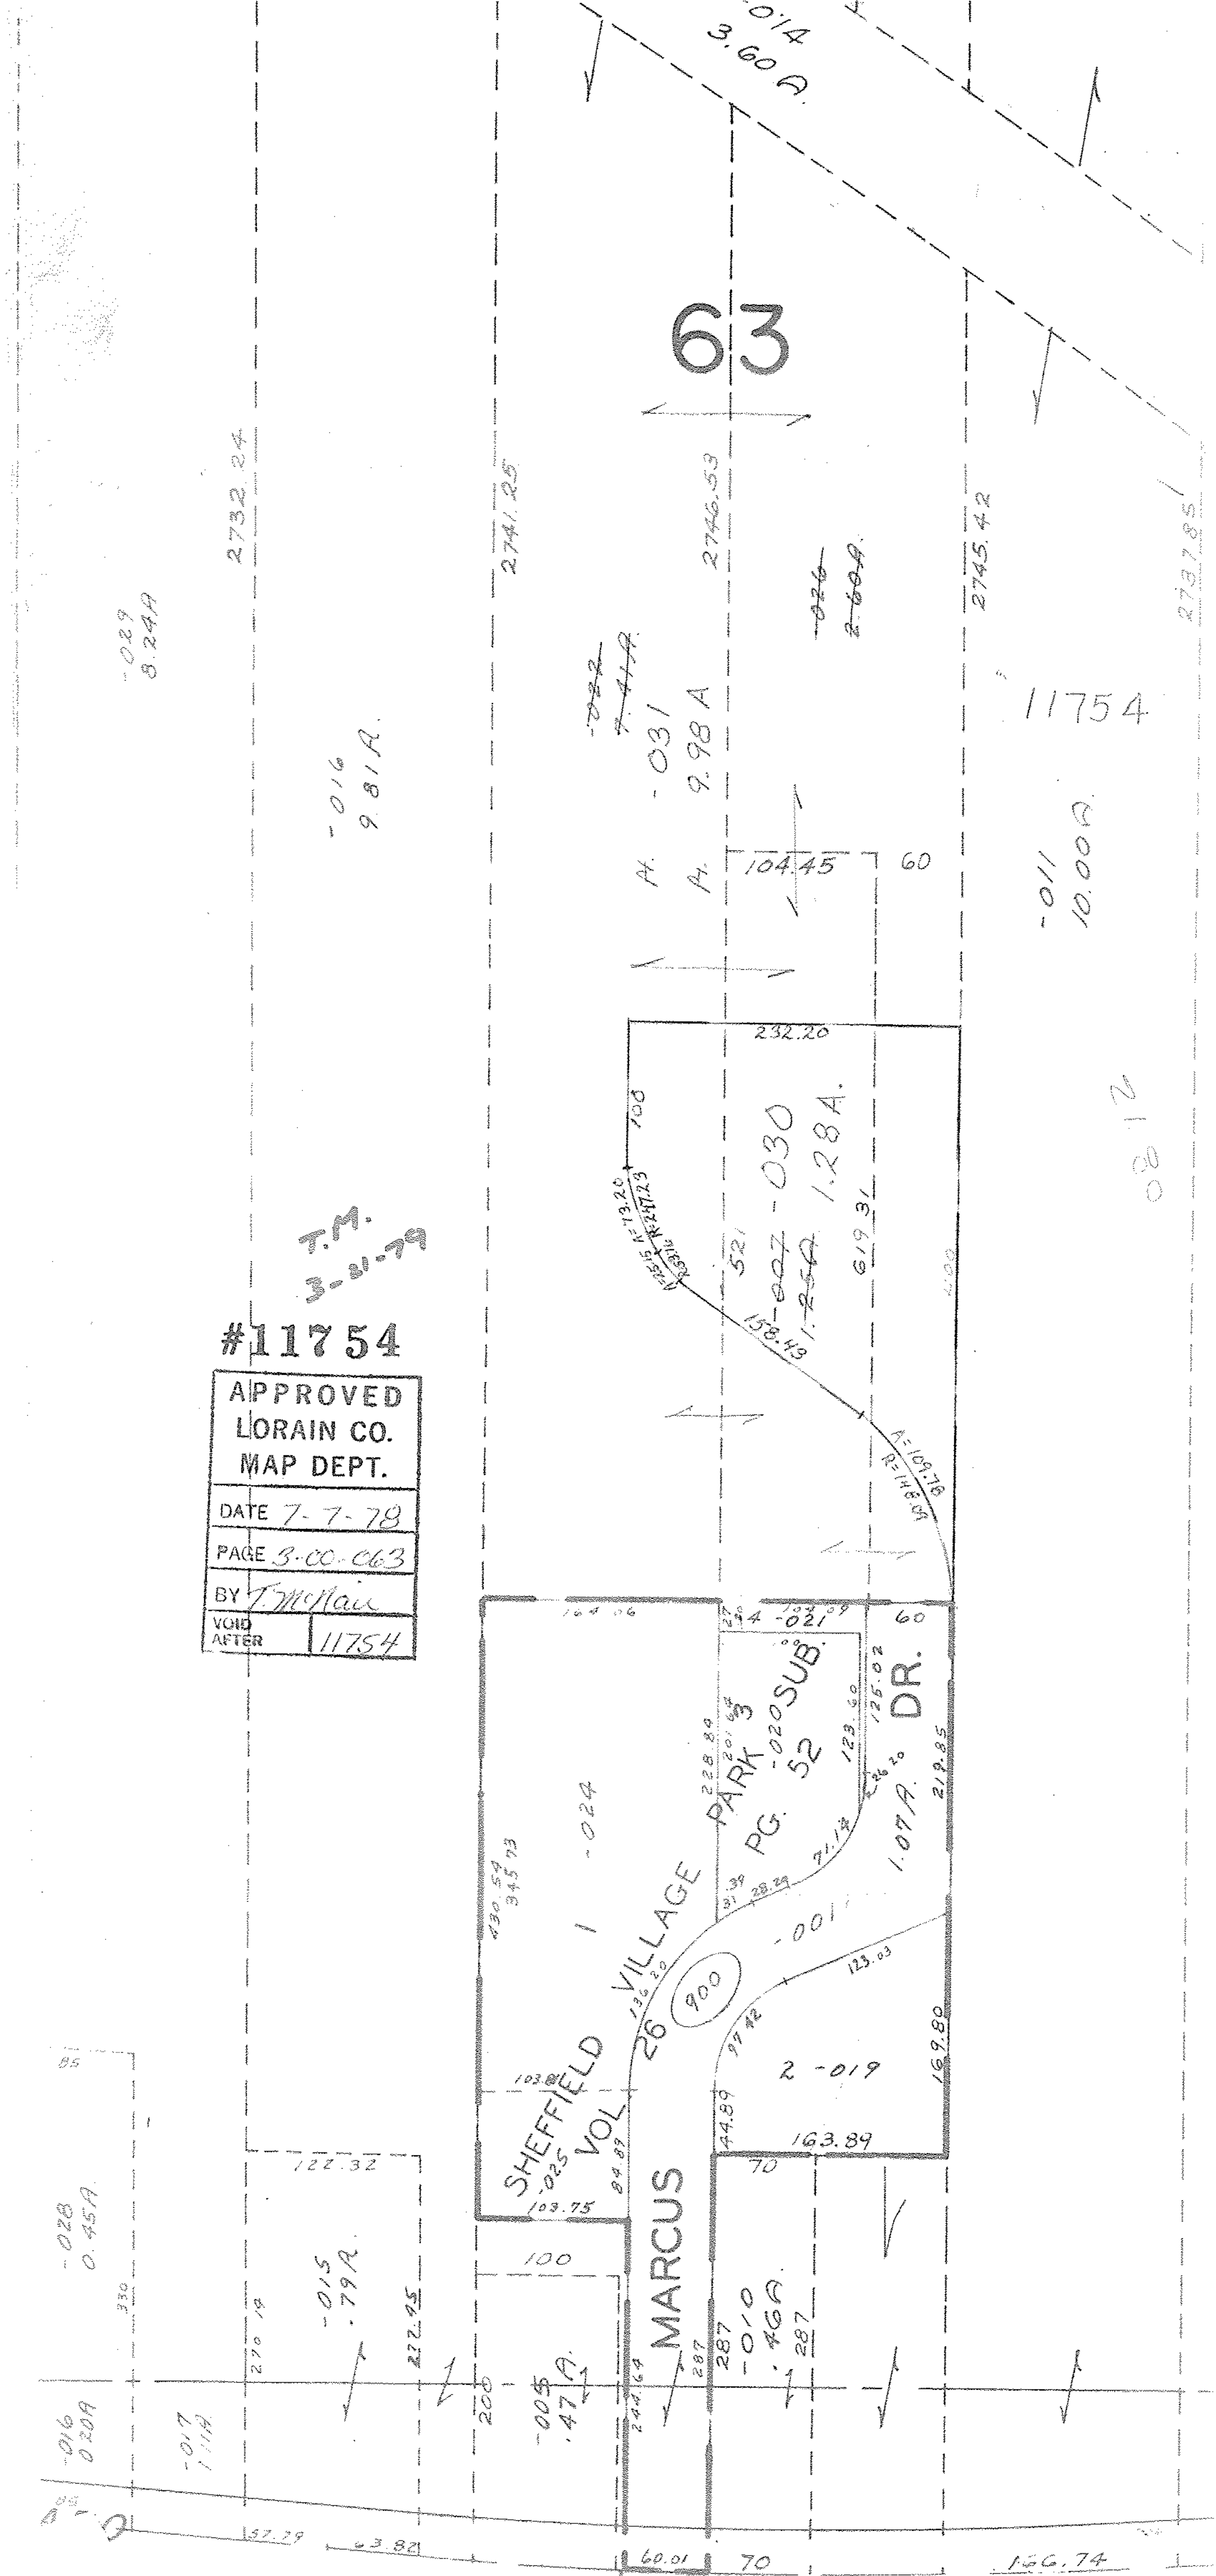
63
11754
-031
9.98 A
-030
1.28A.
-011
10.000 A.
-016
9.81 A.
-029
8.244
-028
0.45A.
-015
.79A.
-005
.47A.
-017
1.19
-016
0.209
-010
.46A.
-024
1.07A.
-001
-025
-020 SUB.
PARK 3
PG. 52
VILLAGE
SHEFFIELD
VOL. 26
MARCUS
DR.
900
2 -019
1 -024
T.M.
3-21-79
#11754
APPROVED
LORAIN CO.
MAP DEPT.
DATE 7-7-78
PAGE 3-00-063
BY T McNair
VOID AFTER 11754
2732.24
2741.25
2746.53
2745.42
2737.85
232.20
104.45
60
619.31
158.43
R=148.31
A=109.78
104.06
125.02
123.60
219.85
169.80
163.89
122.32
100
200
287
272.45
270.19
330
85
70
60.01
63.82
137.29
