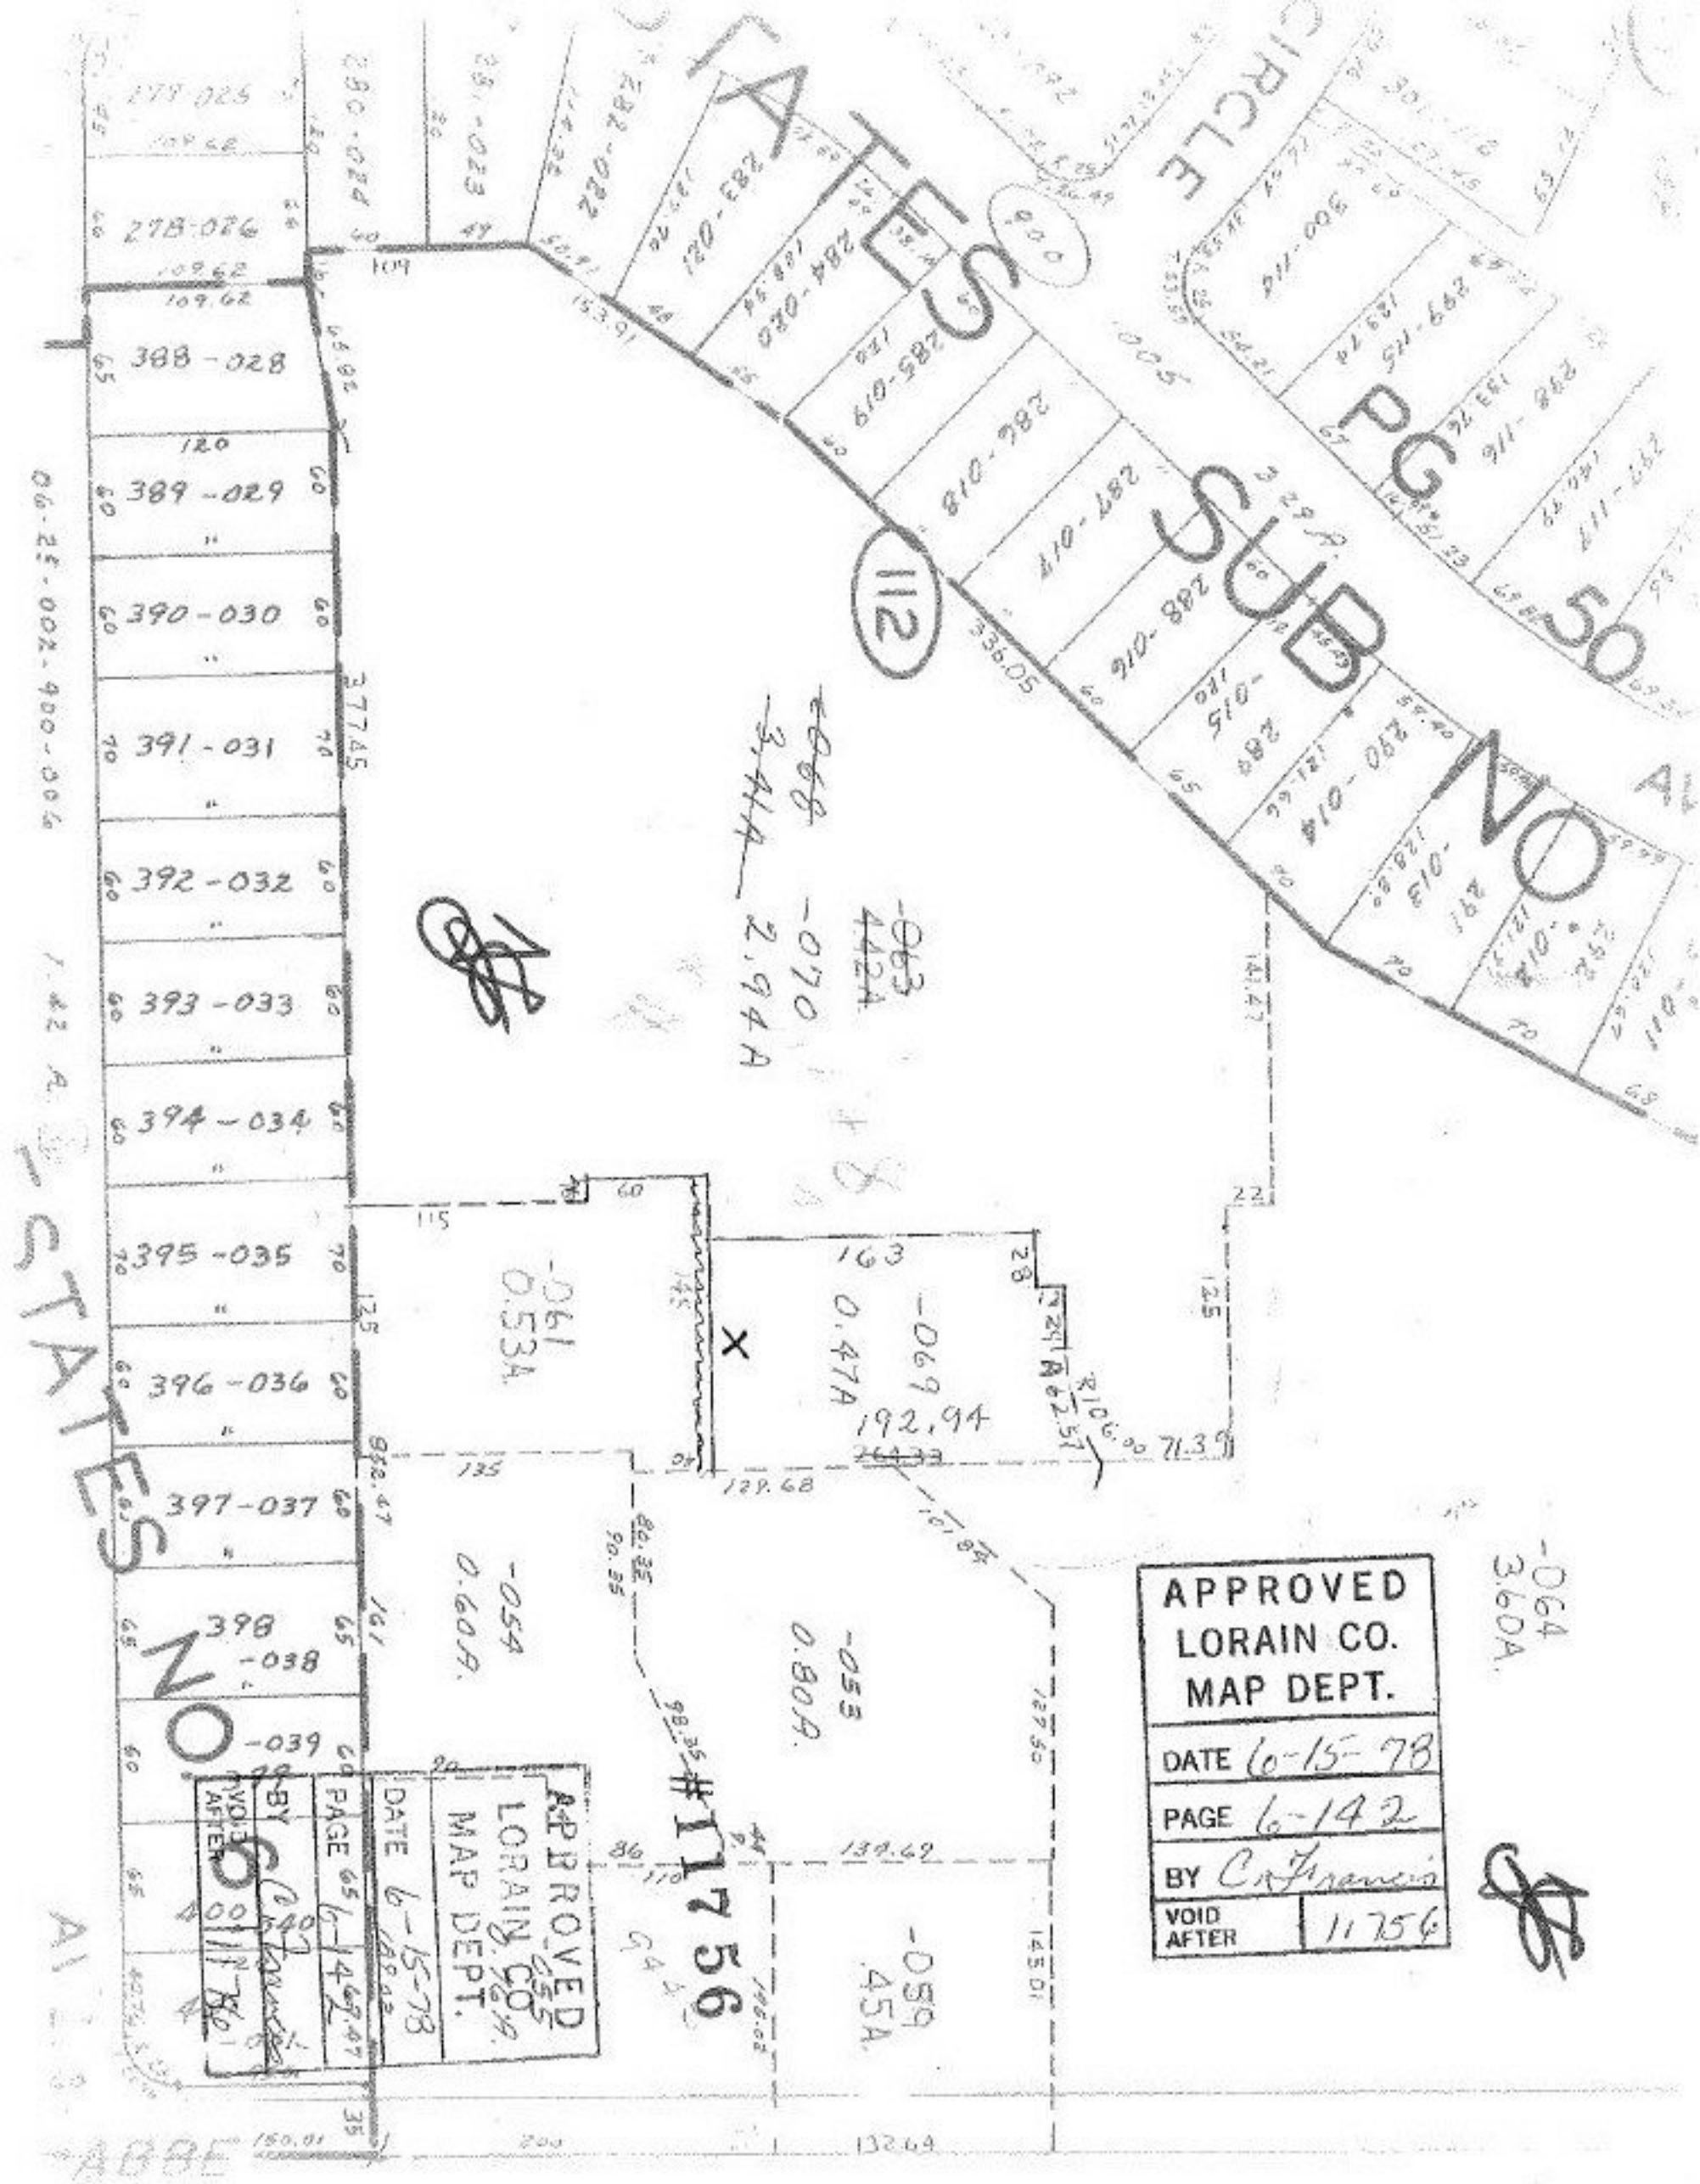

STATES SUB NO 50
PG
CIRCLE
112
-070
2.94A
-061
0.53A
-069
0.47A
192.94
-054
0.60A
-053
0.80A
-059
.45A
-064
3.60A
APPROVED
LORAIN CO.
MAP DEPT.
DATE 6-15-78
PAGE 6-142
BY C. Francis
VOID AFTER 11756
#11756