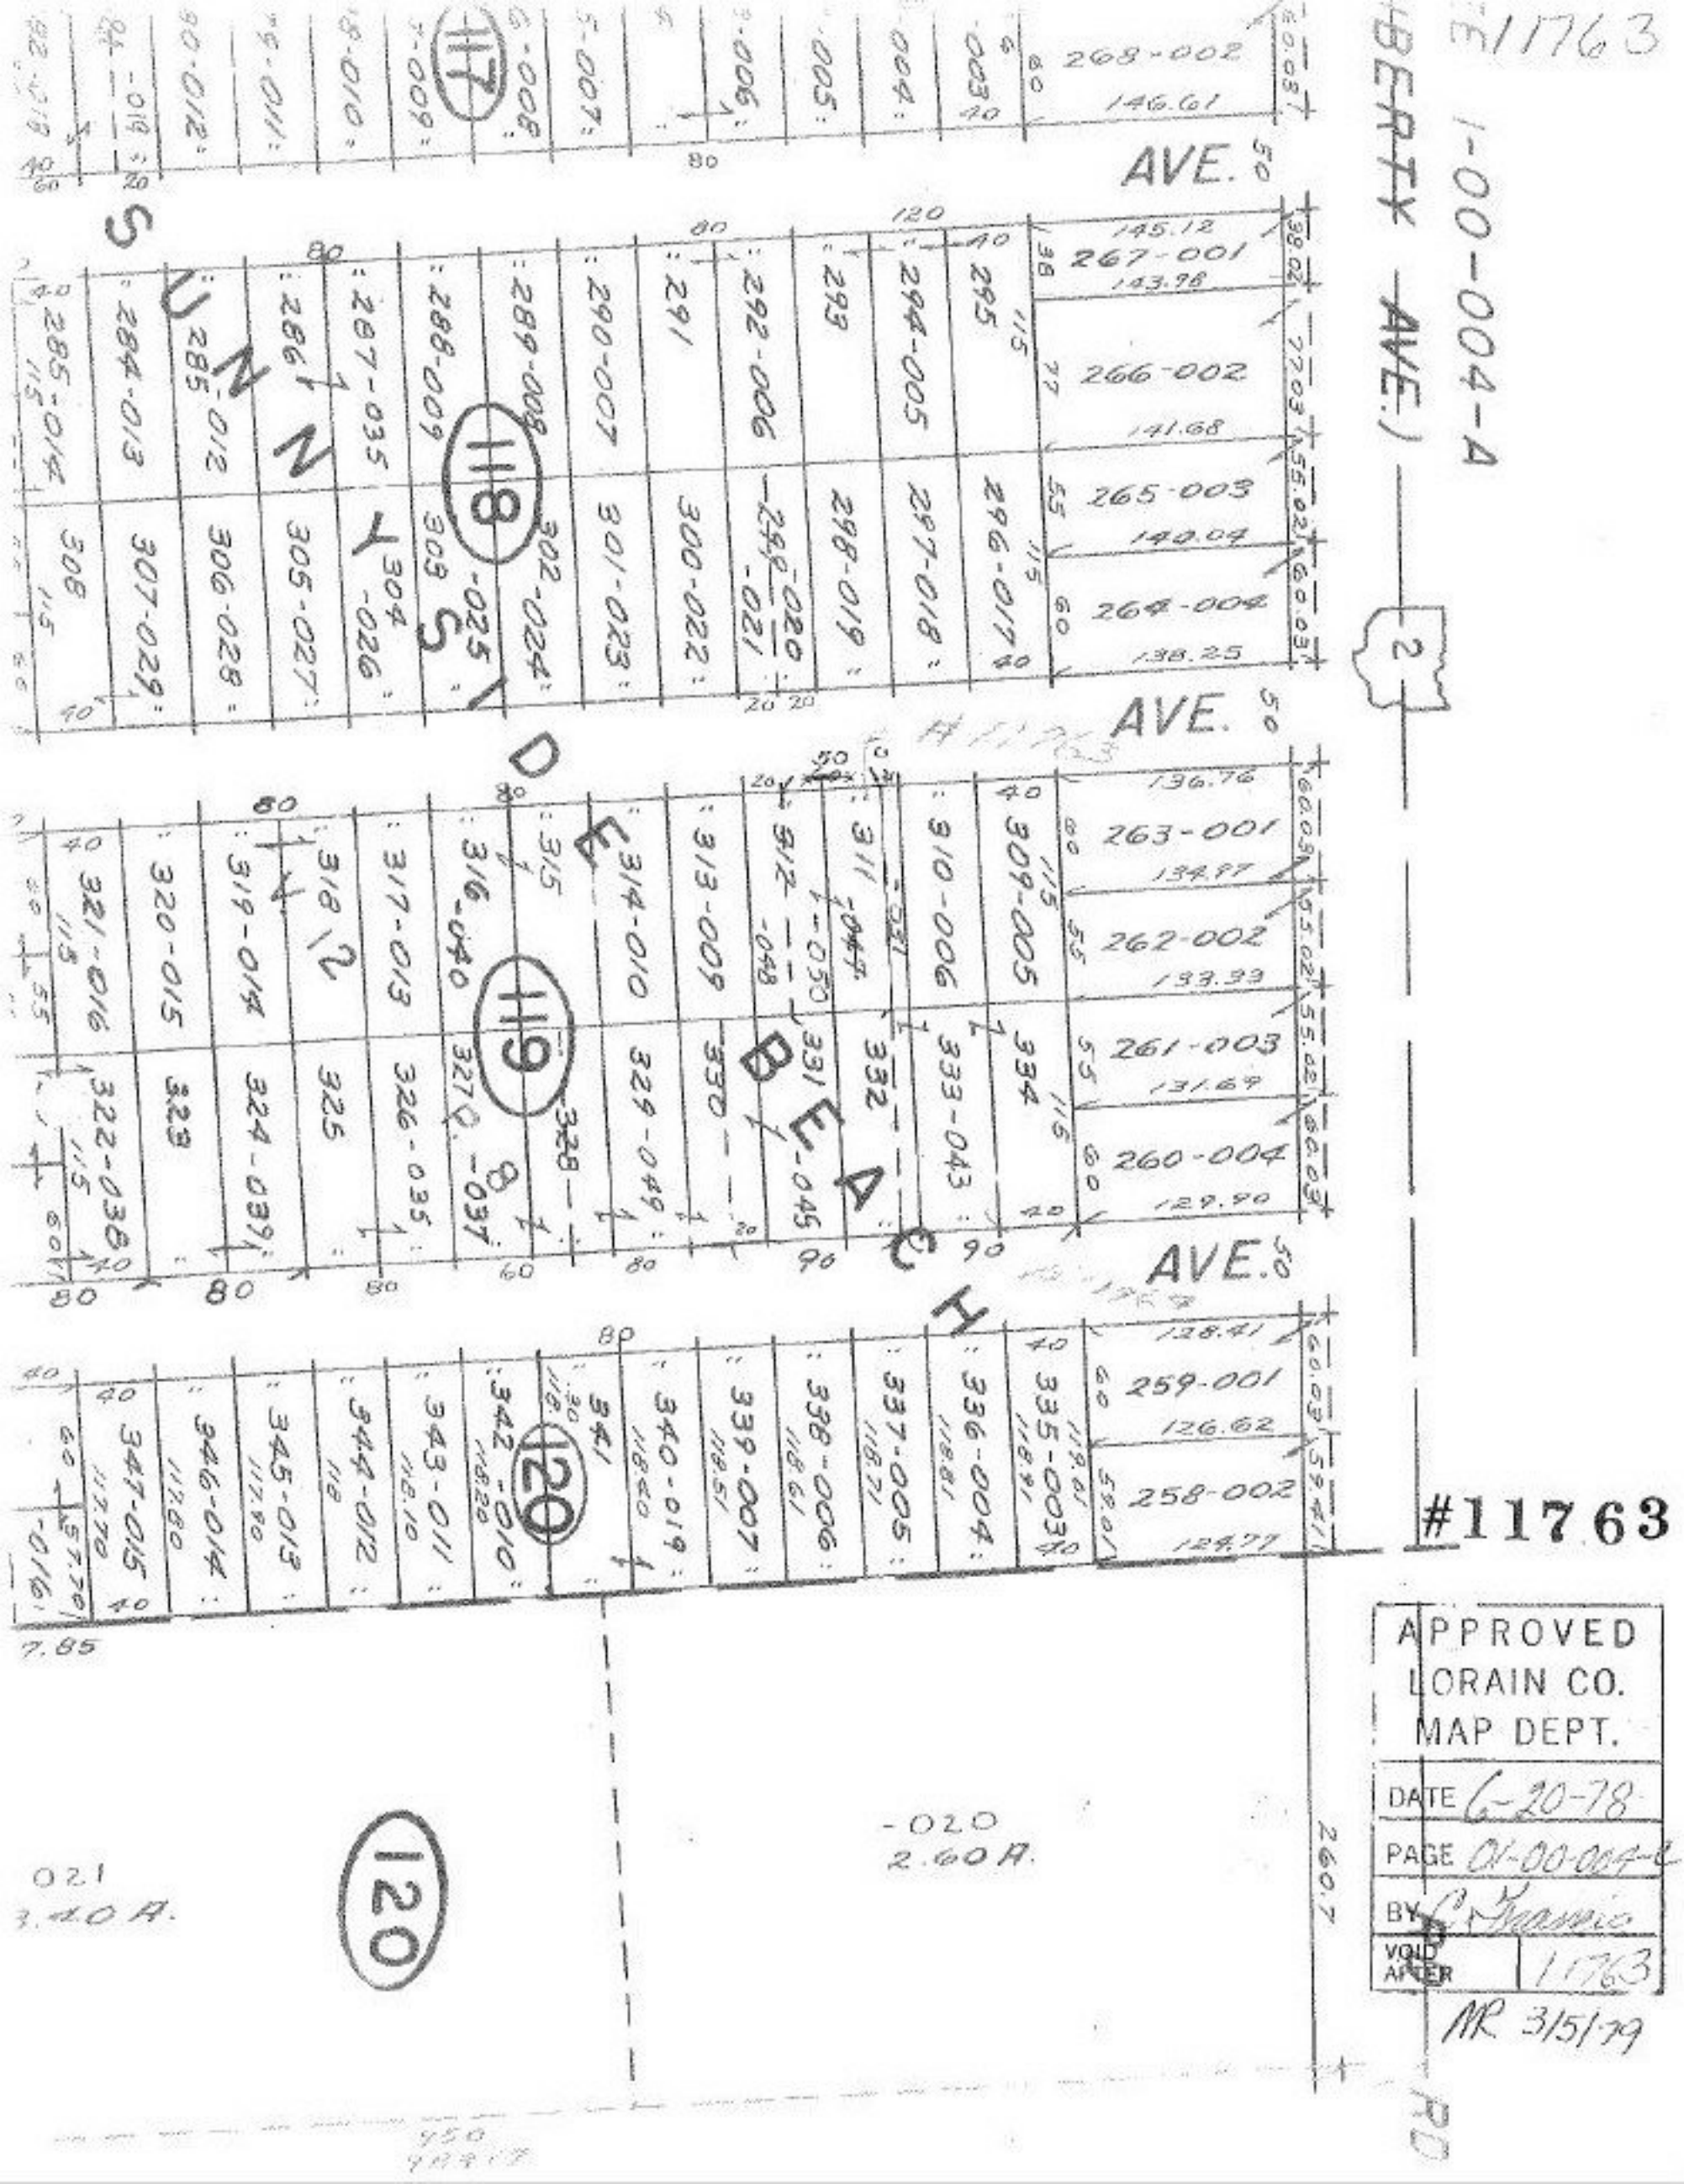

11763
1-00-004-A
BERTY AVE.)
2
AVE.
SUNNY SIDE BEACH
117
118
119
120
268-002
146.61
267-001
143.98
266-002
141.68
265-003
140.04
264-004
138.25
263-001
134.97
262-002
133.33
261-003
131.69
260-004
129.90
259-001
126.62
258-002
124.77
-020
2.60 A.
021
3.40 A.
260.7
#11763
APPROVED
LORAIN CO.
MAP DEPT.
DATE 6-20-78
PAGE 01-00-004-C
BY C. Francis
VOID AFTER 11763
MR 3/5/79