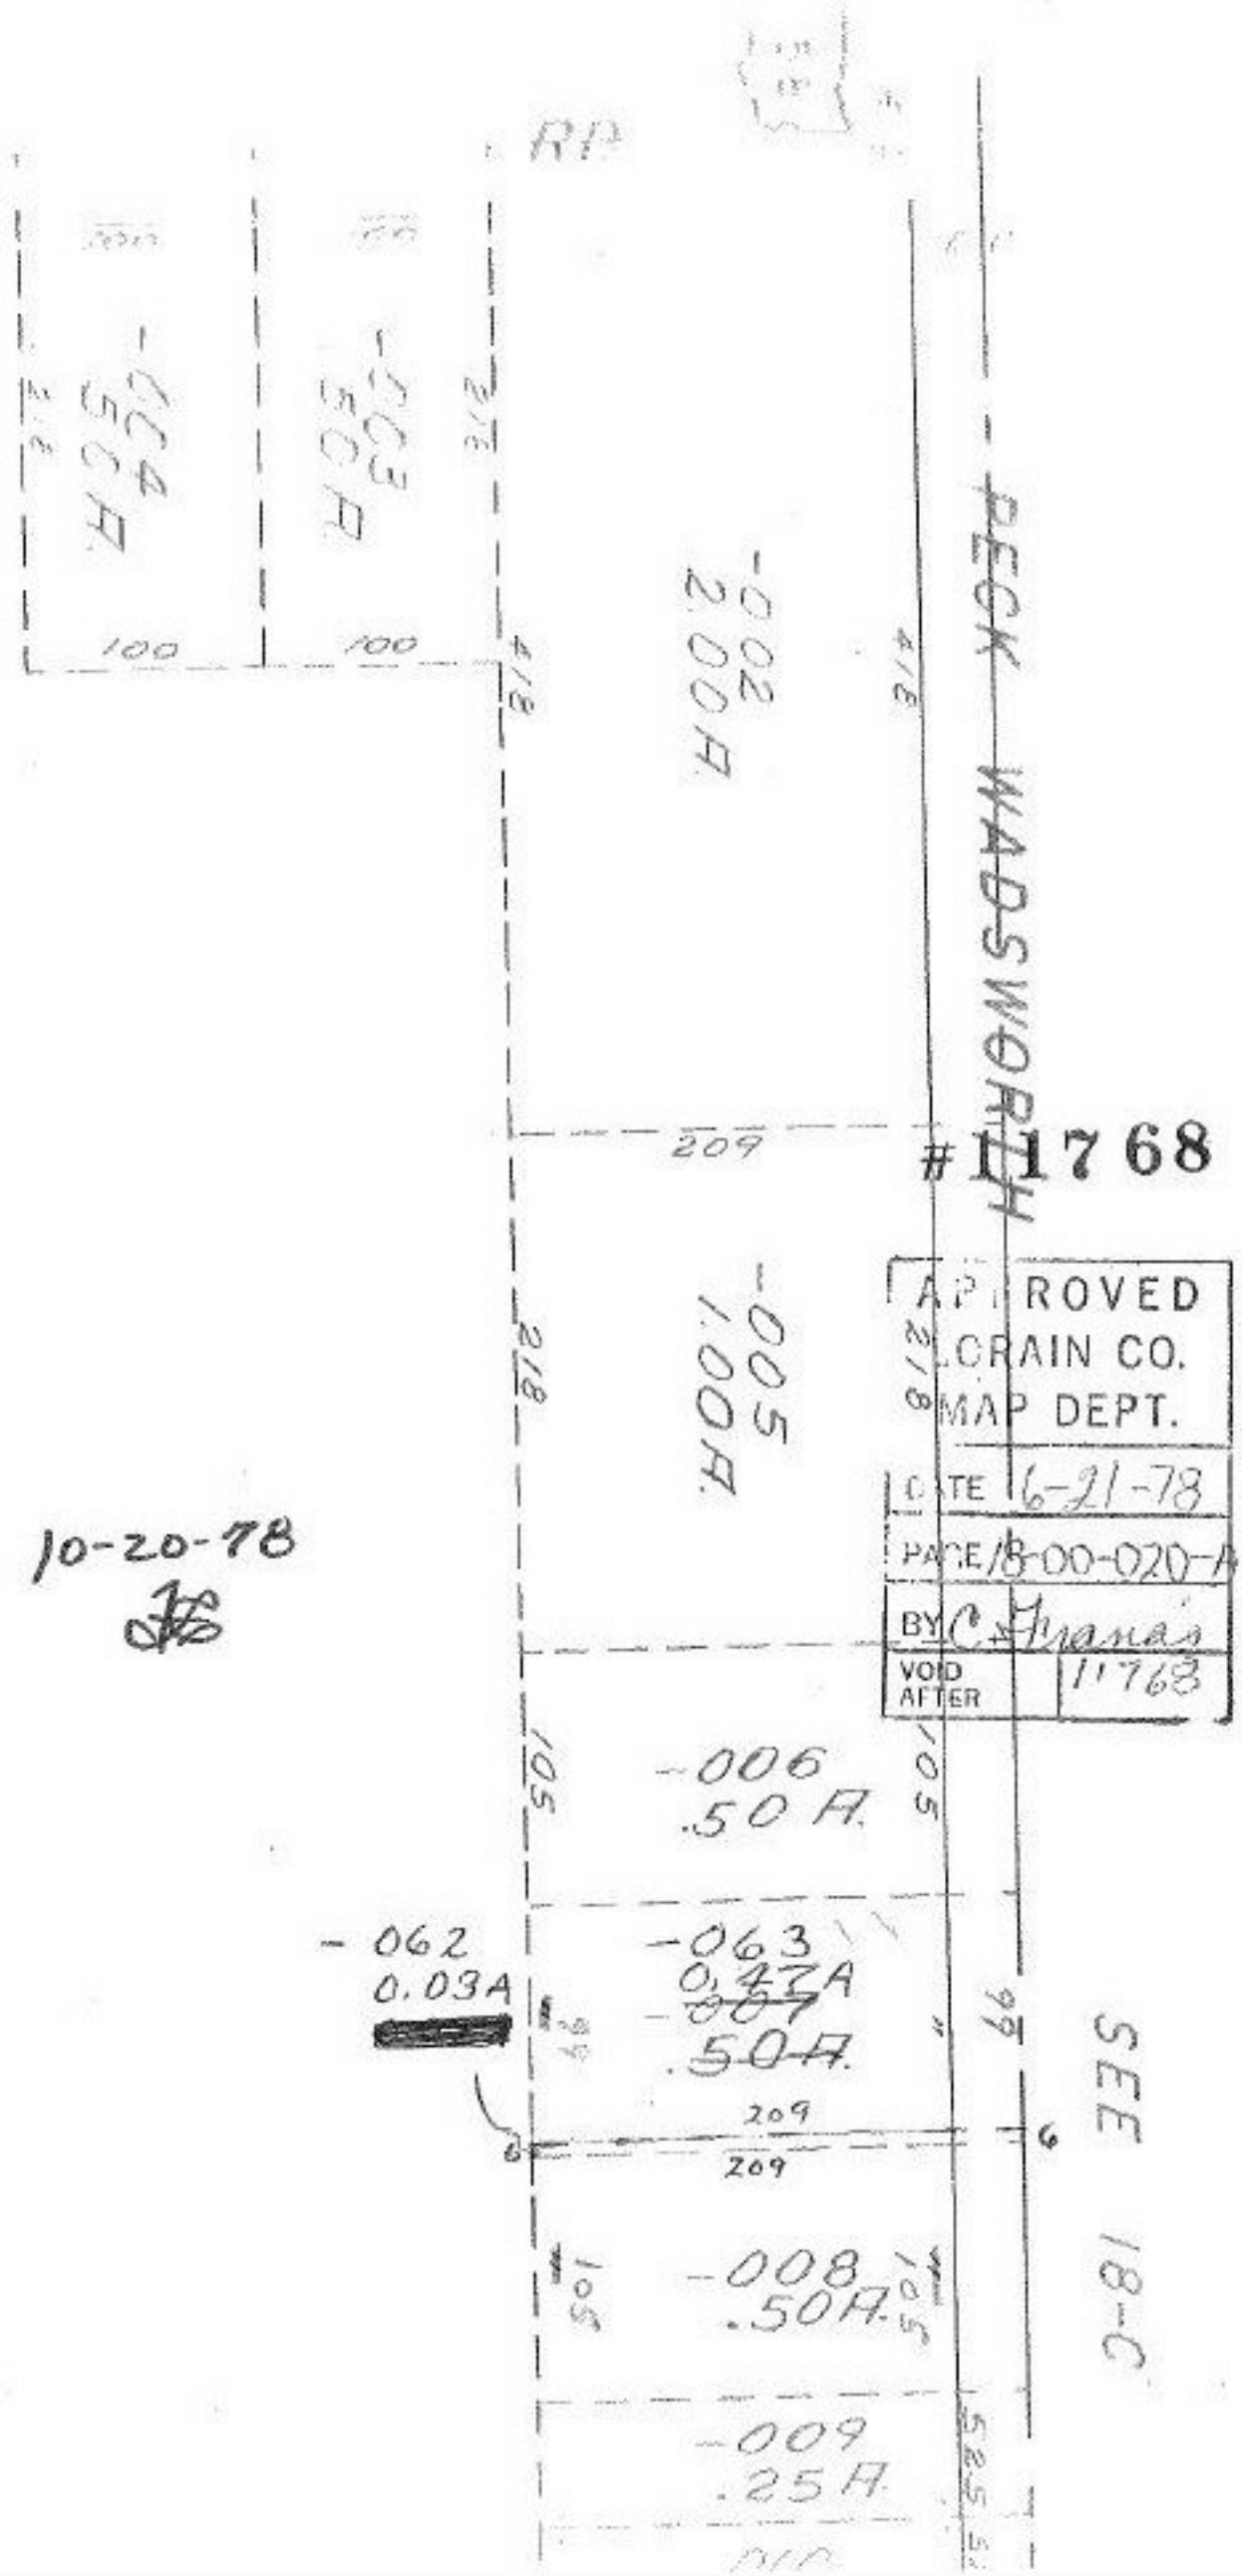
RP
PECK WADSWORTH
-004
50A
-003
50A
-002
2.00A
-005
1.00A
-006
.50A
-062
0.03A
-063
0.47A
~~-007~~
~~.50A~~
-008
.50A
-009
.25A
100
218
209
105
99
6
SEE 18-C
#11768
APPROVED
LORAIN CO.
MAP DEPT.
DATE 6-21-78
PAGE 18-00-020-A
BY C. Franas
VOID AFTER 11768
10-20-78