11770

SEE 3-00-037-A

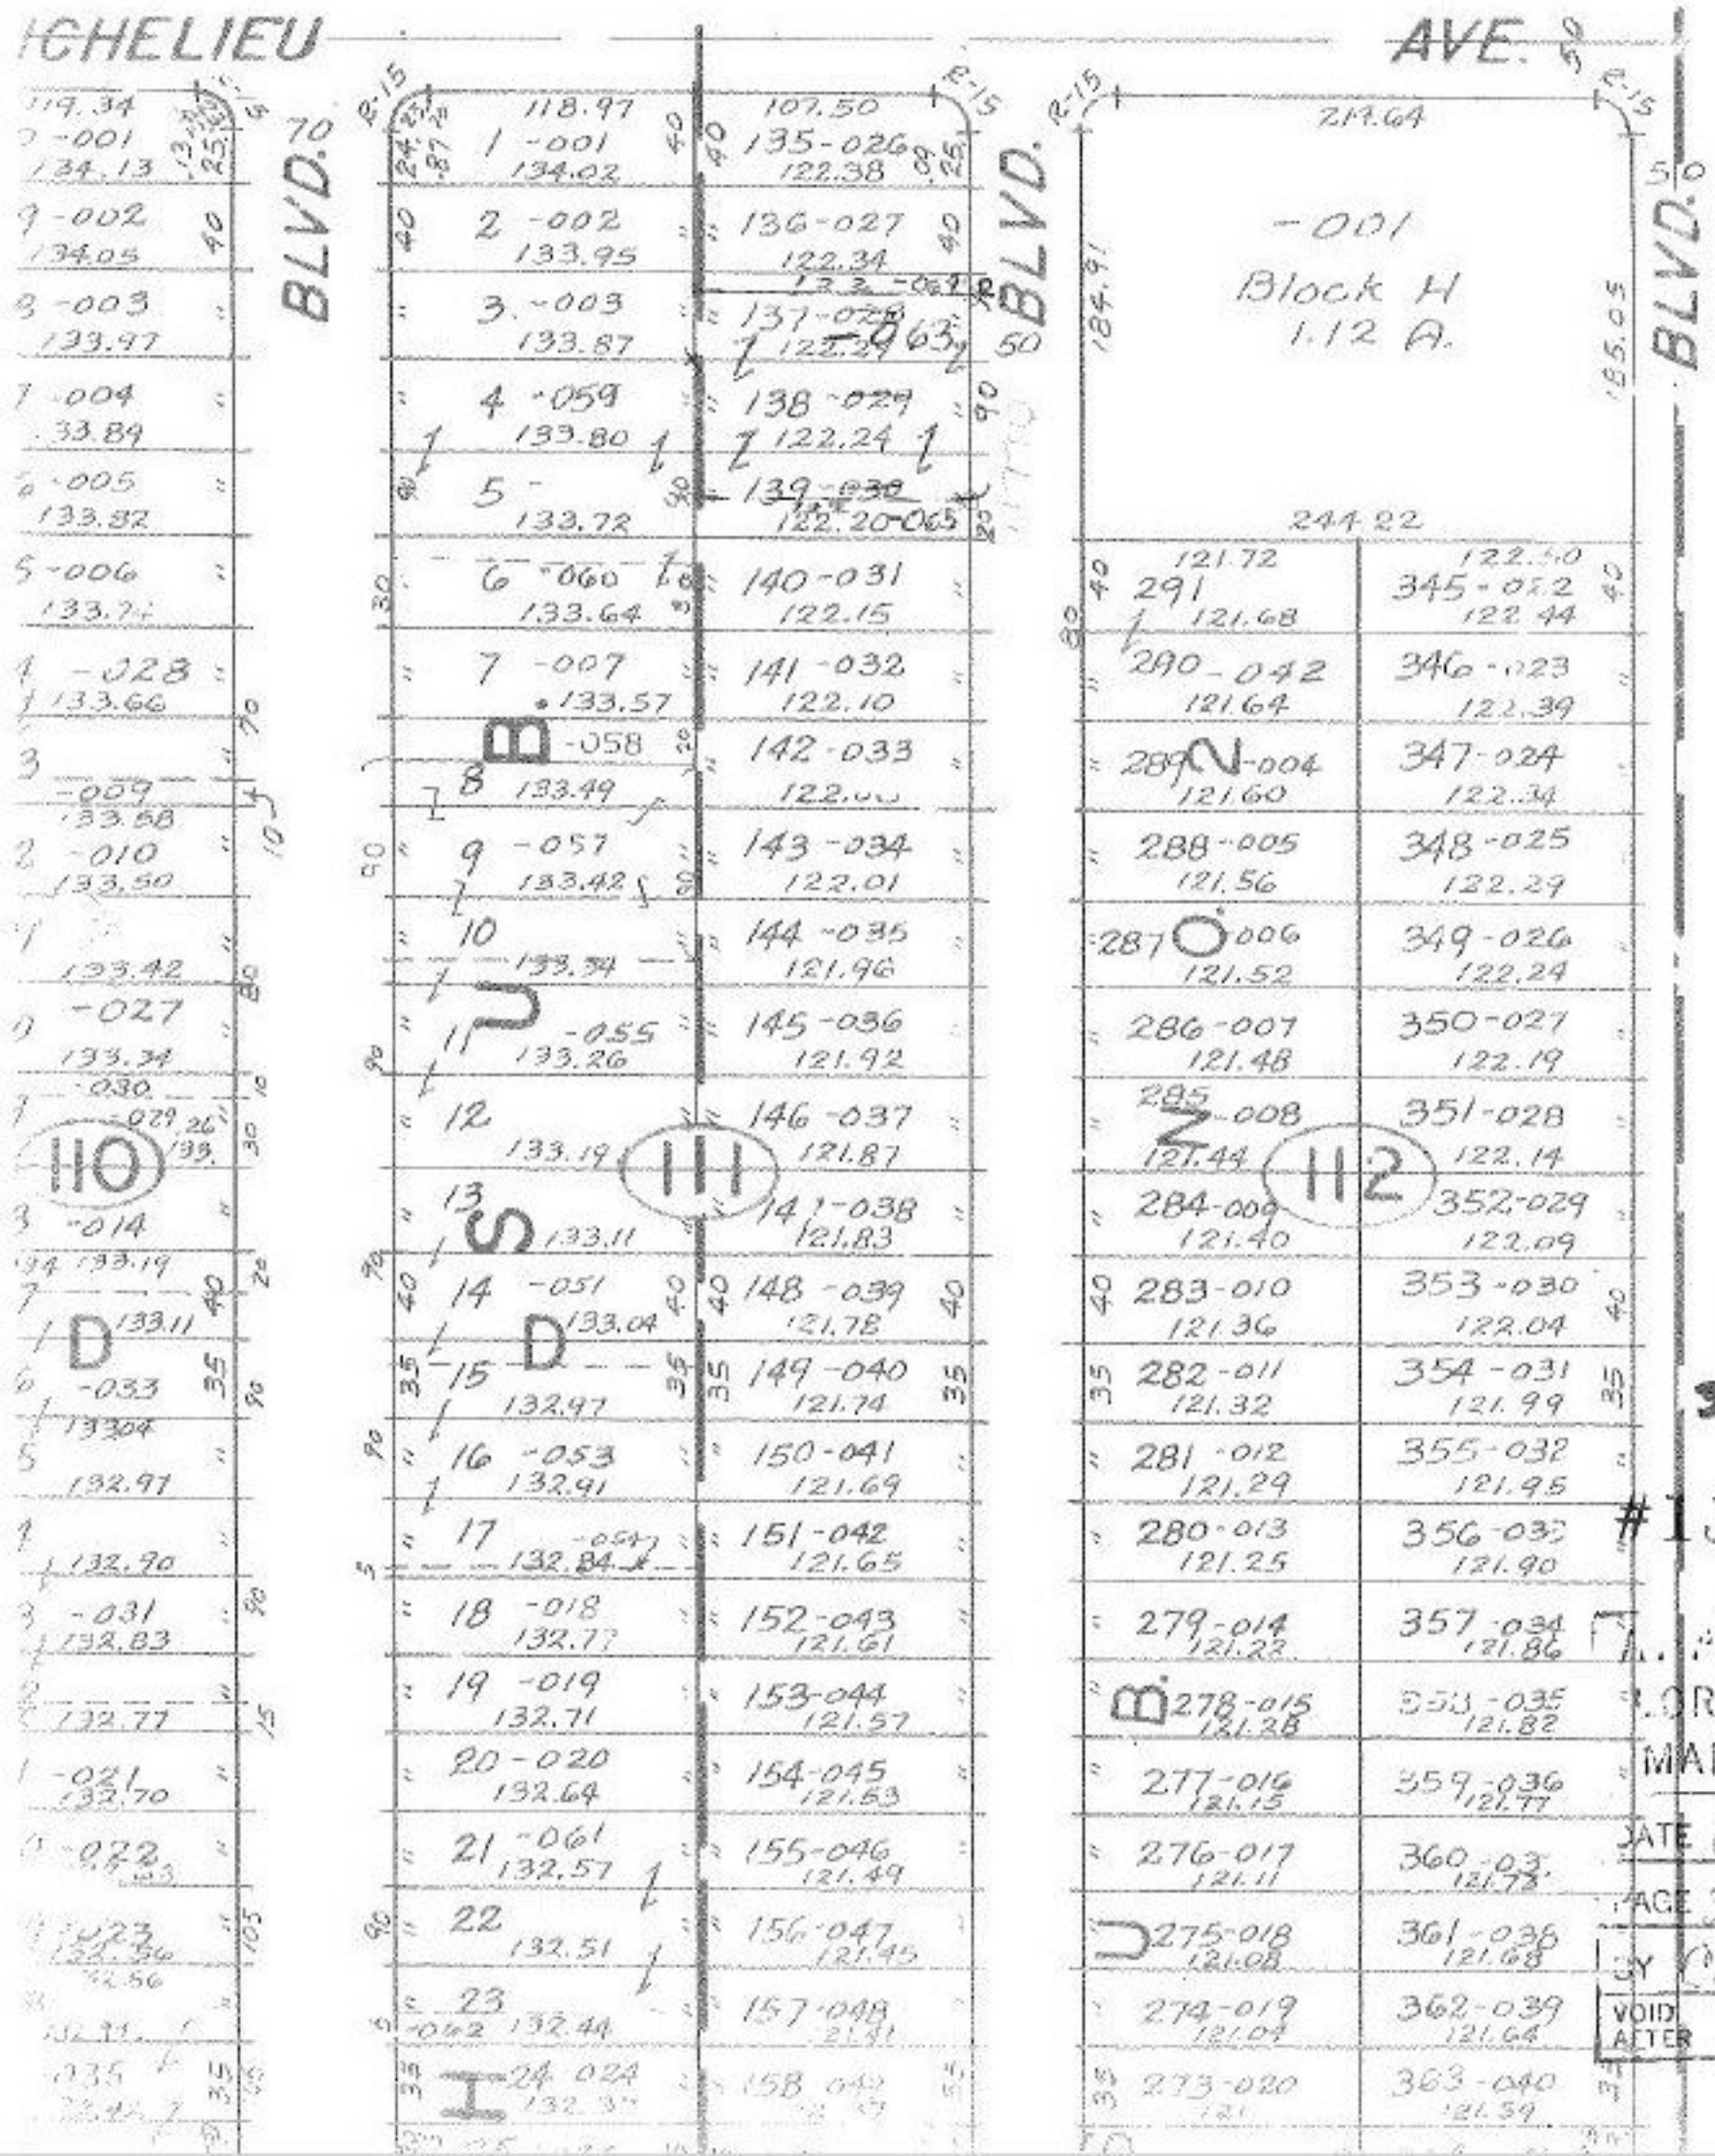

T.M.
3-20-79

#11770

APPROVED
BLORAIN CO.
MAP DEPT.
DATE 6-21-78
PAGE 3-00-037
BY C. Francis
VOID AFTER 11770