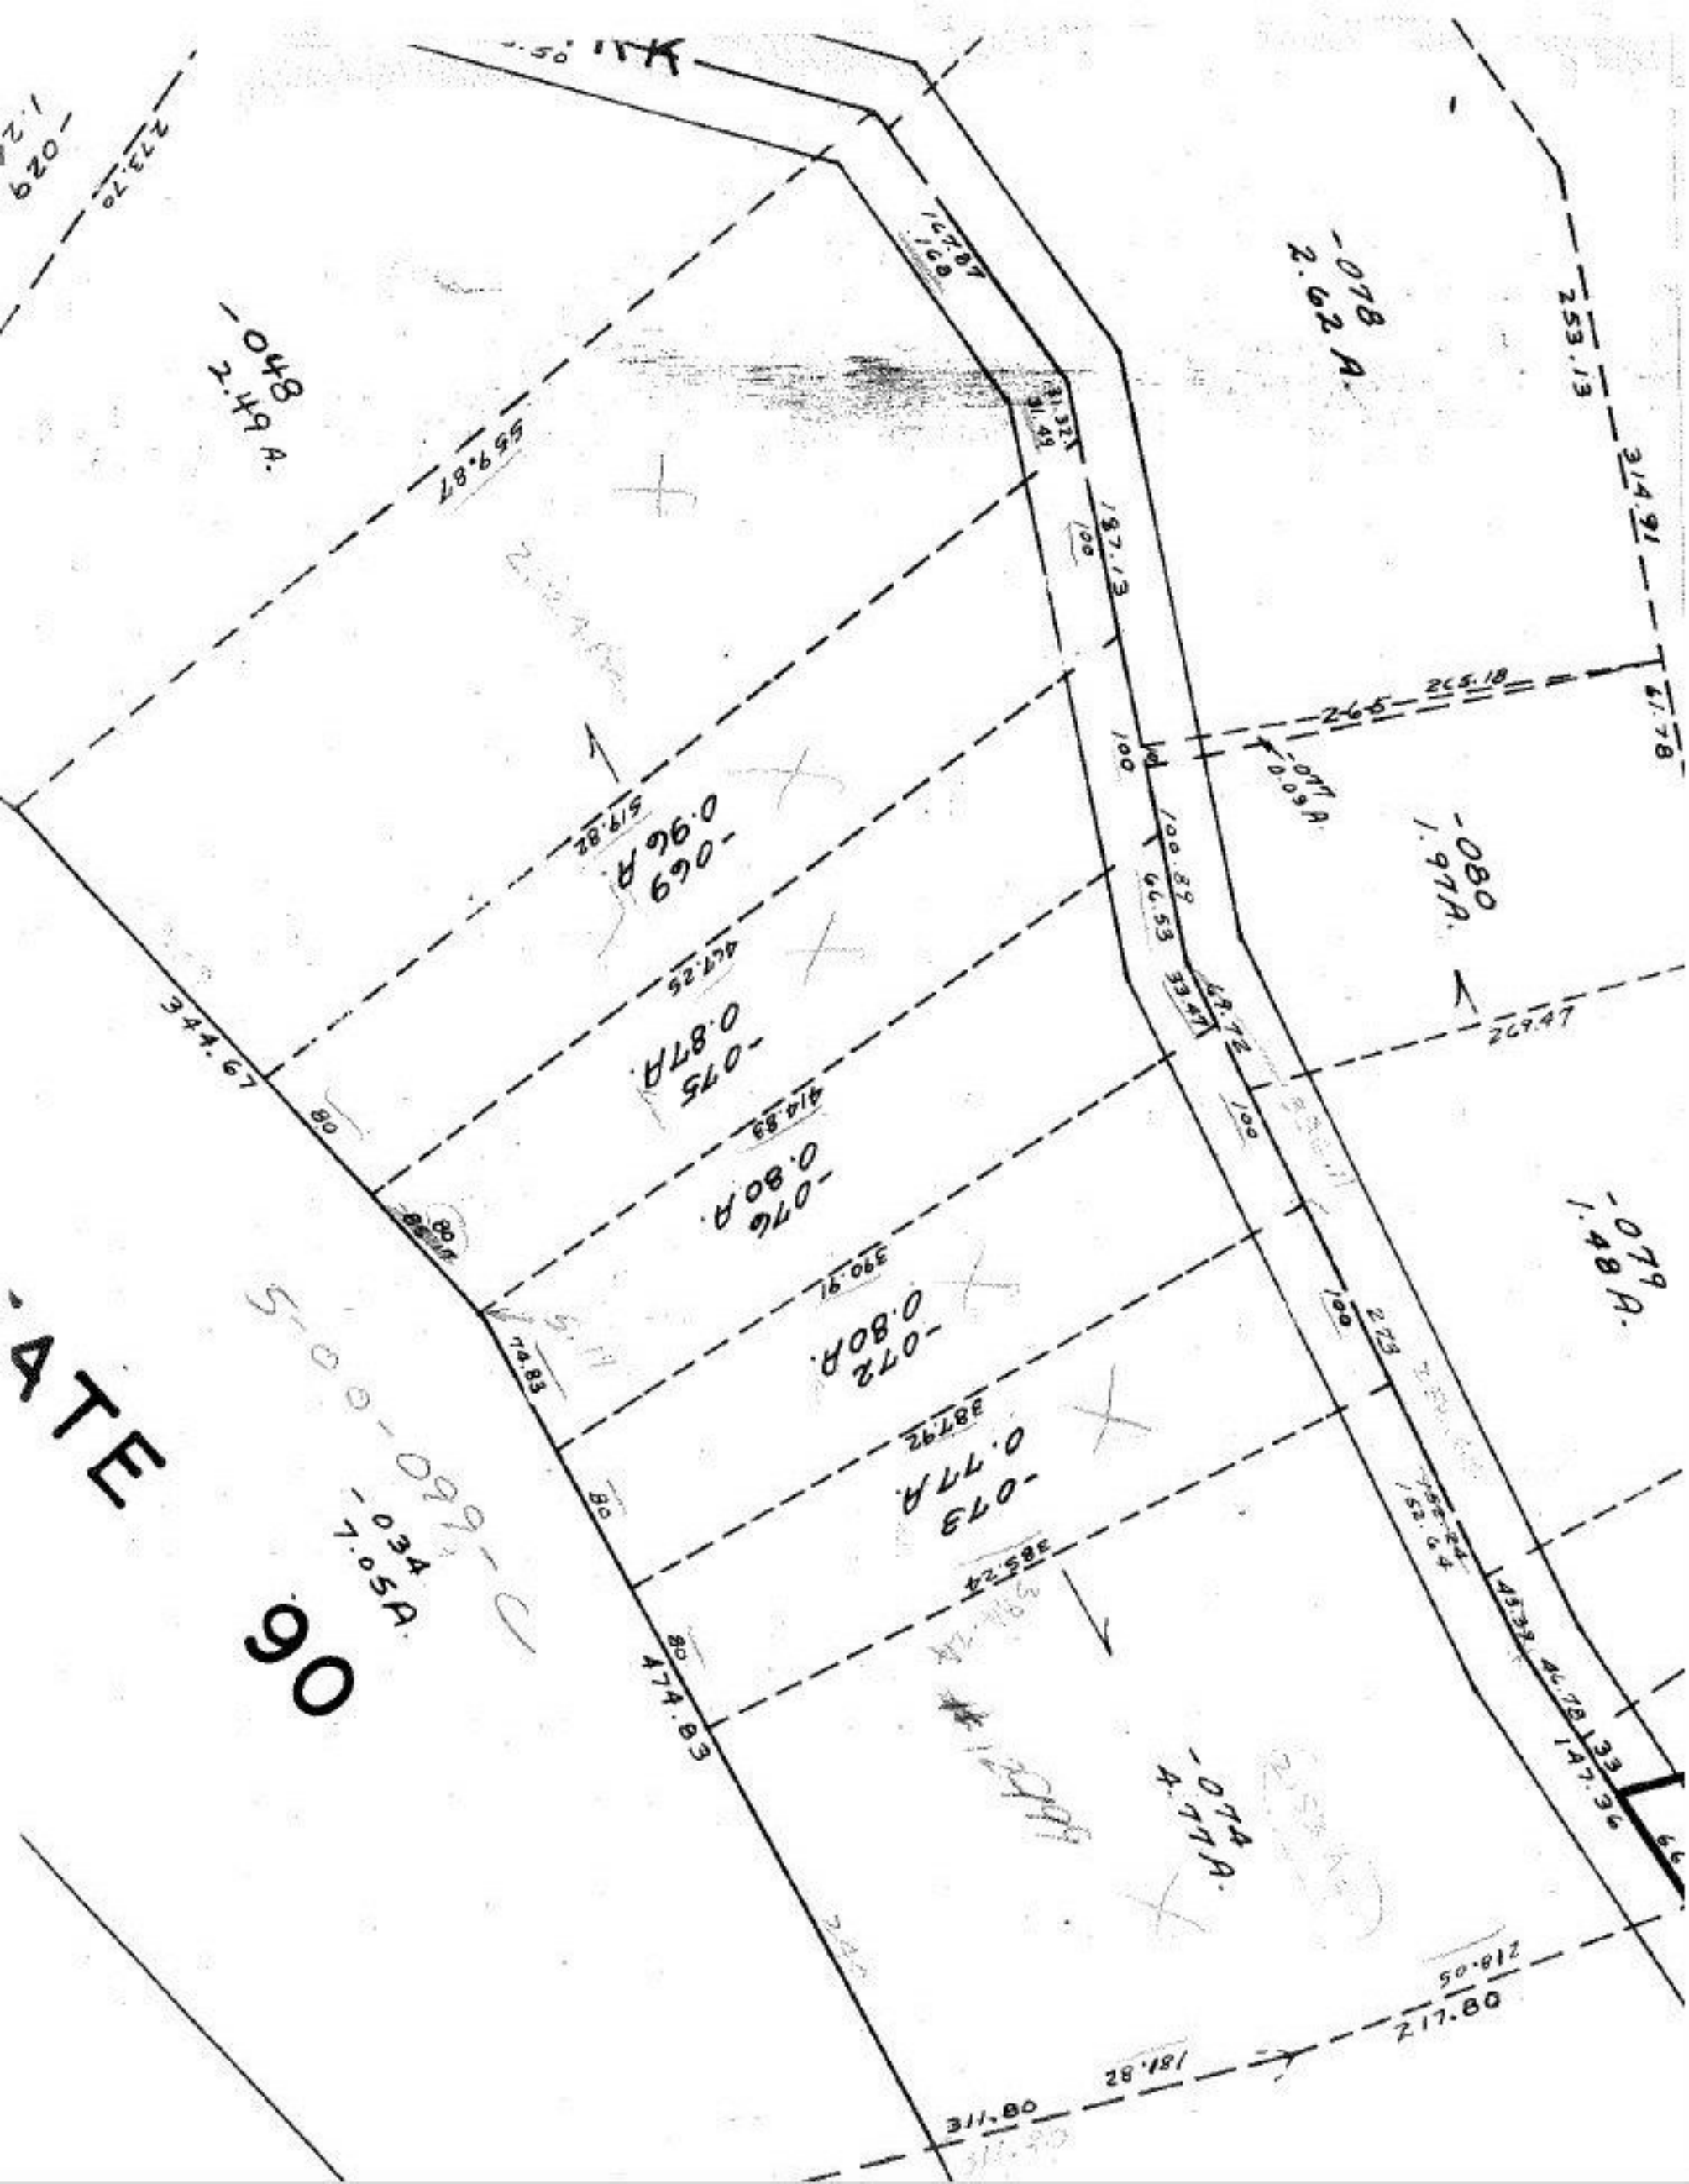

-078
2.62 A.
-048
2.49 A.
-080
1.97 A.
-079
1.48 A.
-069
0.96 A.
-075
0.87 A.
-076
0.80 A.
-072
0.80 A.
-073
0.77 A.
-074
4.77 A.
-034
7.05 A.
-029
-077
0.09 A.
ATE
90
253.13
314.91
61.78
265.18
265
269.47
147.36
217.80
311.80
344.67
474.83
559.87
519.82
467.25
414.83
390.91
387.92
385.24
167.87
168
187.13
100
100.89
66.53
33.47
69.72
273
152.64
43.39
46.78
33
74.83
80