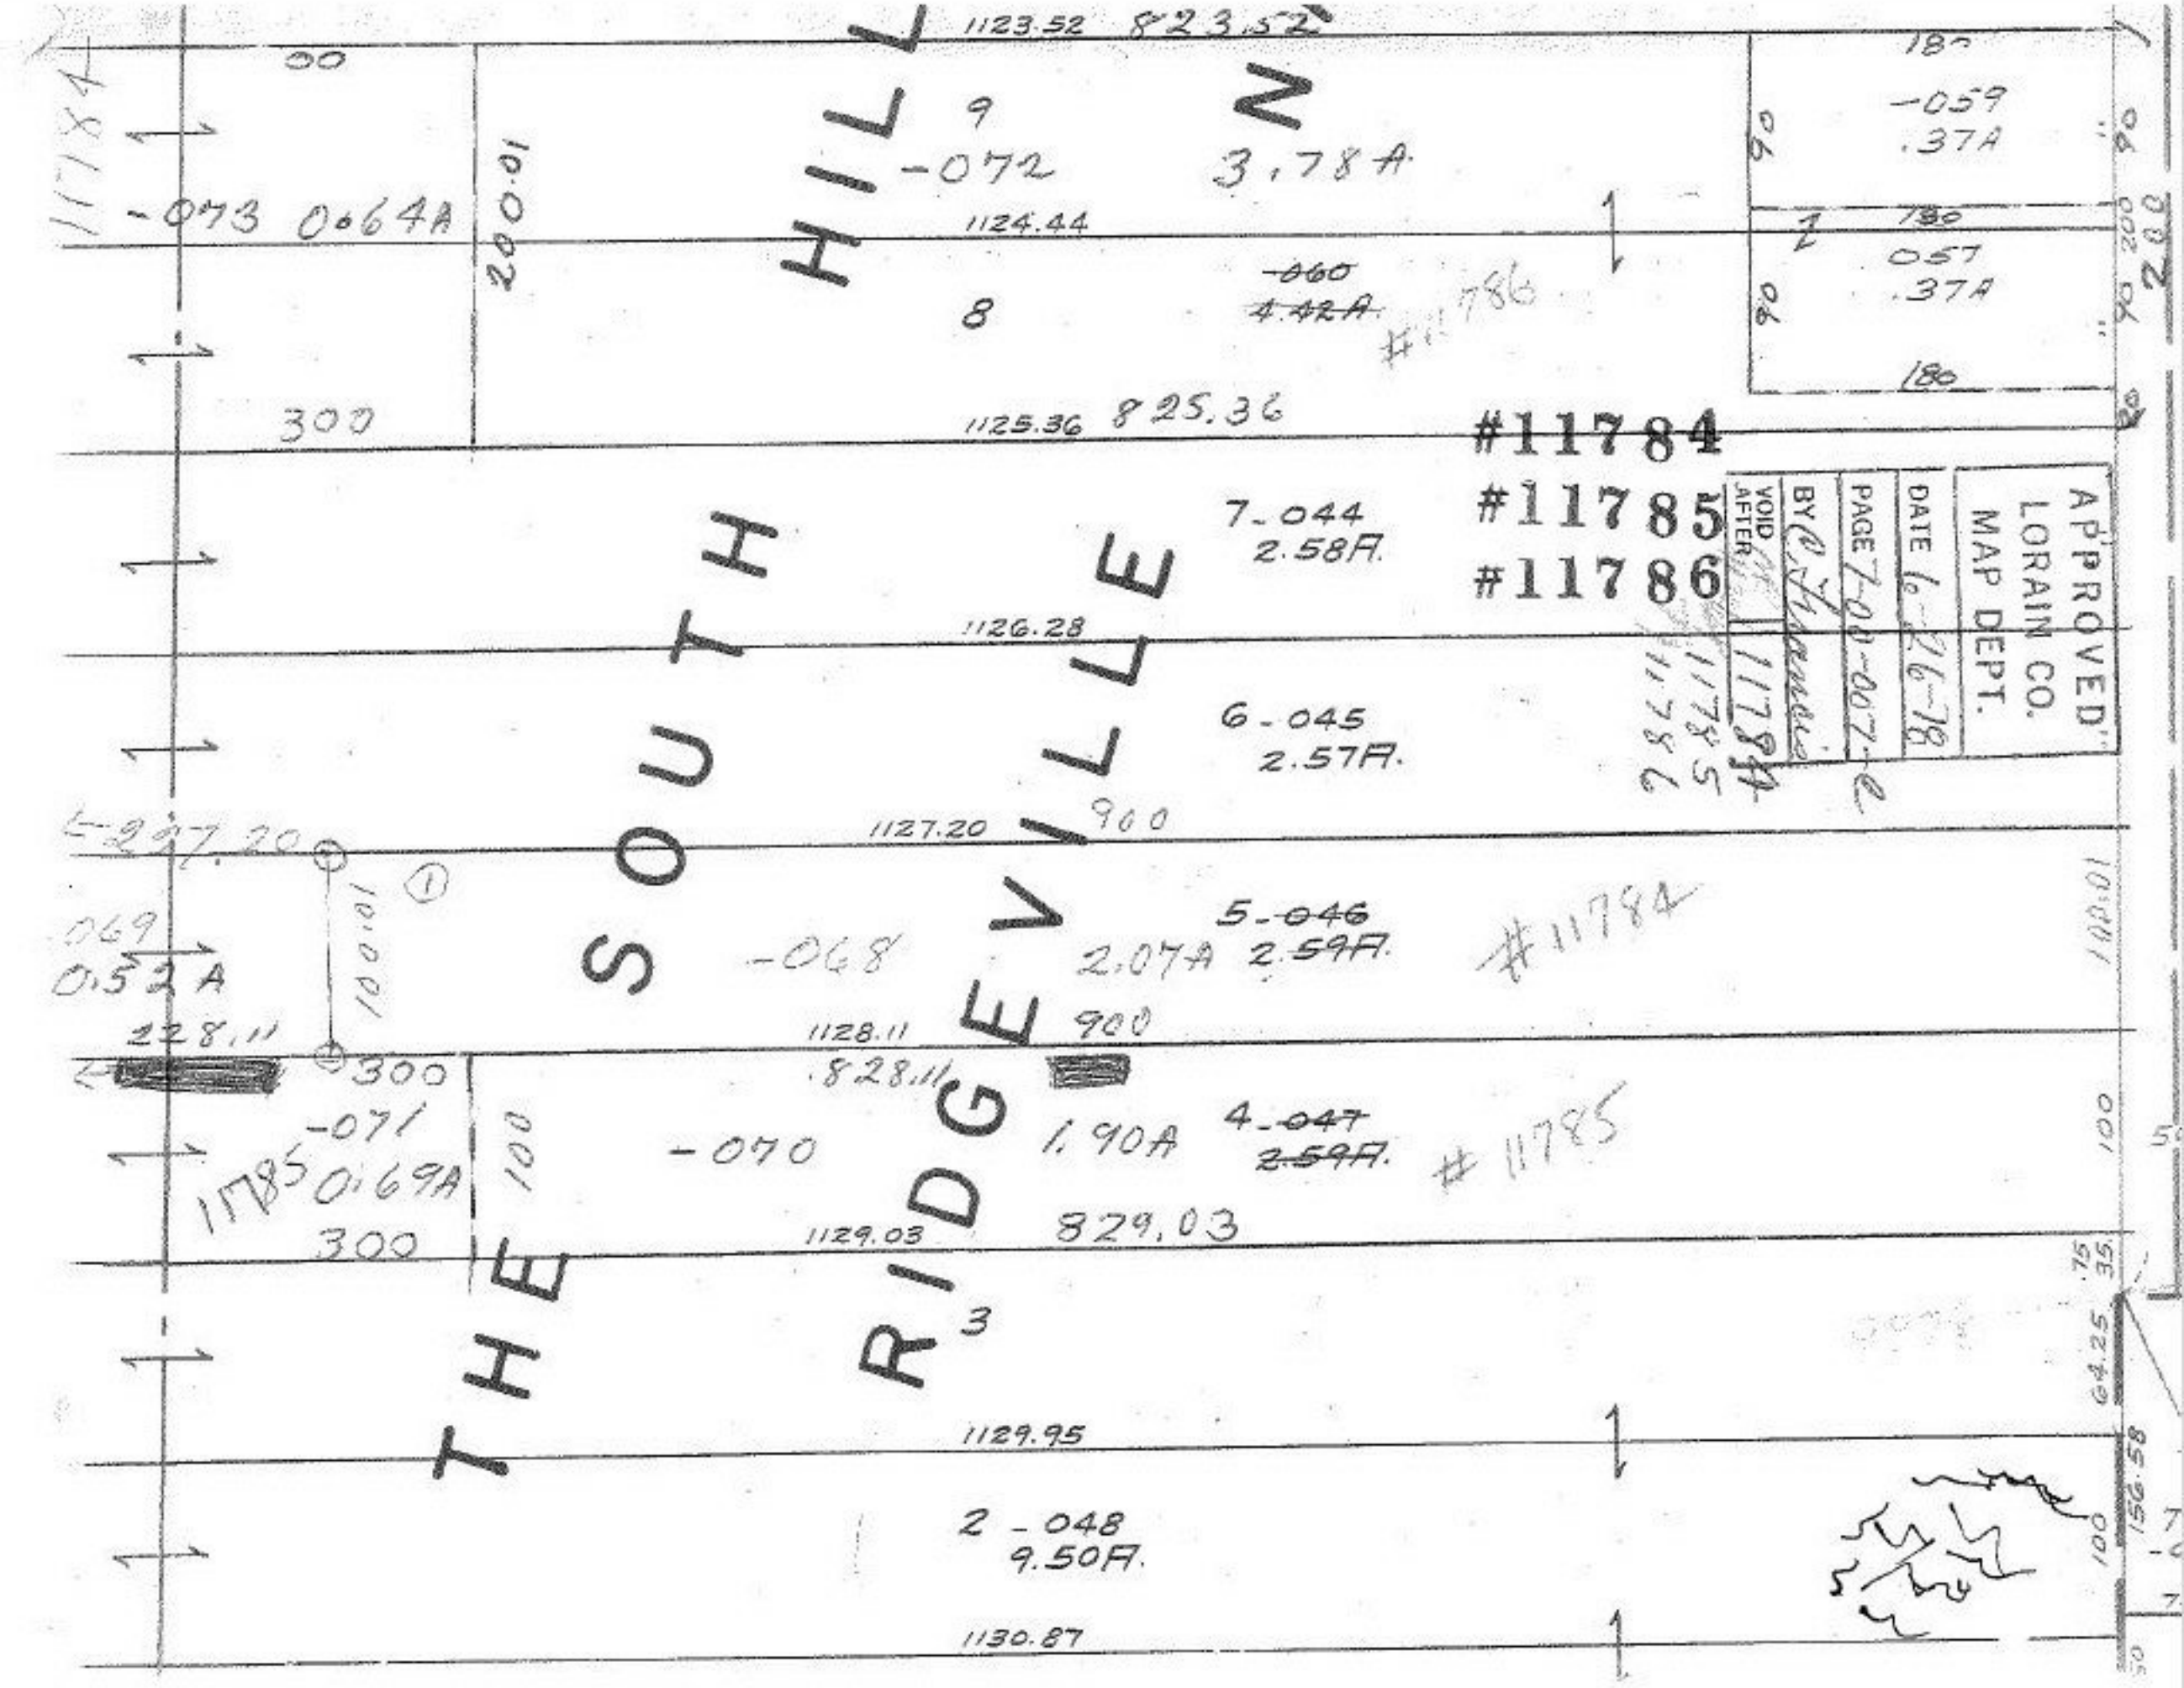

THE SOUTH HILL
RIDGEVILLE
1123.52 823.52
9
-072
3.78A
1124.44
8
~~-060~~
~~4.42A~~
#11786
1125.36 825.36
7-044
2.58A
1126.28
6-045
2.57A
1127.20 900
5-~~046~~
2.07A ~~2.59A~~
#11784
-068
1128.11 900
828.11
4-~~047~~
~~2.59A~~
1.90A
#11785
-070
1129.03 829.03
3
1129.95
2-048
9.50A
1130.87
-073 0.64A
200.01
300
-071
0.69A
11785
300
100
-069
0.52A
228.11
297.20
100.01
1
-059
.37A
057
.37A
180
90
200
#11784
#11785
#11786
APPROVED
LORAIN CO.
MAP DEPT.
DATE 6-26-78
PAGE 7-00-007-e
BY C. Francis
VOID AFTER
11784
11785
11786