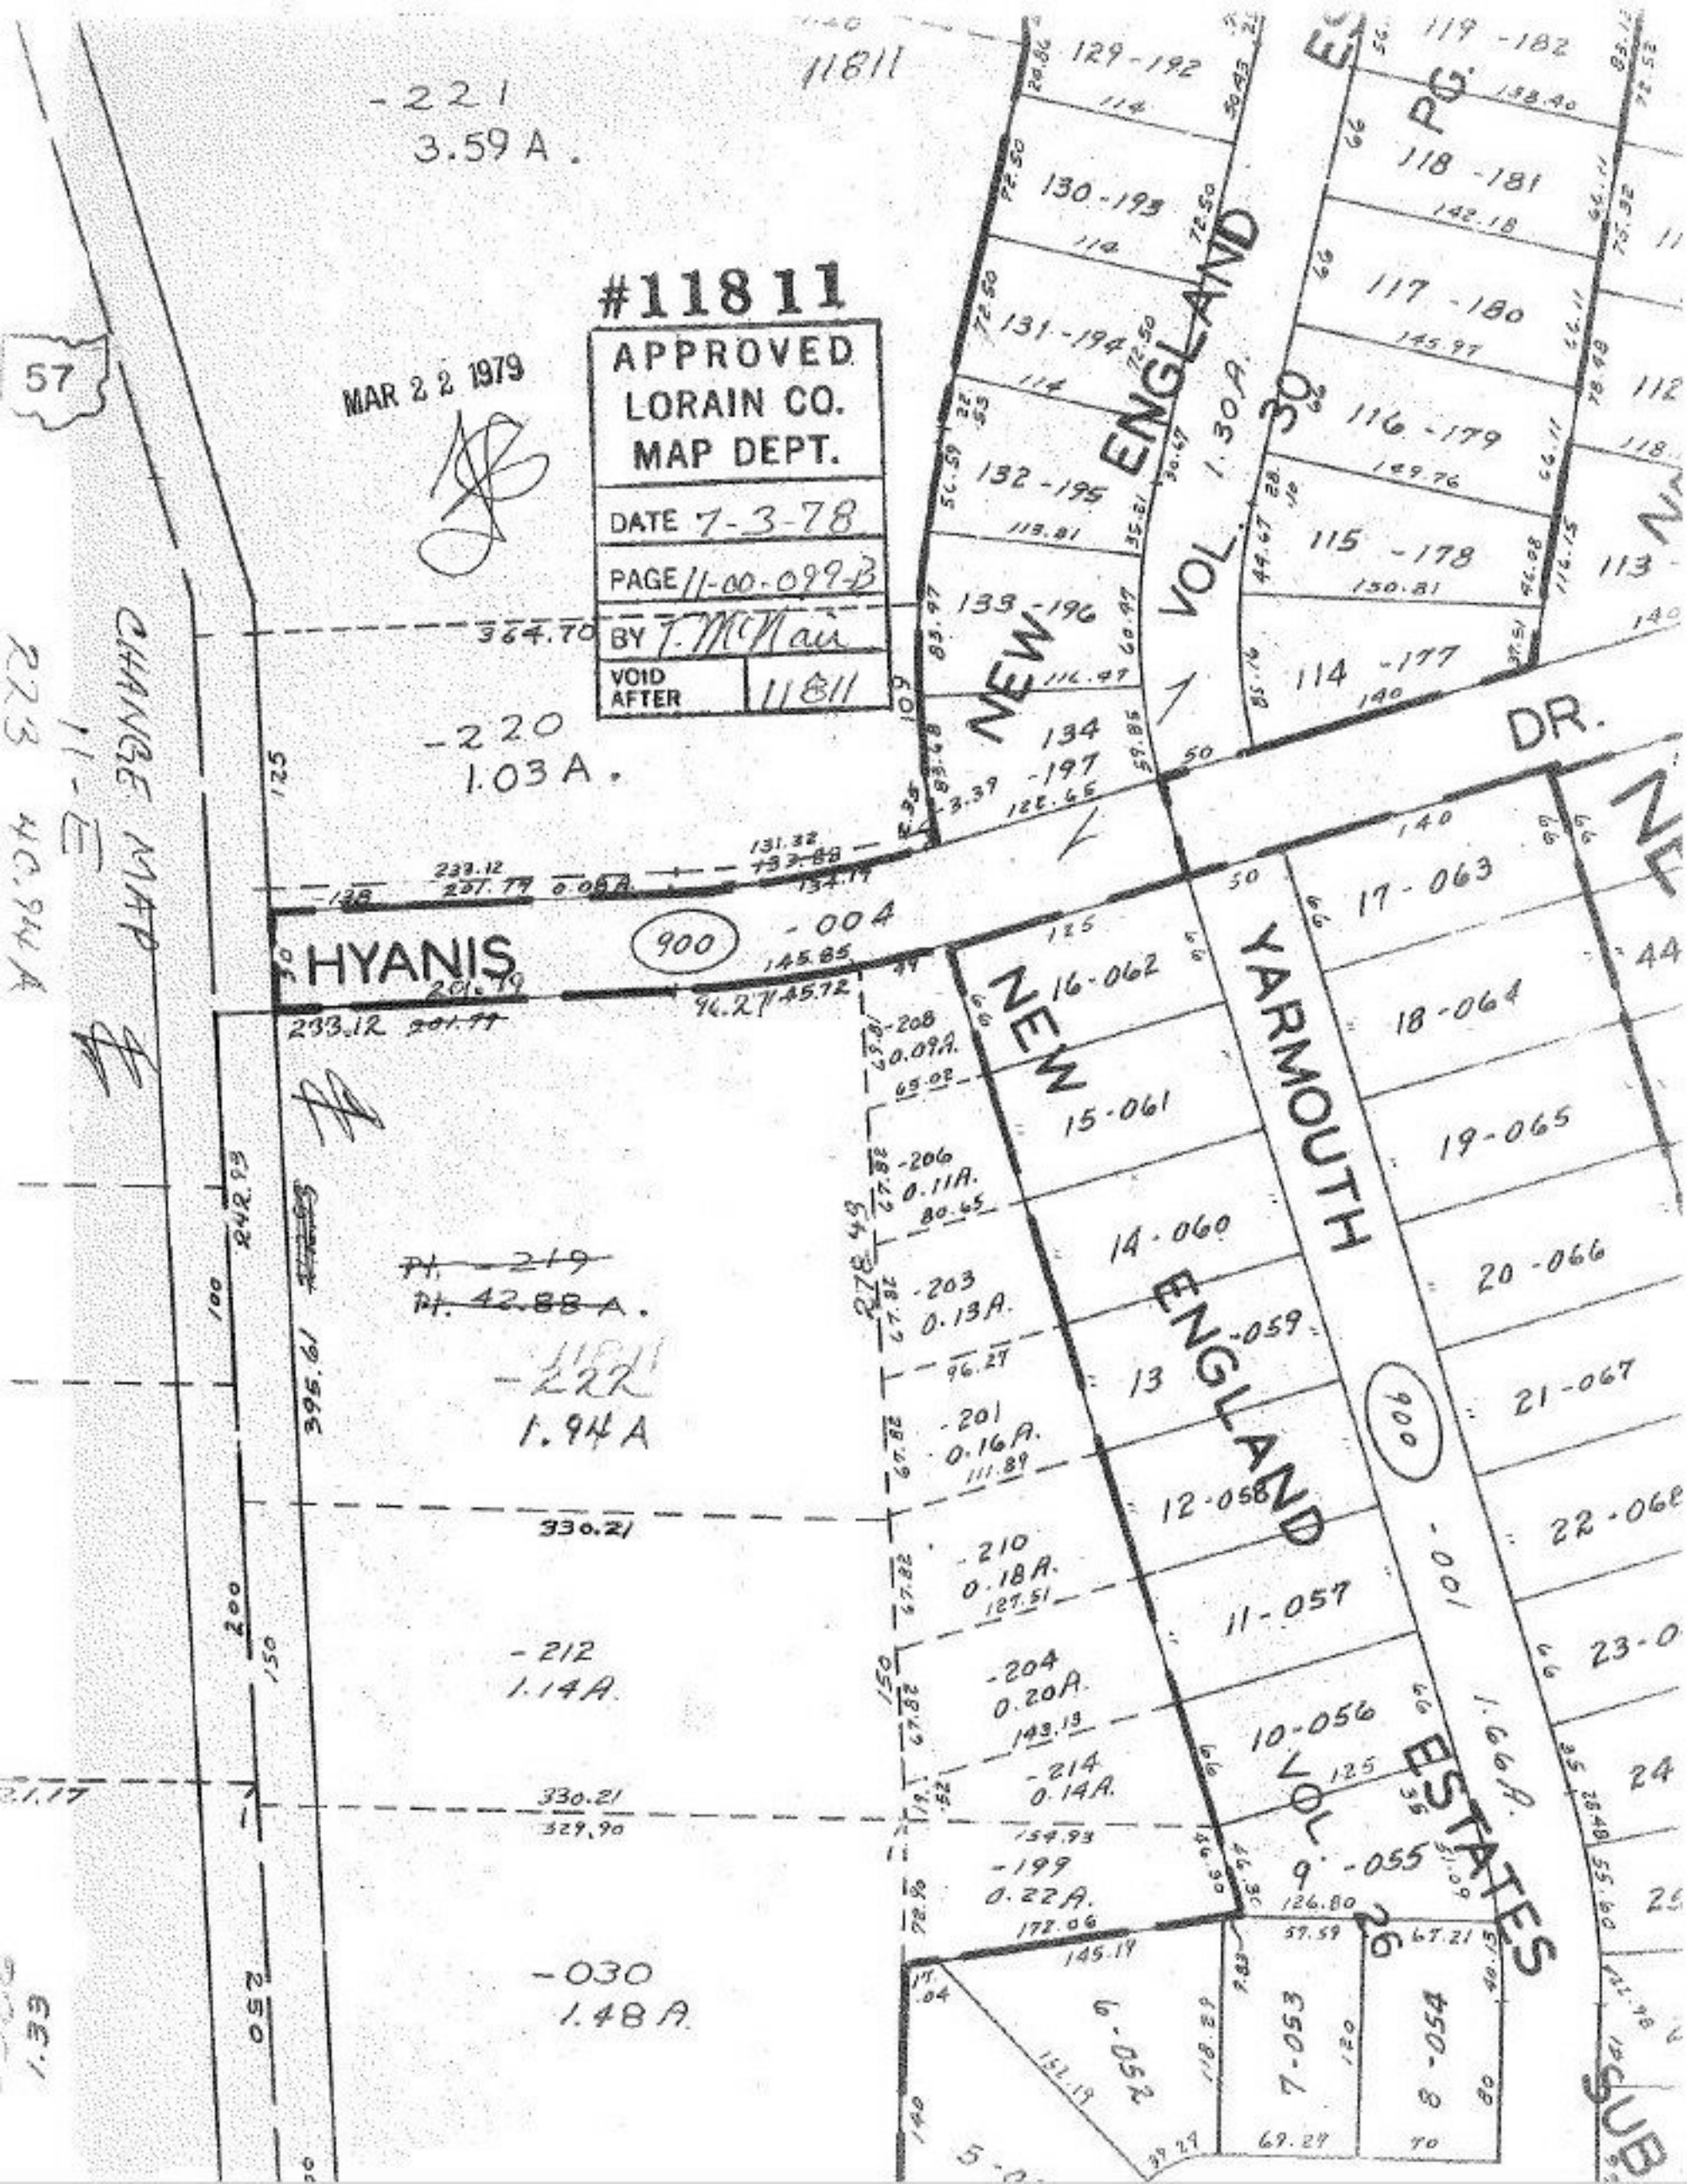

#11811
APPROVED
LORAIN CO.
MAP DEPT.
DATE 7-3-78
PAGE 11-00-099-B
BY T. McNair
VOID AFTER 11811
MAR 22 1979
57
CHANGE MAP
11-E
223 40.94A
-221
3.59 A.
-220
1.03 A.
-222
1.94 A
-212
1.14 A.
-030
1.48 A.
HYANIS
900
NEW ENGLAND
VOL. 30
NEW ENGLAND ESTATES
VOL. 26
YARMOUTH
DR.
PG.
1.30 A.
1.66 A.
364.70
330.21
329.90