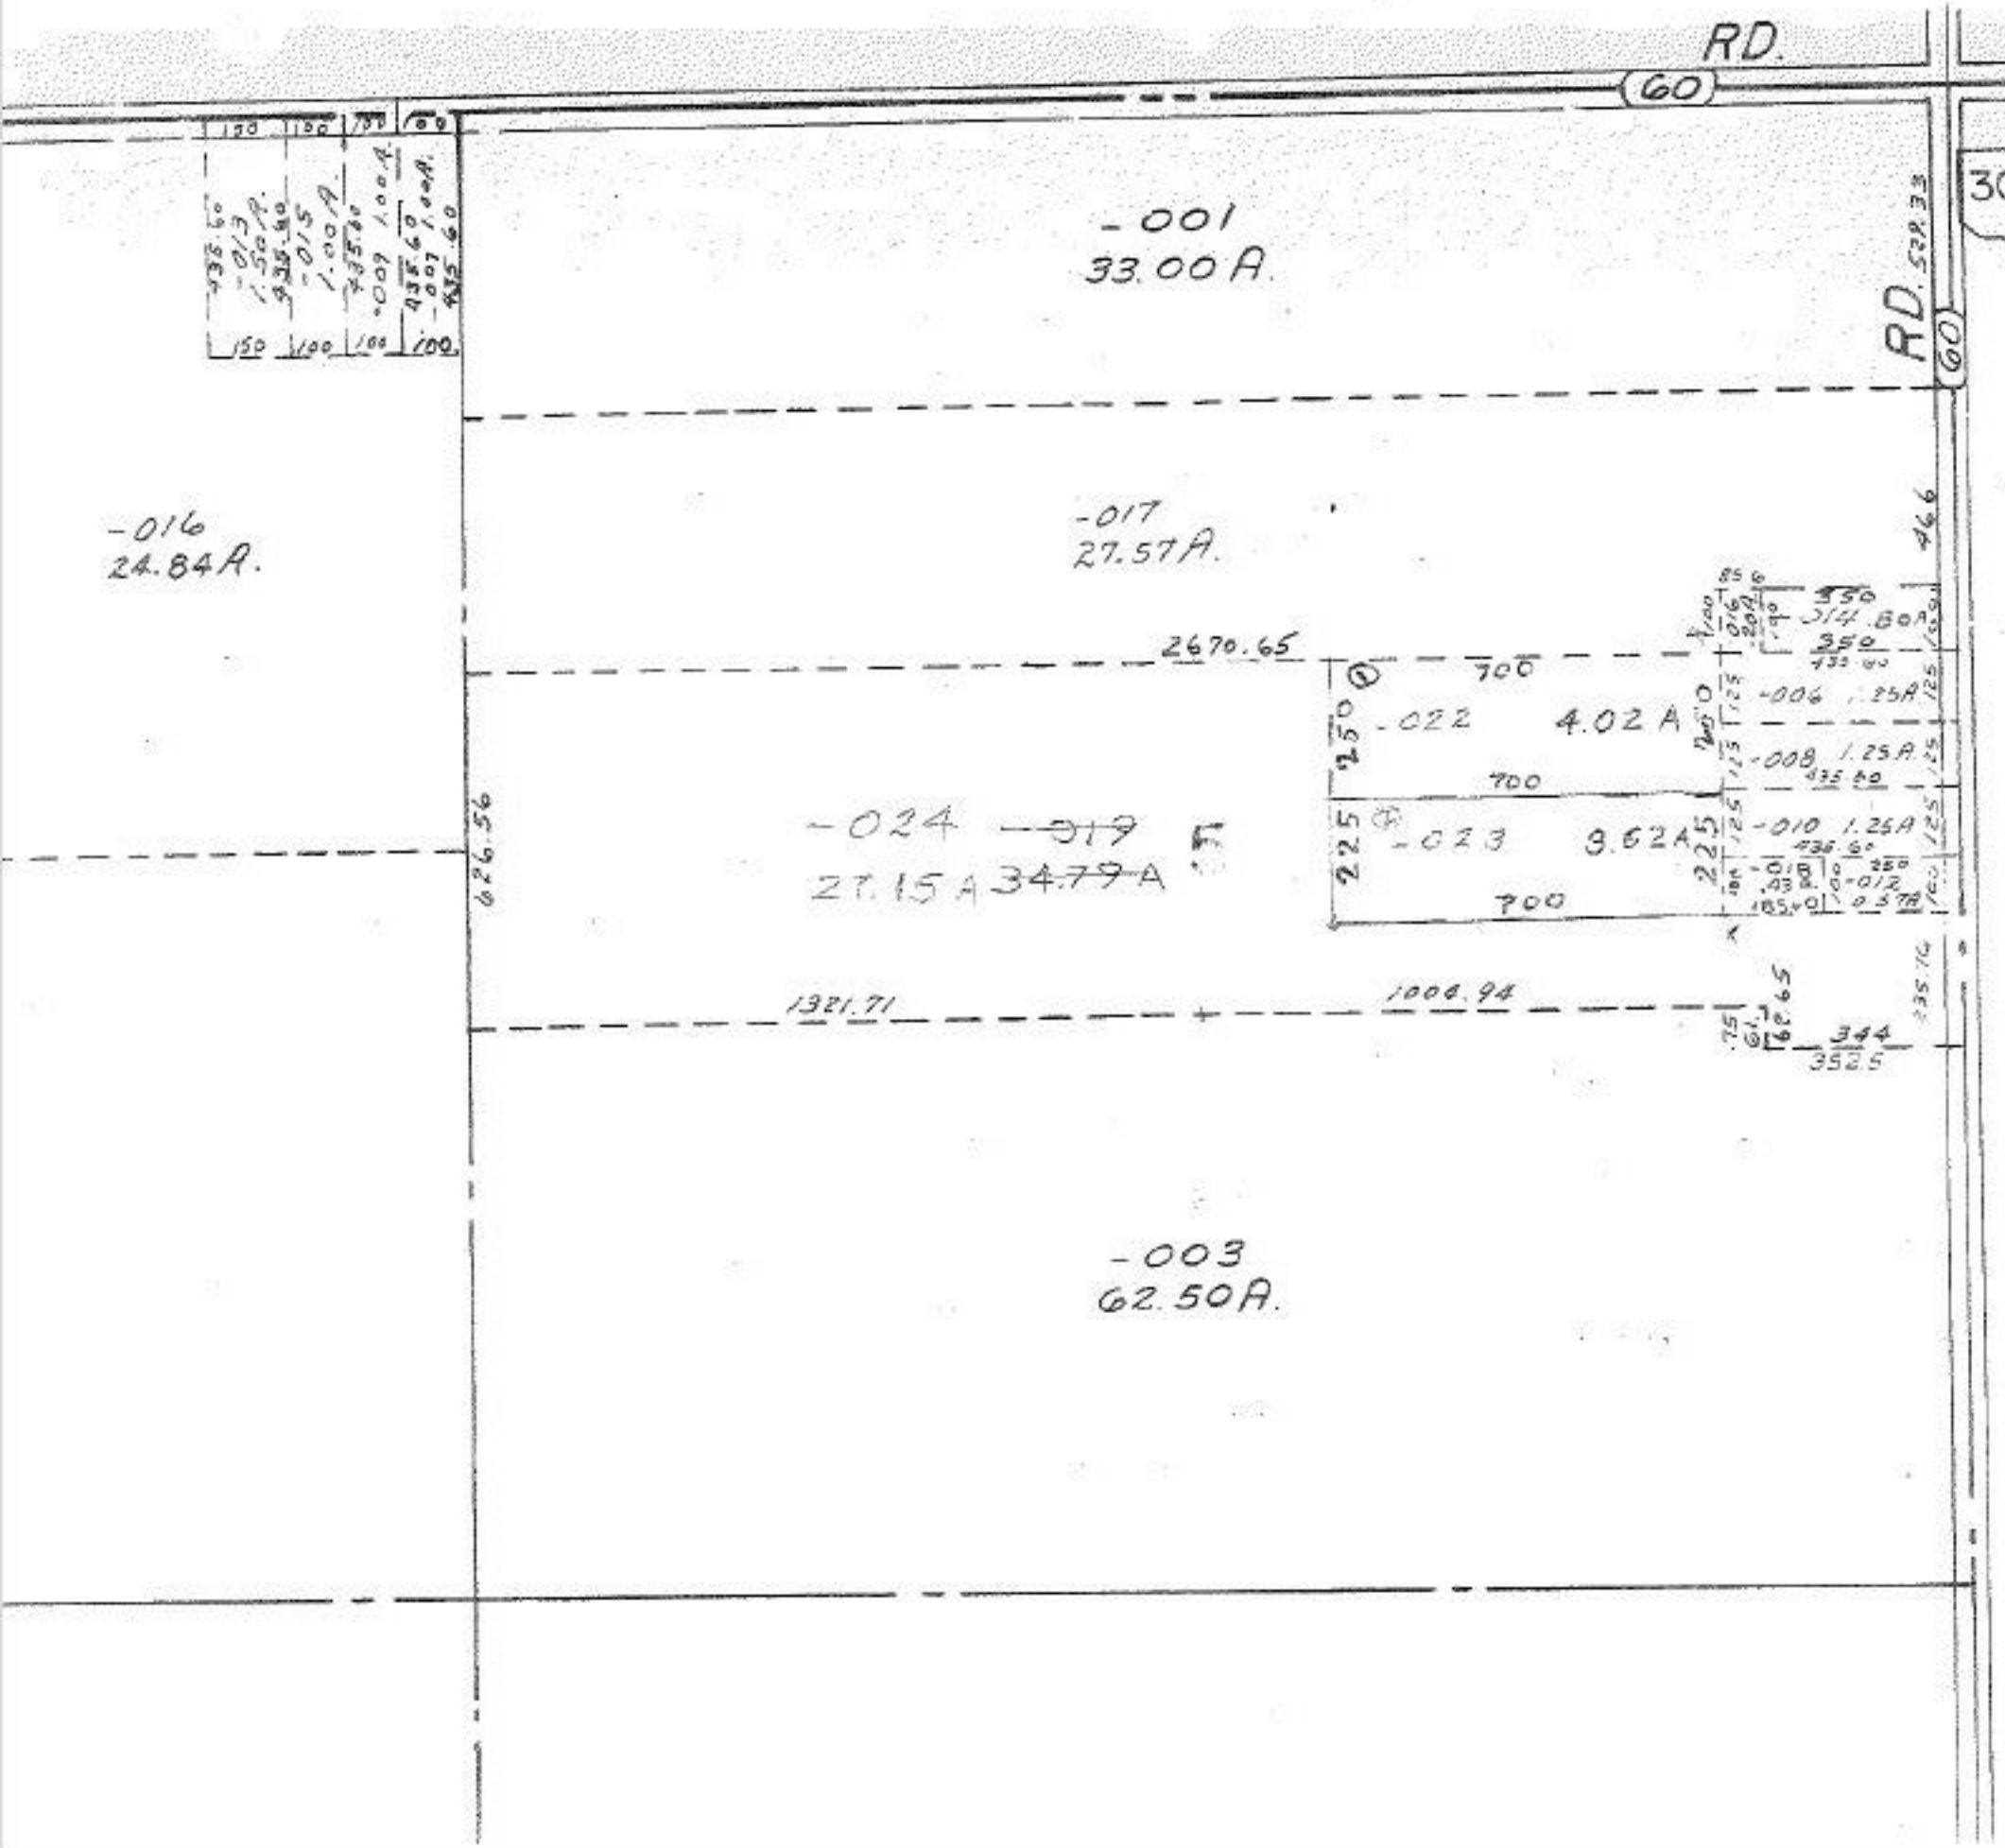

MAR 9 1979

#11812

APPROVED
LORAIN CO.
MAP DEPT.

DATE 7-7-78

PAGE 15-B

BY C. Francis

VOID AFTER 11812