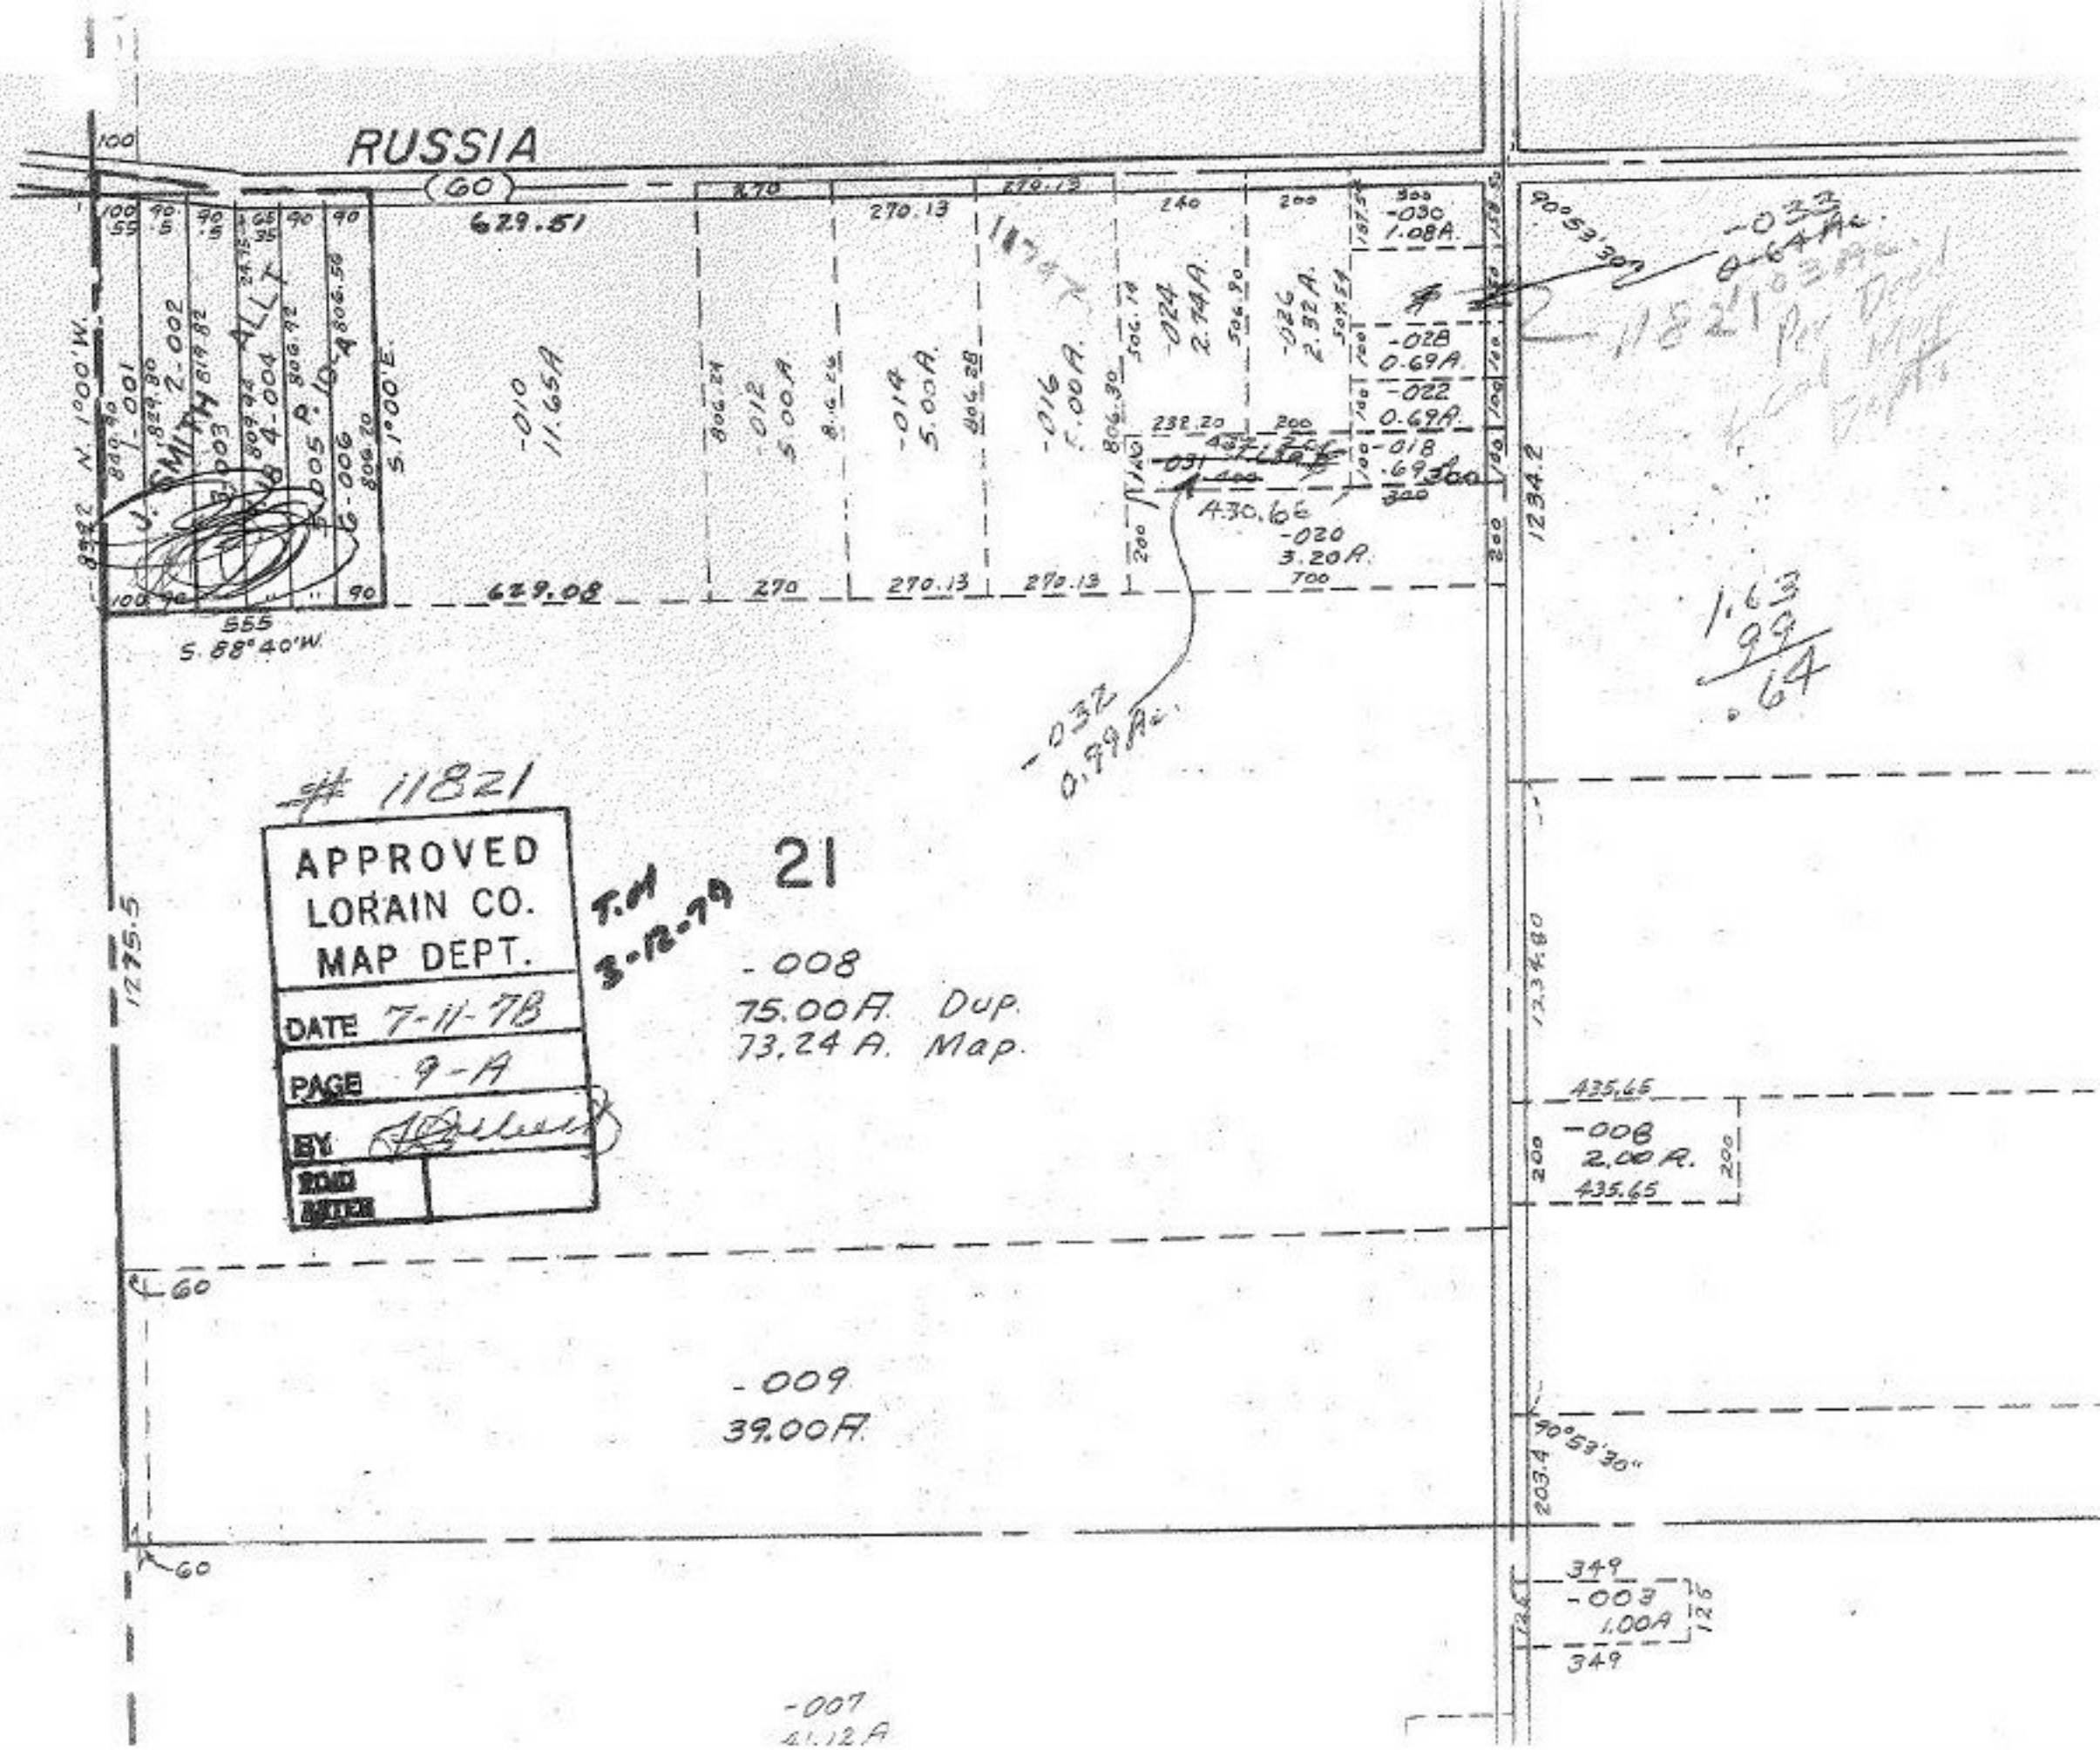
RUSSIA
(60)
629.51
629.08
270
270.13
270.13
270.13
270.13
240
200
-030
1.08A.
-028
0.69A.
-022
0.69A.
-018
.69
-024
2.74A.
-026
2.32A.
-010
11.65A
-012
5.00A.
-014
5.00A.
-016
5.00A.
-020
3.20A.
430.66
-032
0.99Ac.
-032
0.64Ac.
11821
1234.2
1.63
.99
.64
N. 1°00'W.
S. 88°40'W.
S. 1°00'E.
J. SMITH ALLT
1275.5
11821
APPROVED
LORAIN CO.
MAP DEPT.
DATE 7-11-78
PAGE 9-A
BY
ROAD
ENTER
T.M
3-12-79
21
-008
75.00A. Dup.
73.24 A. Map.
435.65
-008
2.00A.
435.65
-009
39.00A.
90°53'30"
203.4
349
-003
1.00A
349
-007
41.12A