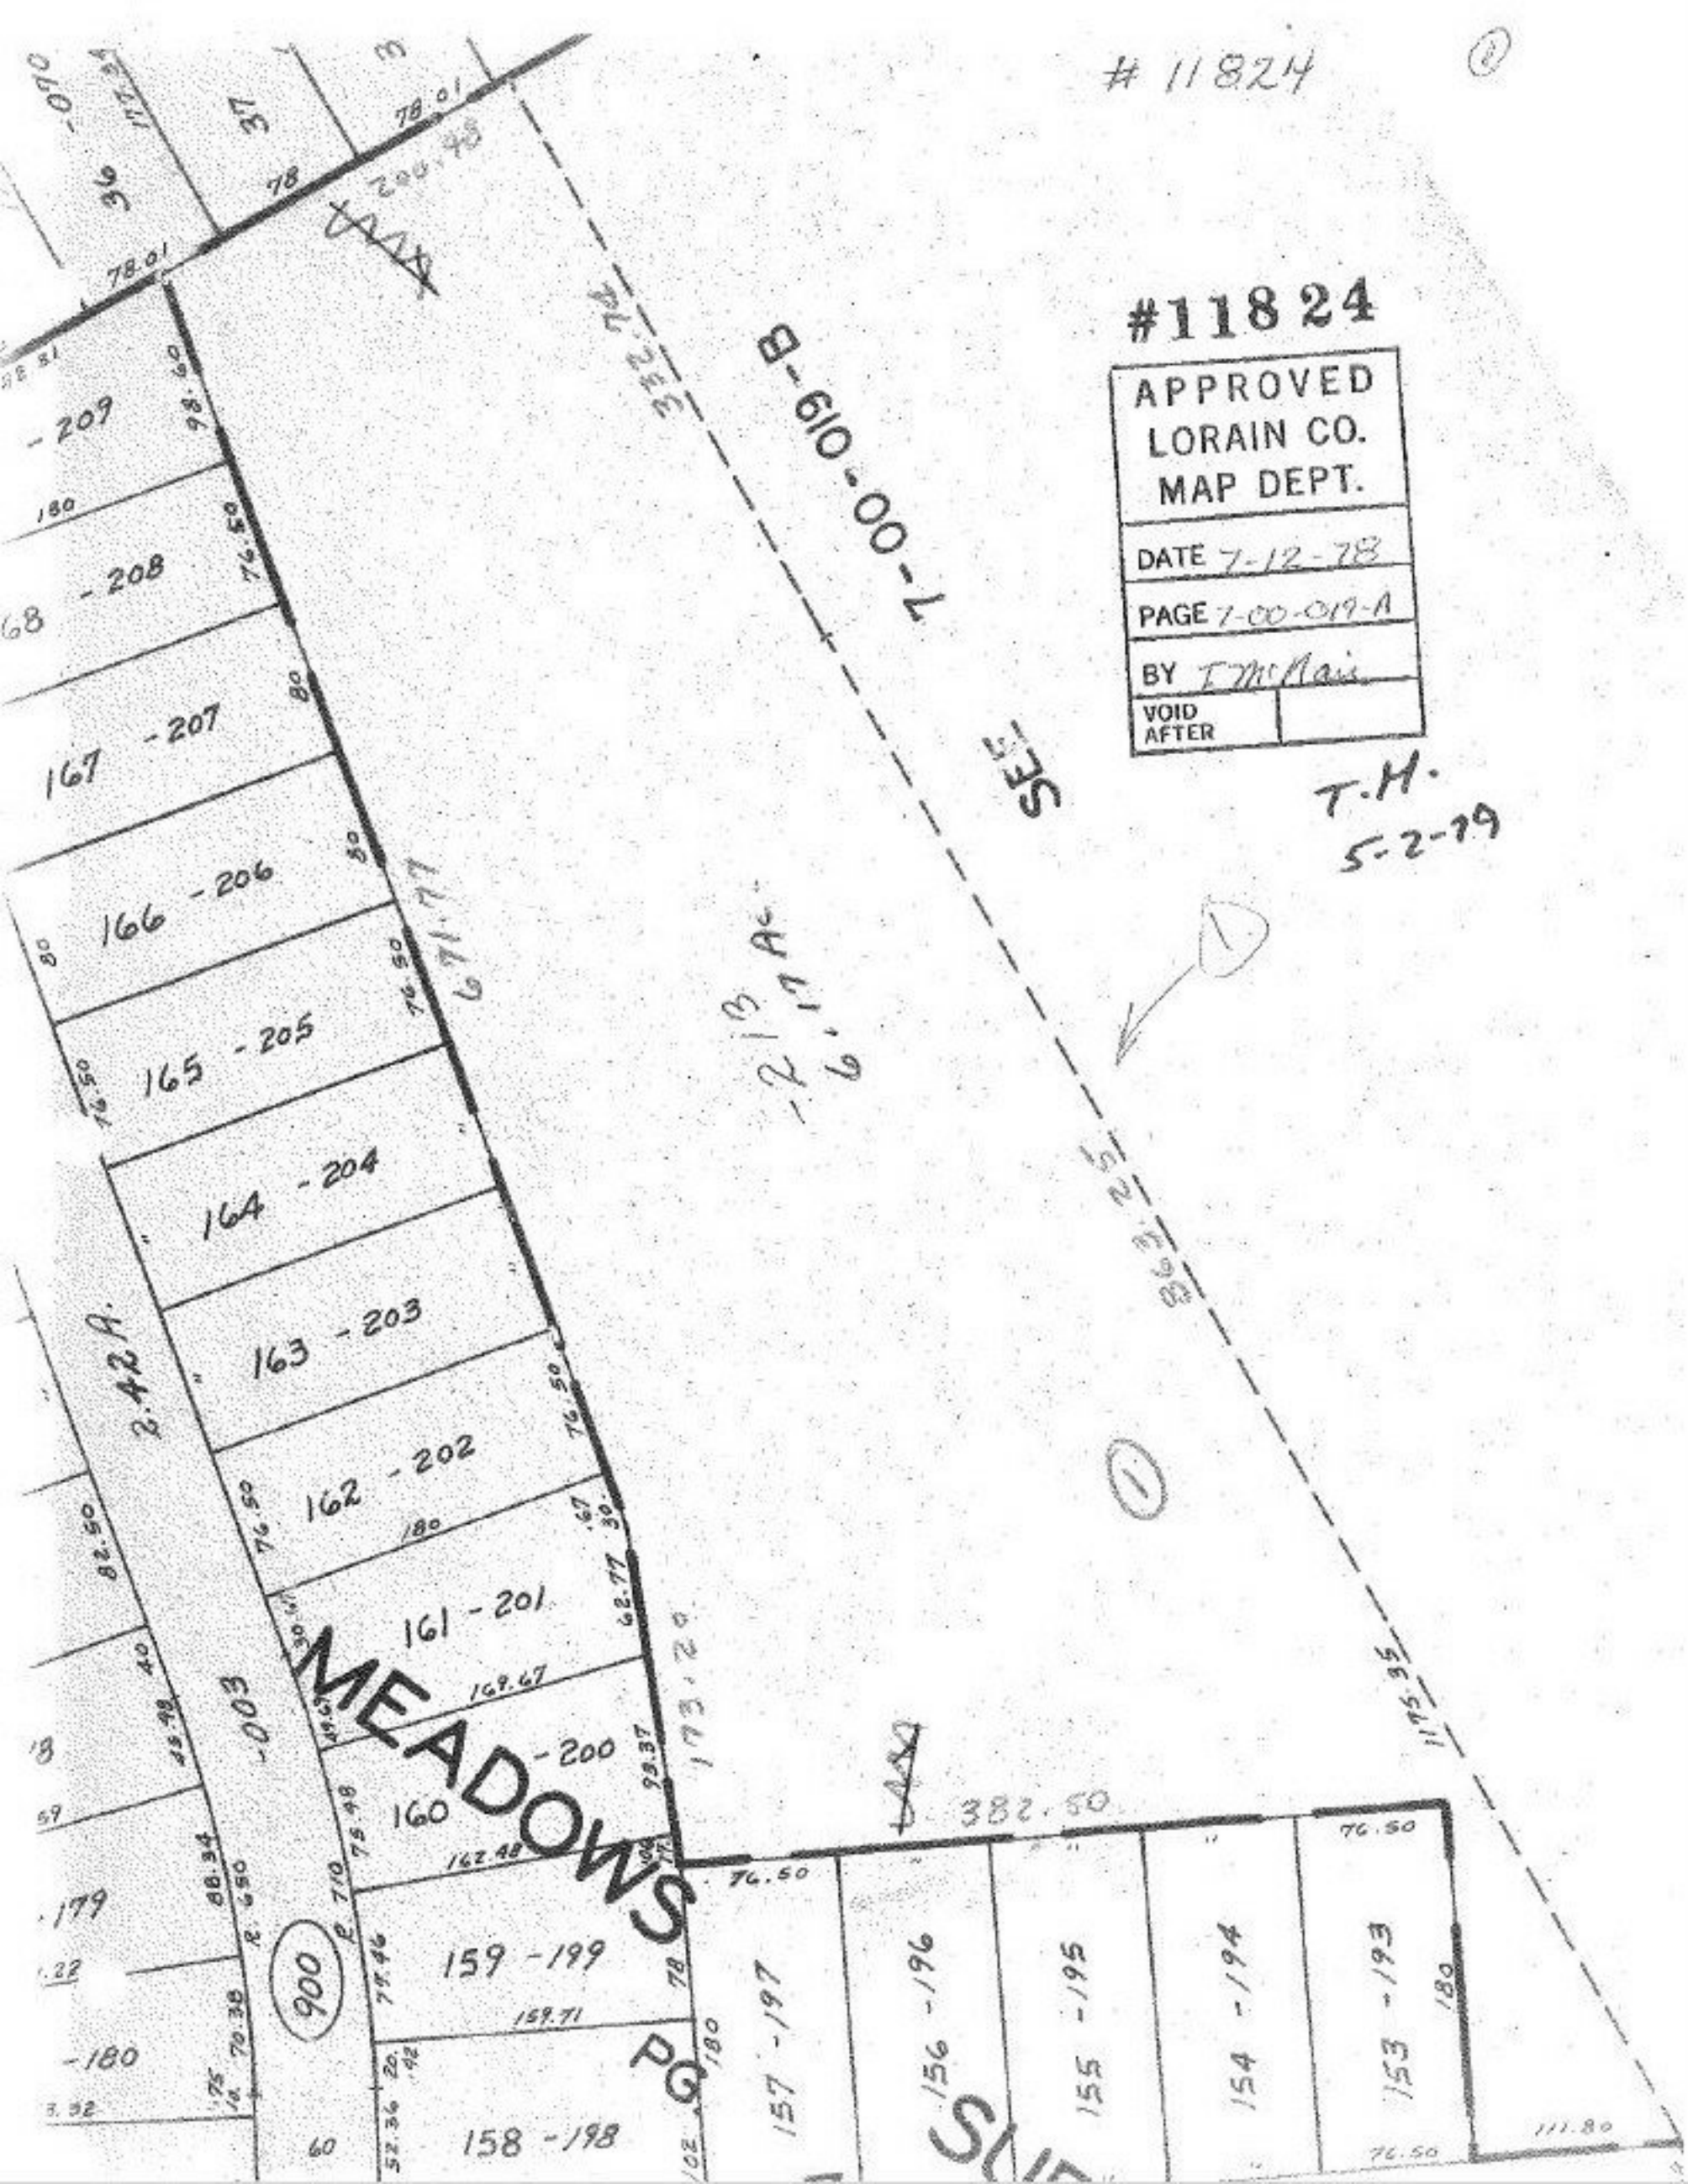

11824
#11824
APPROVED
LORAIN CO.
MAP DEPT.
DATE 7-12-78
PAGE 7-00-019-A
BY T McNair
VOID AFTER
T.H.
5-2-79
7-00-019-B
SEE
MEADOWS
PG
SUB
-209
-208
167 -207
166 -206
165 -205
164 -204
163 -203
162 -202
161 -201
160 -200
159 -199
158 -198
157 -197
156 -196
155 -195
154 -194
153 -193
2.42 A.
-003
900
382.50
173.20
863.25
1175.35
332.74
671.77