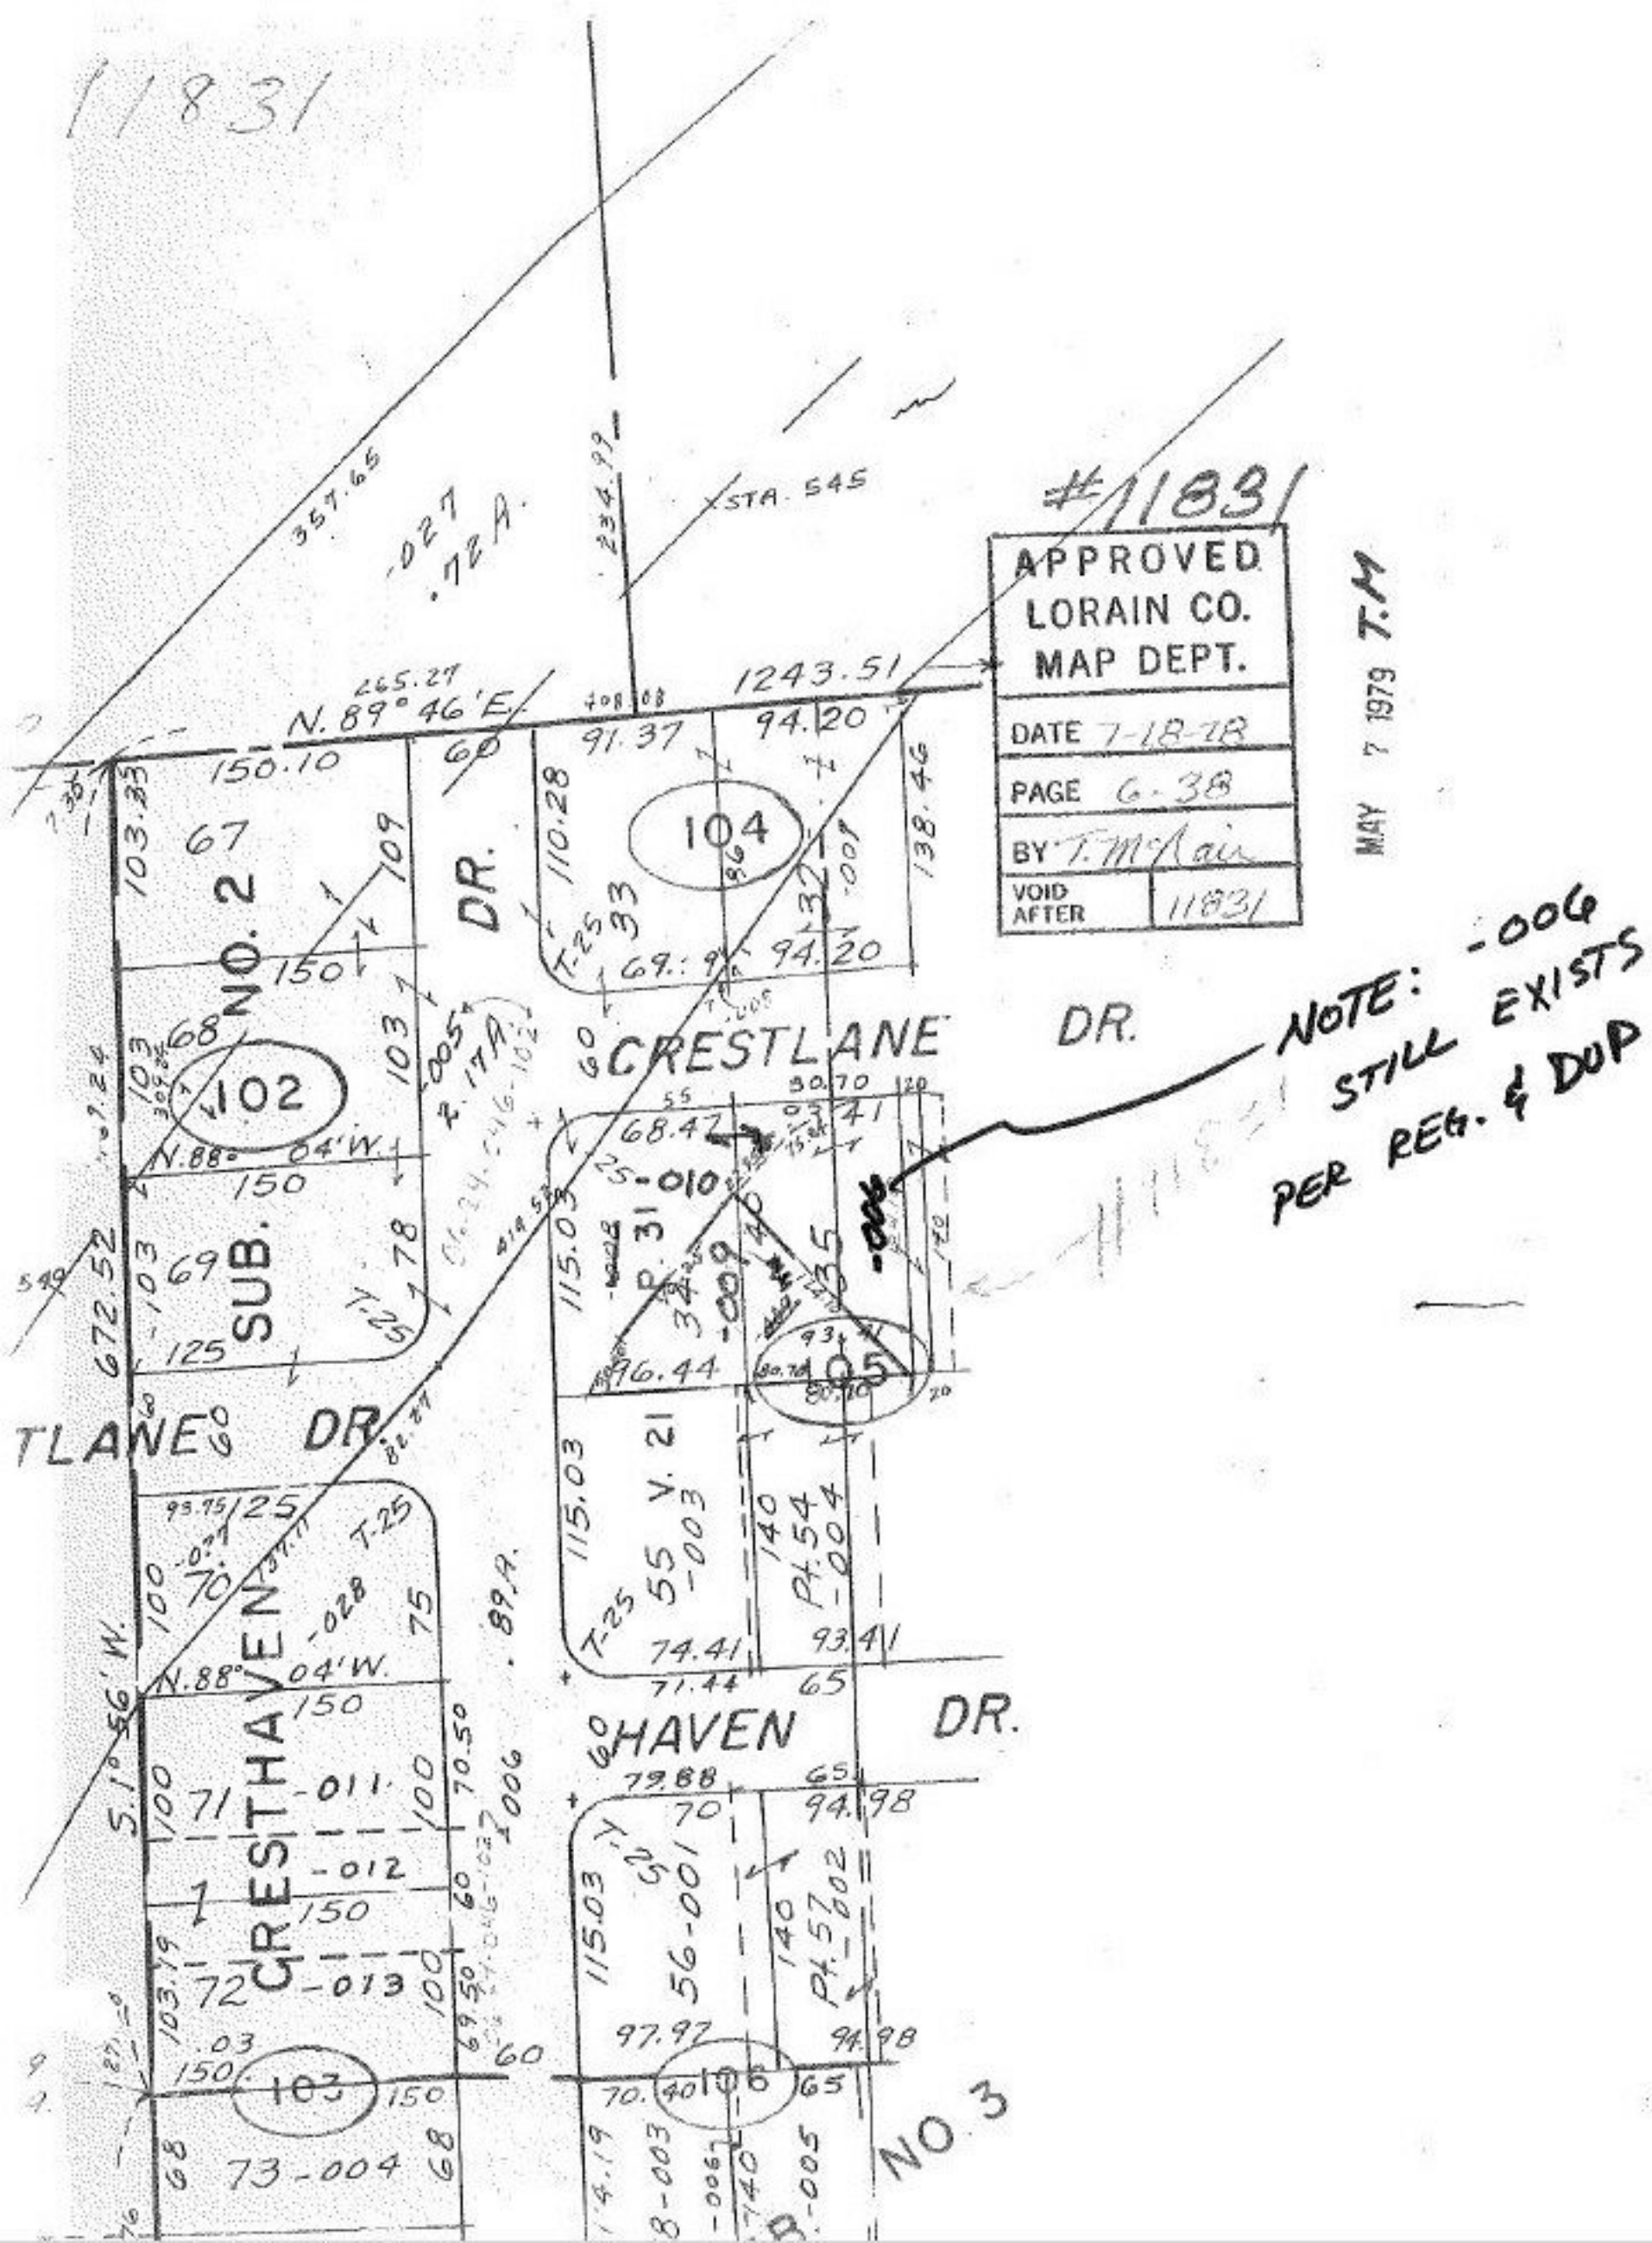
11831
#11831
APPROVED
LORAIN CO.
MAP DEPT.
DATE 7-18-78
PAGE 6-38
BY T. McLain
VOID AFTER 11831
MAY 7 1979 T.M
NOTE: -006 STILL EXISTS PER REG. & DUP
STA. 545
N. 89° 46' E.
1243.51
CRESTLANE DR.
CRESTLANE DR.
CRESTHAVEN DR.
HAVEN DR.
NO. 2 SUB.
NO 3
N. 88° 04' W.
S. 1° 56' W.
104
102
105
106
103
67
68
69
70
71
72
73-004
55 V. 21 -003
Pt. 54 -004
56-001
Pt. 57 -002
-010
-011
-012
-013
P. 31
T-25
357.65
234.99
265.27
150.10
91.37
94.20
138.46
110.28
115.03
68.47
96.44
74.41
71.44
79.88
97.97
672.52