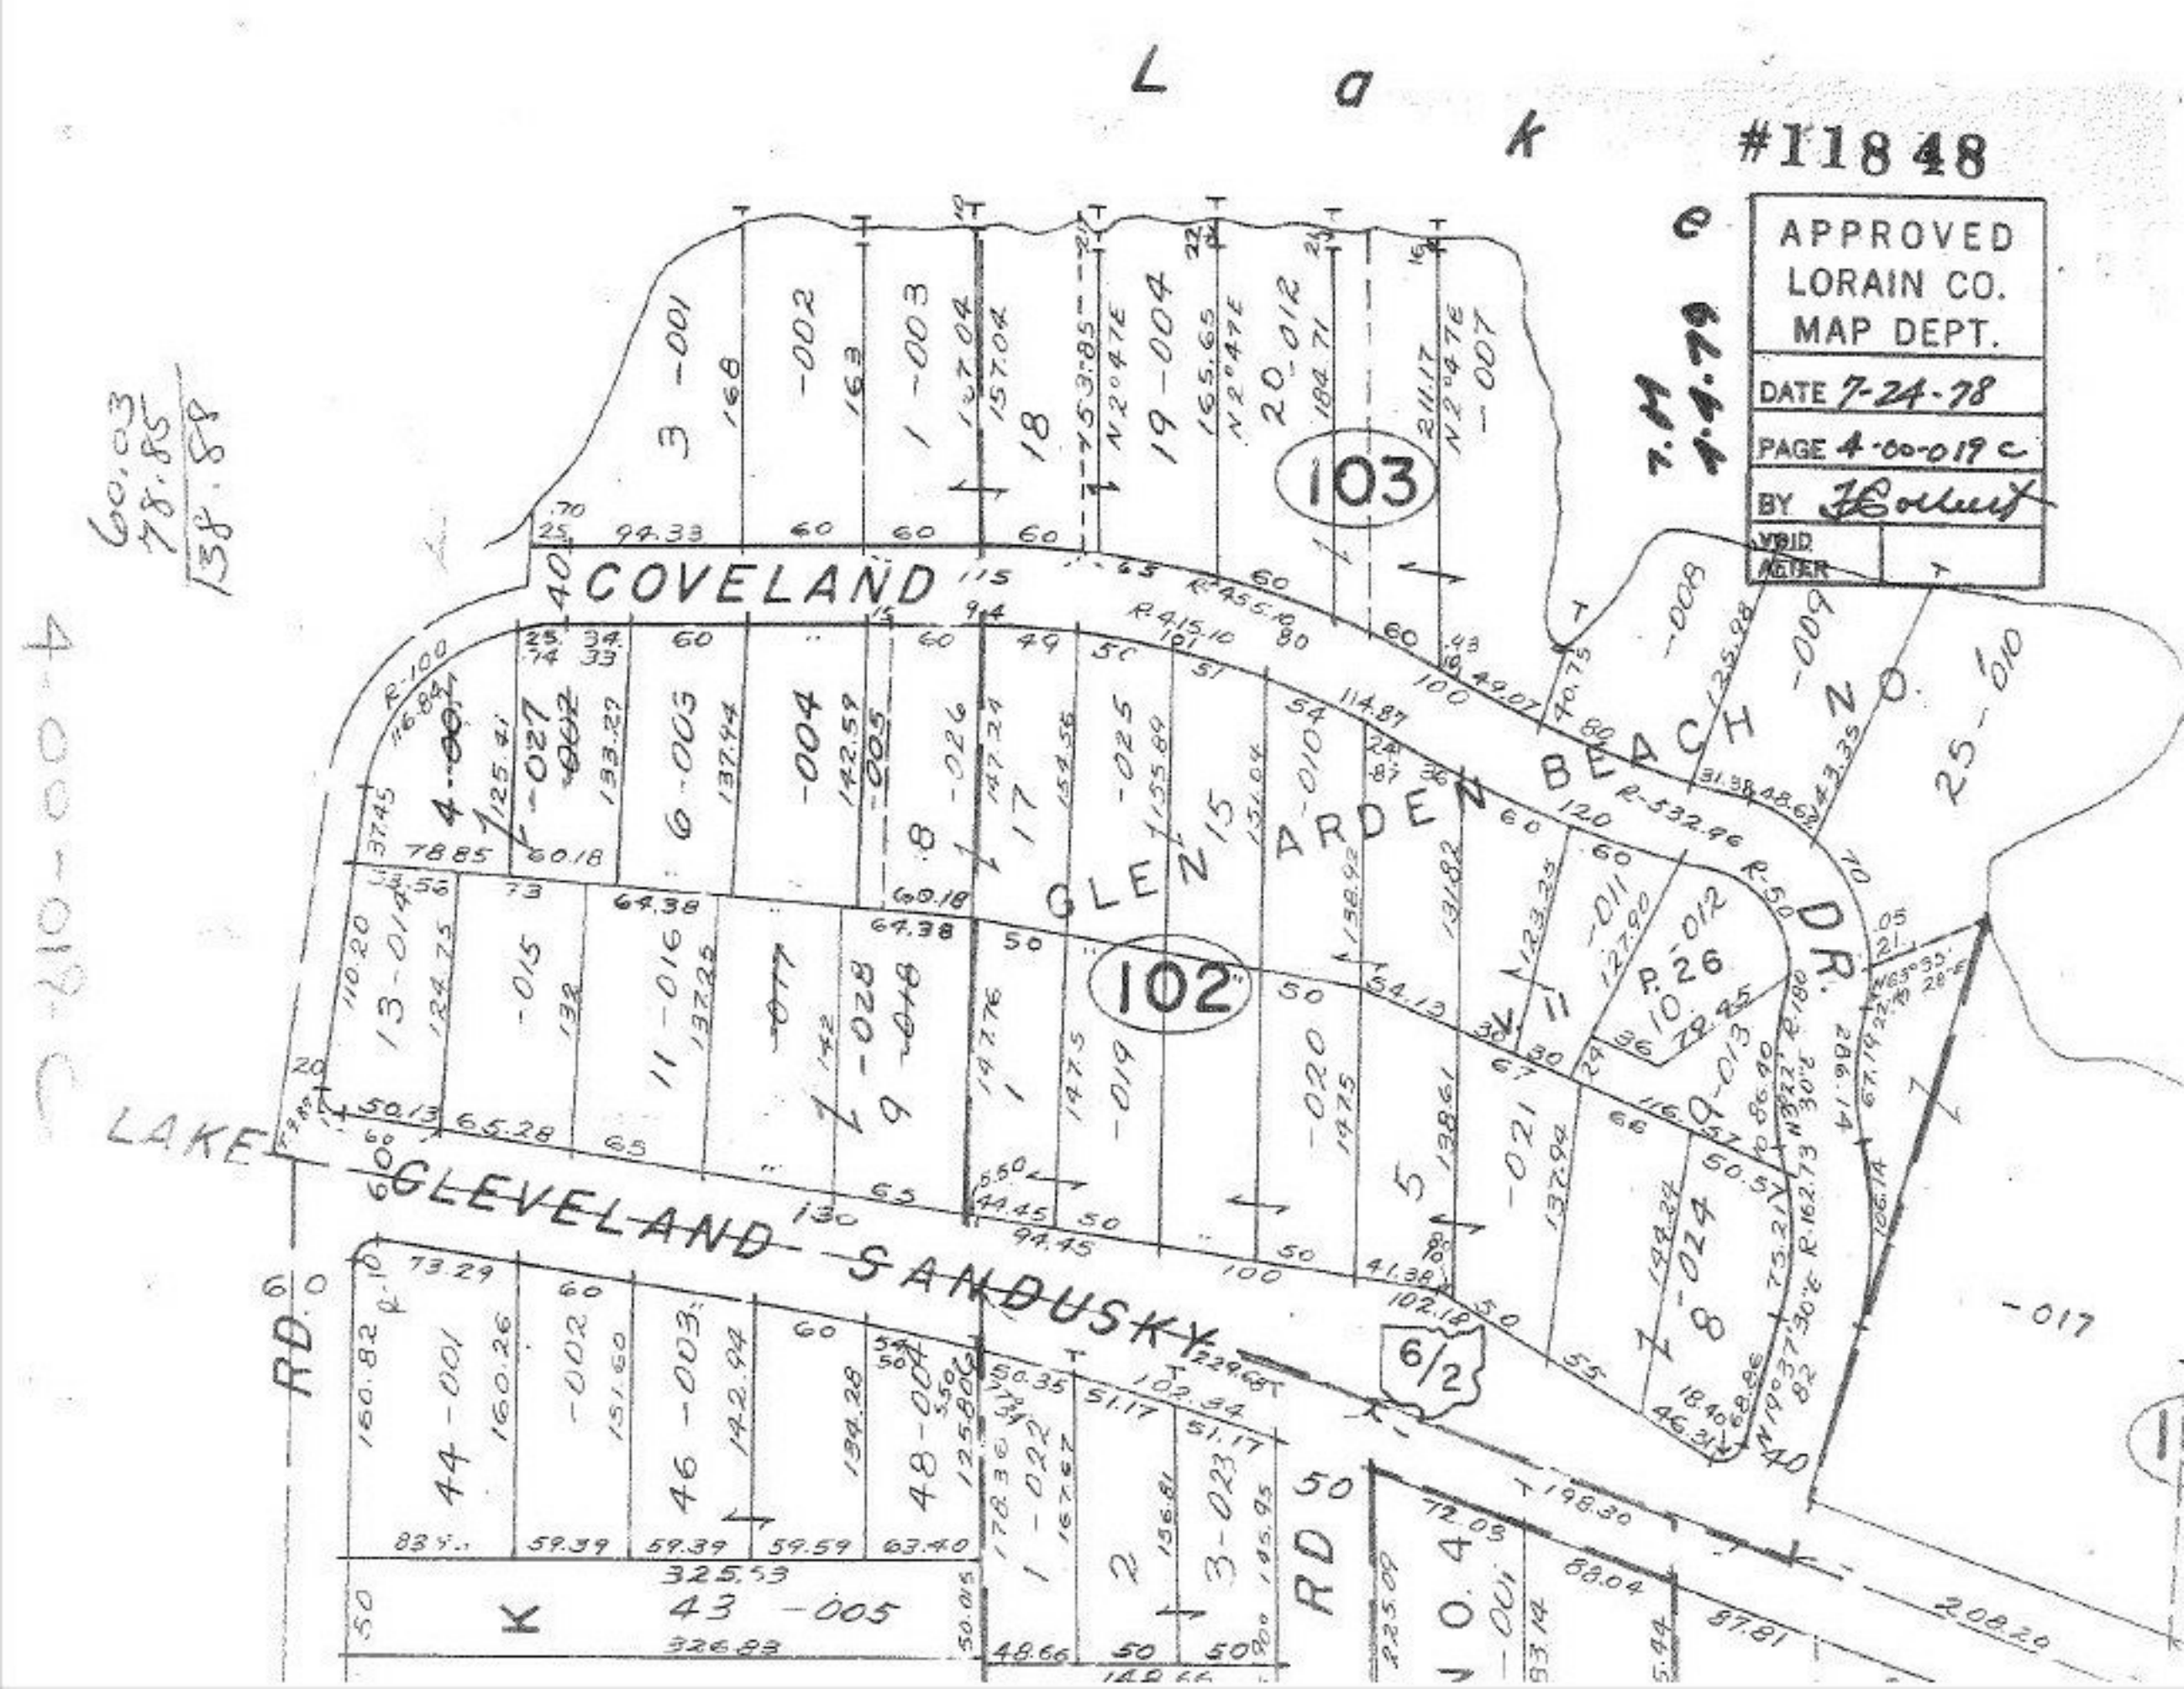

Lake
#11848
APPROVED
LORAIN CO.
MAP DEPT.
DATE 7-24-78
PAGE 4-00-019 C
BY
VOID
AFTER
COVELAND
GLEN ARDEN BEACH NO. 1
GLEVELAND SANDUSKY
LAKE
DR.
RD.
103
102
6/2
60.03
78.85
138.88
4-00-019-C