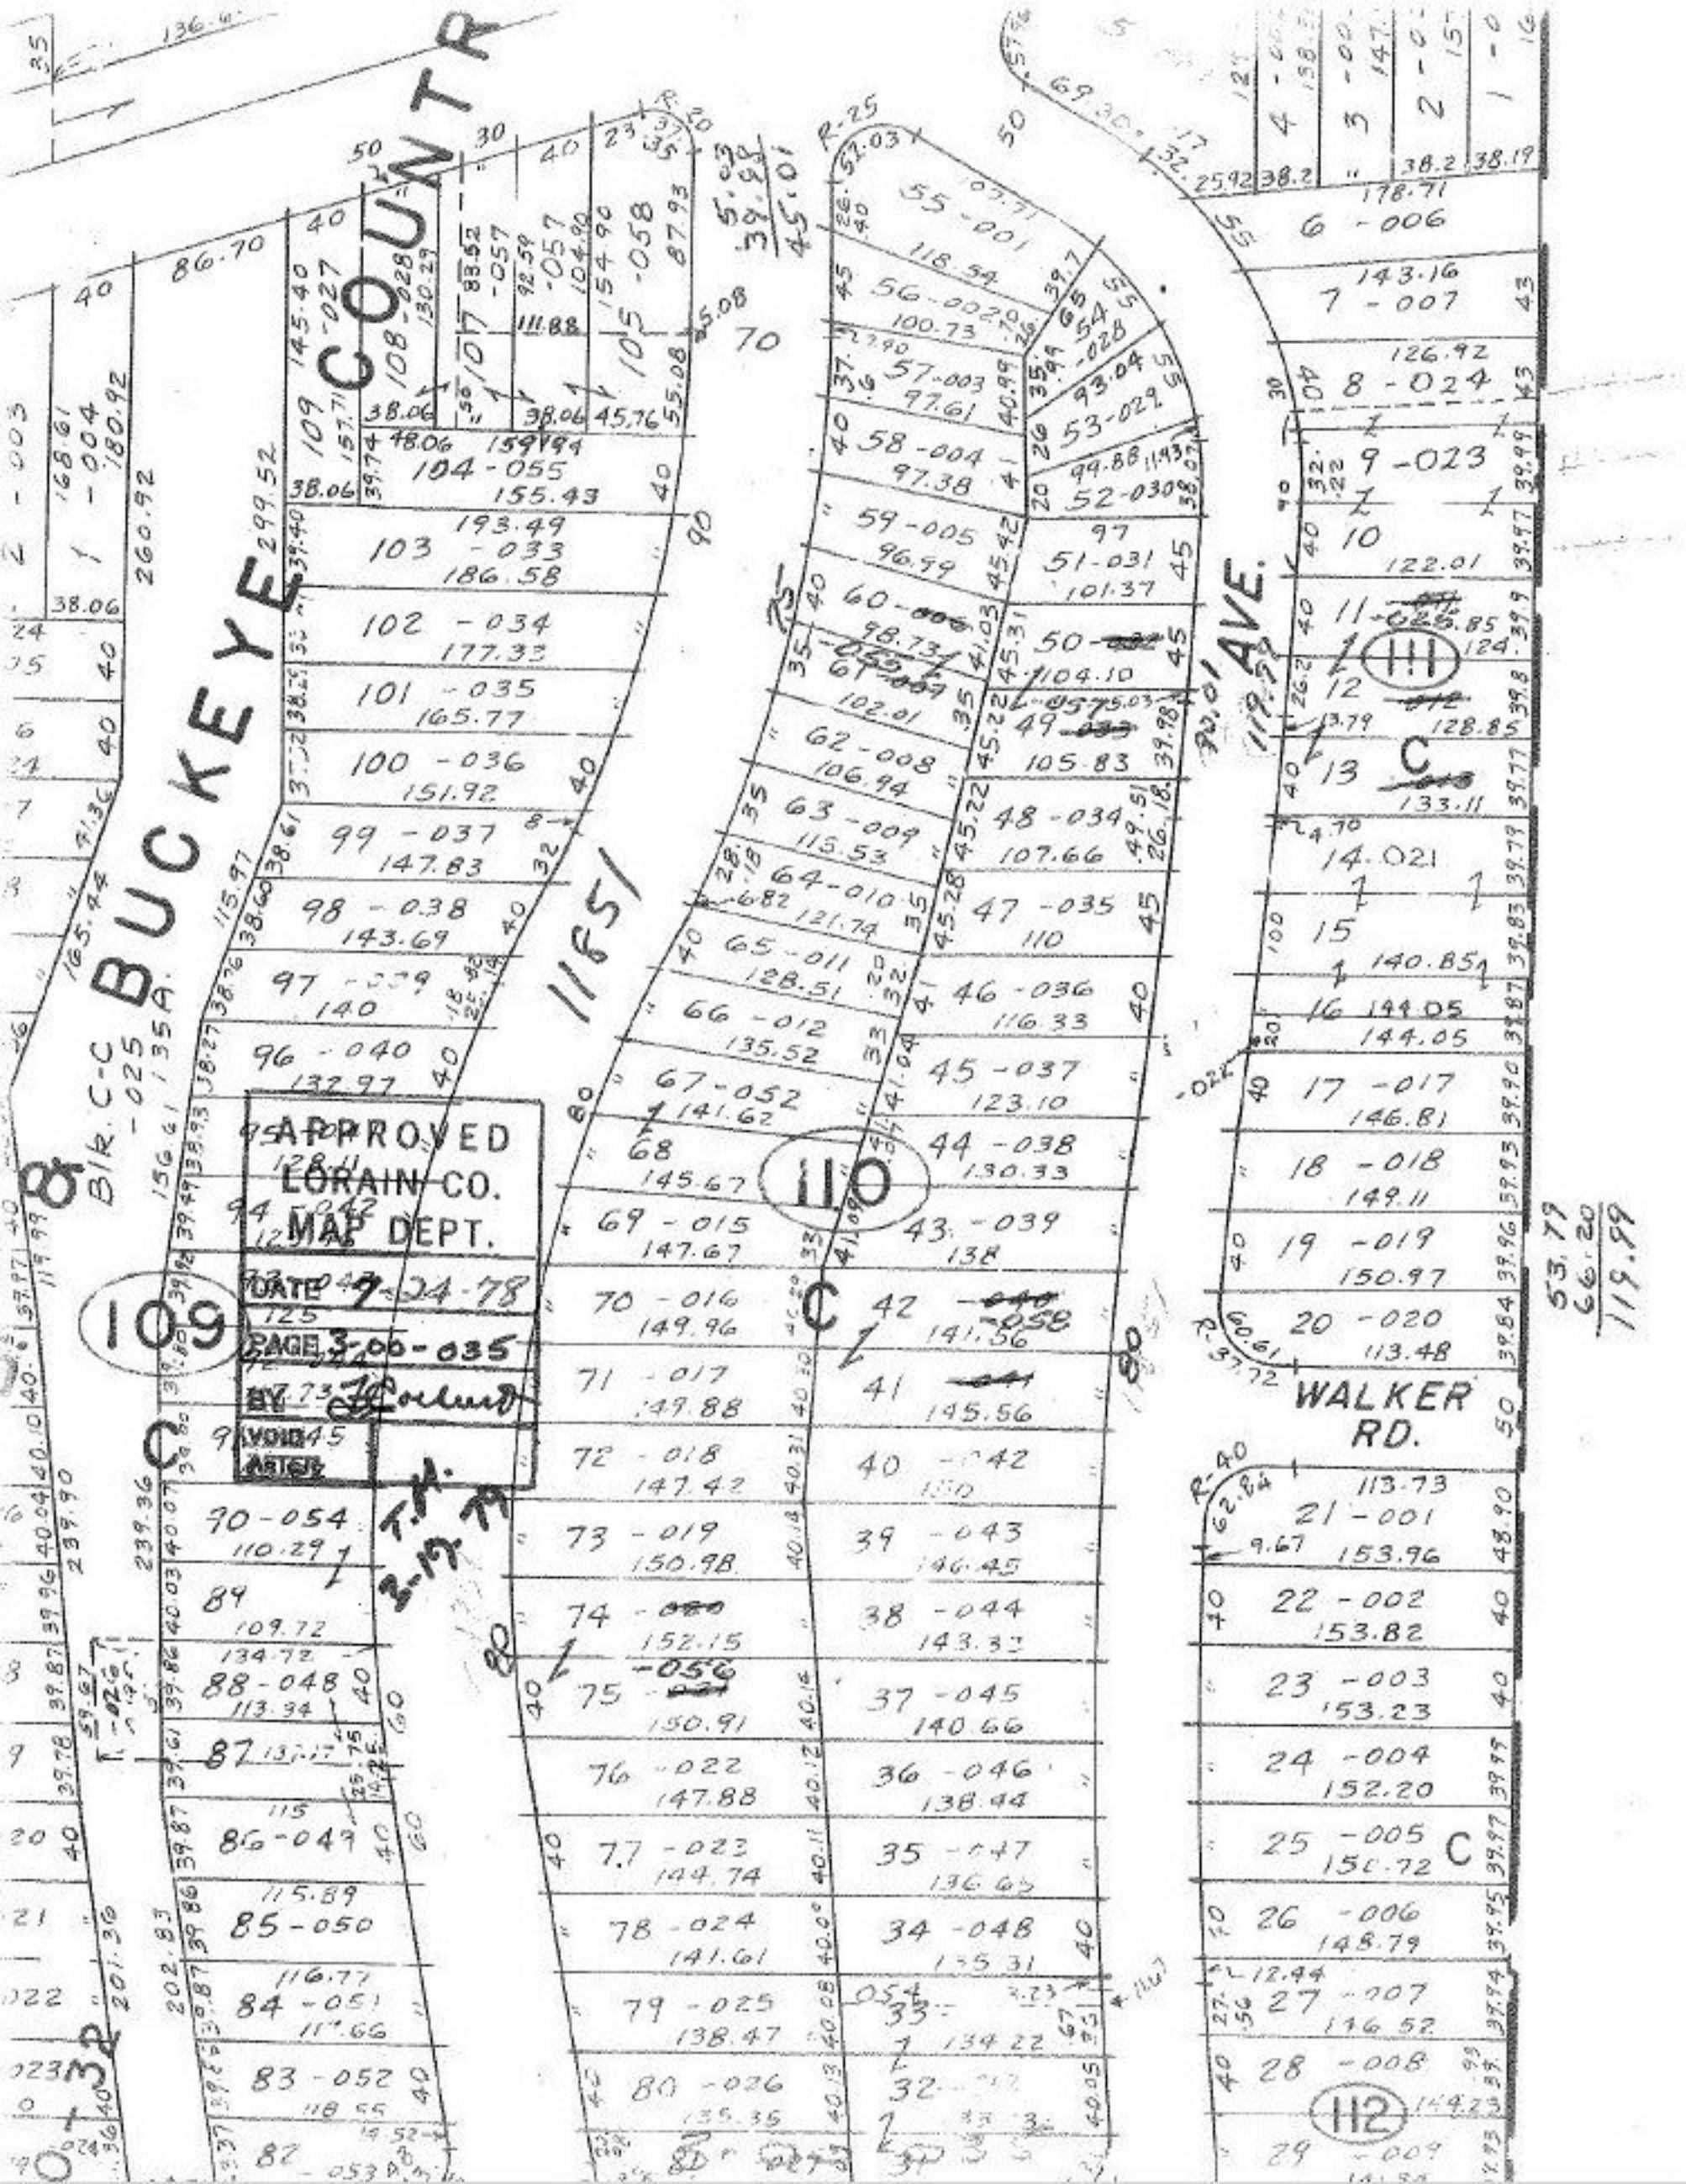

BUCKEYE COUNTR
AVE.
WALKER RD.
APPROVED
LORAIN CO.
MAP DEPT.
DATE 7-24-78
PAGE 3-00-035
BY
VOID
ASTER
109
110
111
112