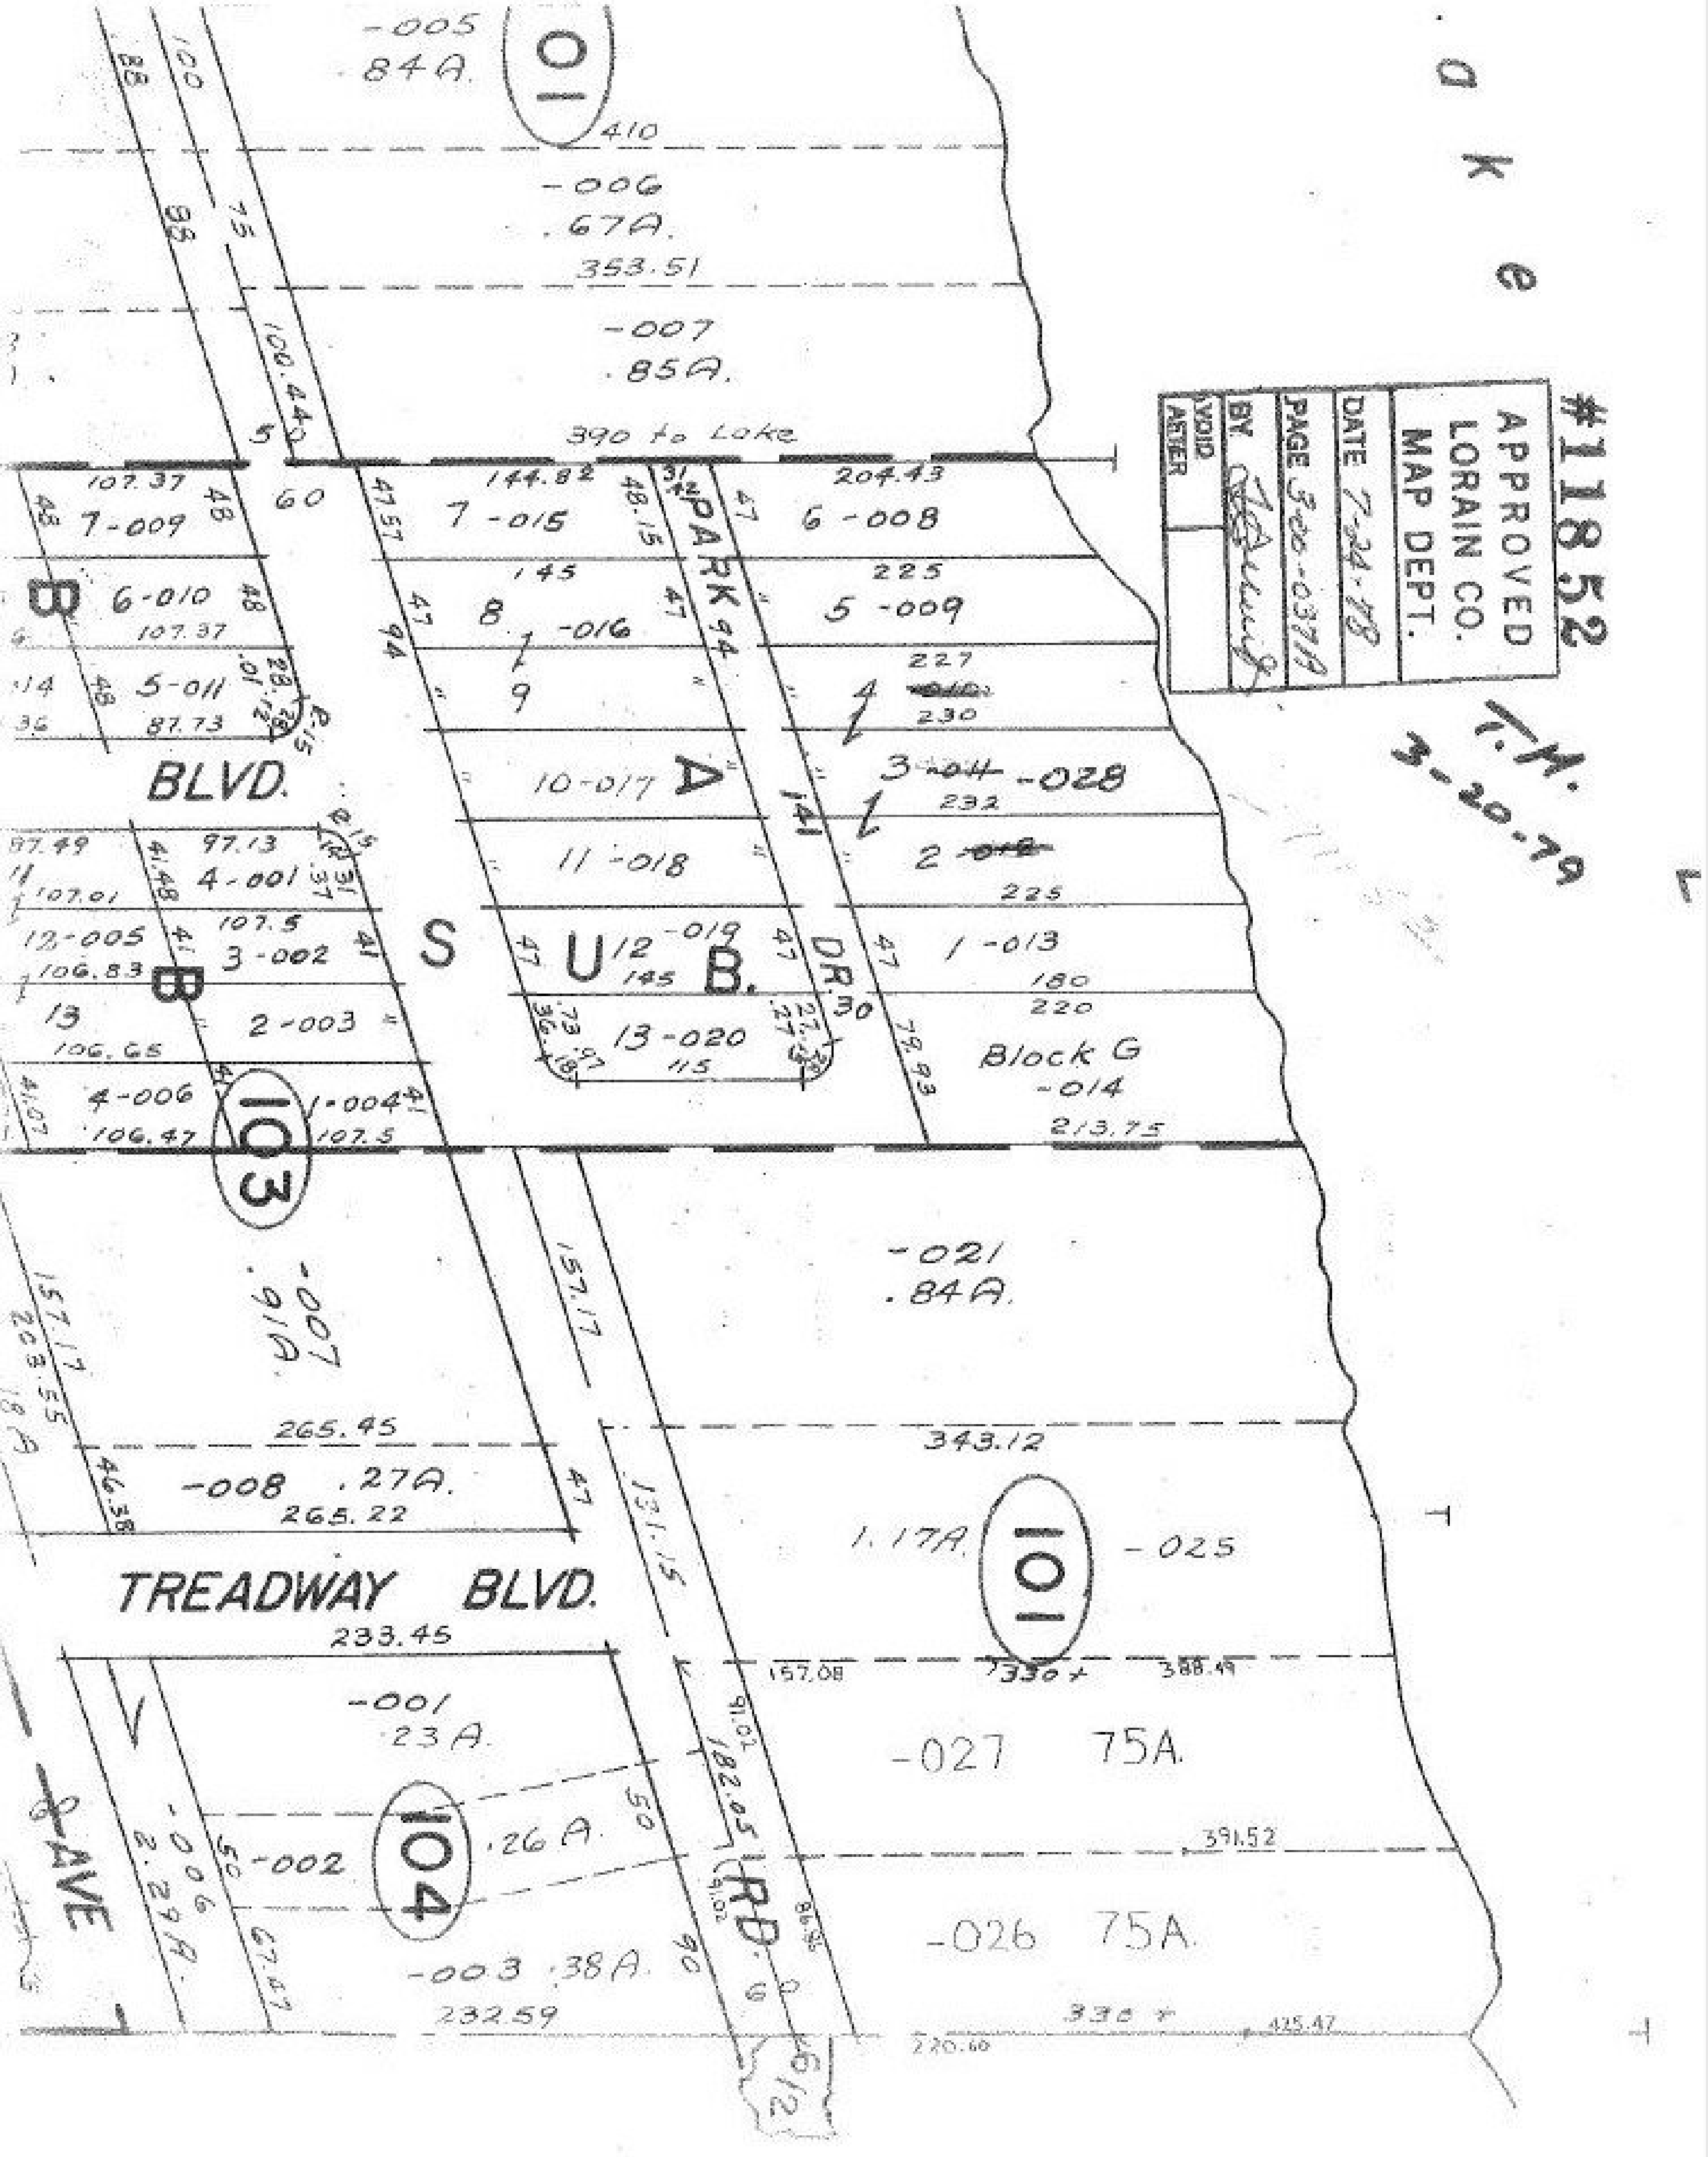
#118.52
APPROVED
LORAIN CO.
MAP DEPT.
DATE 7-24-78
PAGE 300-037A
BY
VOID
AFTER
T.H.
3-20-79
Lake
-005
.84A.
101
410
-006
.67A.
353.51
-007
.85A.
390 to Lake
107.37
7-009
6-010
5-011
87.73
60
144.82
7 -015
145
8 -016
9
10-017
A
11-018
12 -019
145
13-020
115
PARK
DR.
141
204.43
6 -008
225
5 -009
227
230
4
3 -028
232
2
225
1 -013
180
220
Block G
-014
213.75
BLVD.
97.13
4-001
107.5
3-002
2-003
1-004
4-006
106.47
107.5
103
S U B.
B
-021
.84A.
-007
.91A.
157.17
265.45
-008 .27A.
265.22
343.12
1.17A.
101
-025
TREADWAY BLVD.
233.45
157.08
330±
388.49
-001
.23A.
104
-002
.26A.
-003 .38A.
232.59
-006
2.29A.
AVE
RD.
-027 75A.
391.52
-026 75A.
338±
425.47
220.60