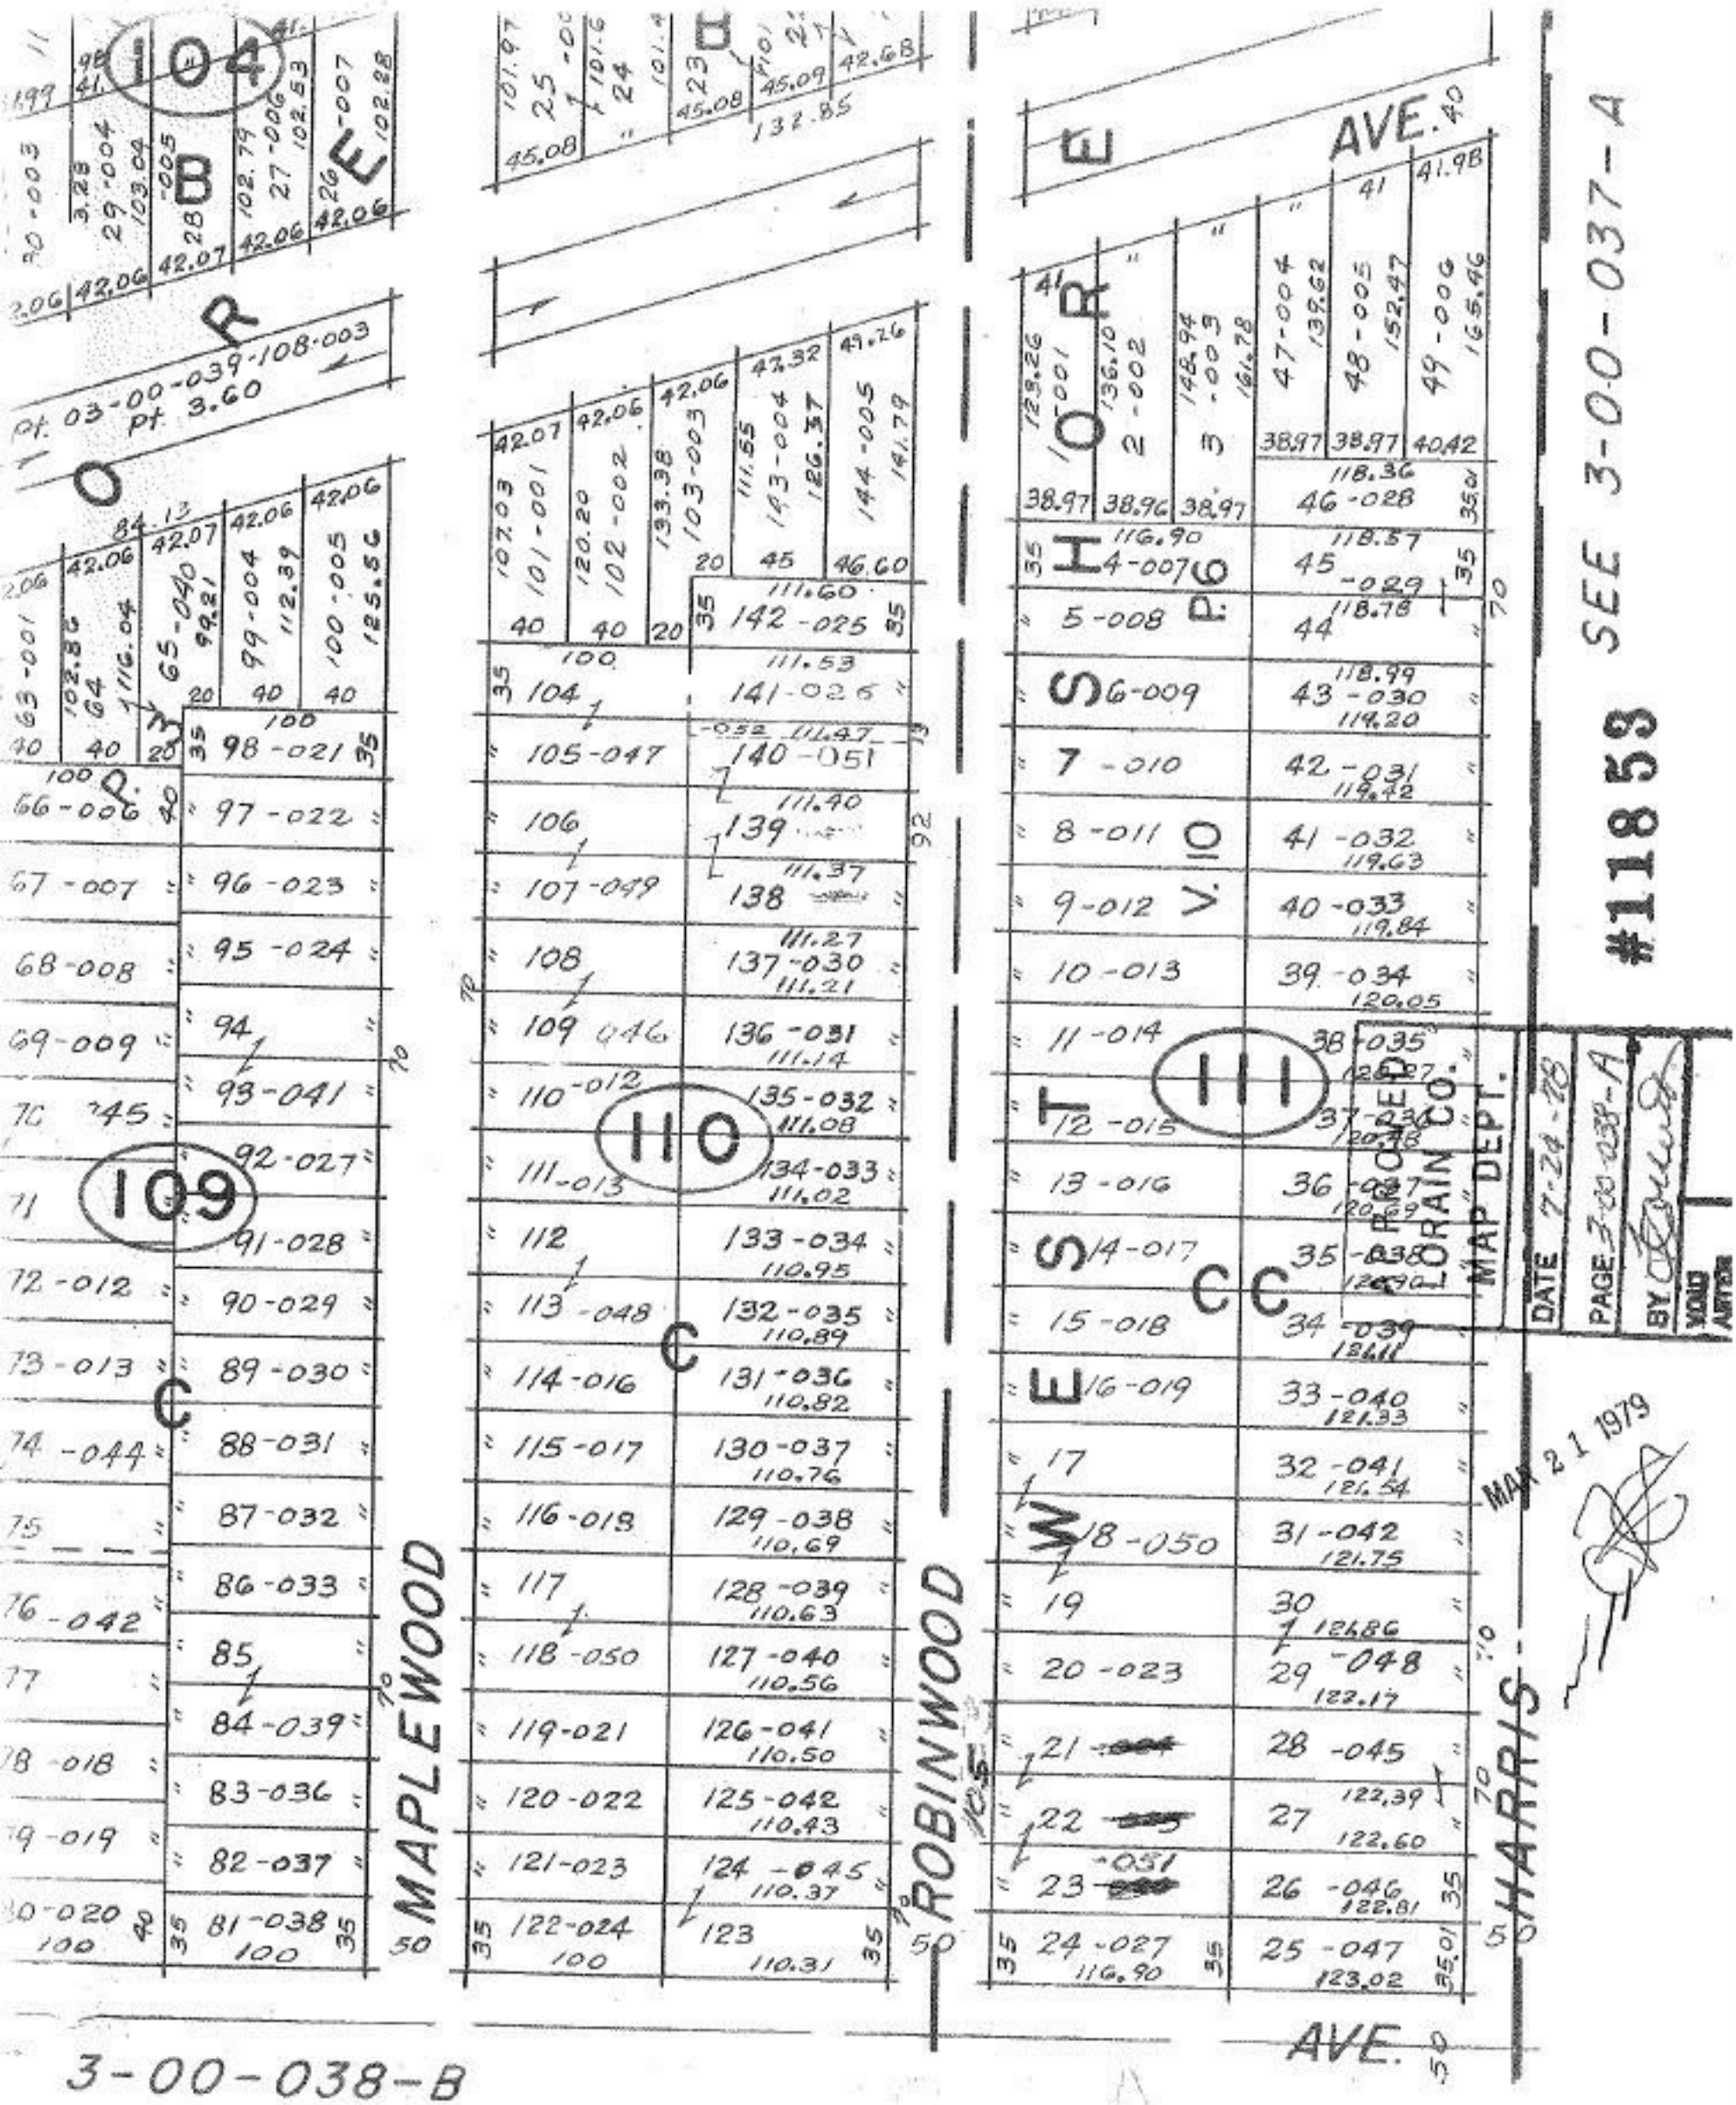

104
109
110
111
MAPLEWOOD
ROBINWOOD
HARRIS
AVE.
SEE 3-00-037-A
#11853
3-00-038-B
MAP DEPT.
DATE 7-24-78
PAGE 3-00-038-A
BY
VOID AFTER
MAR 21 1979