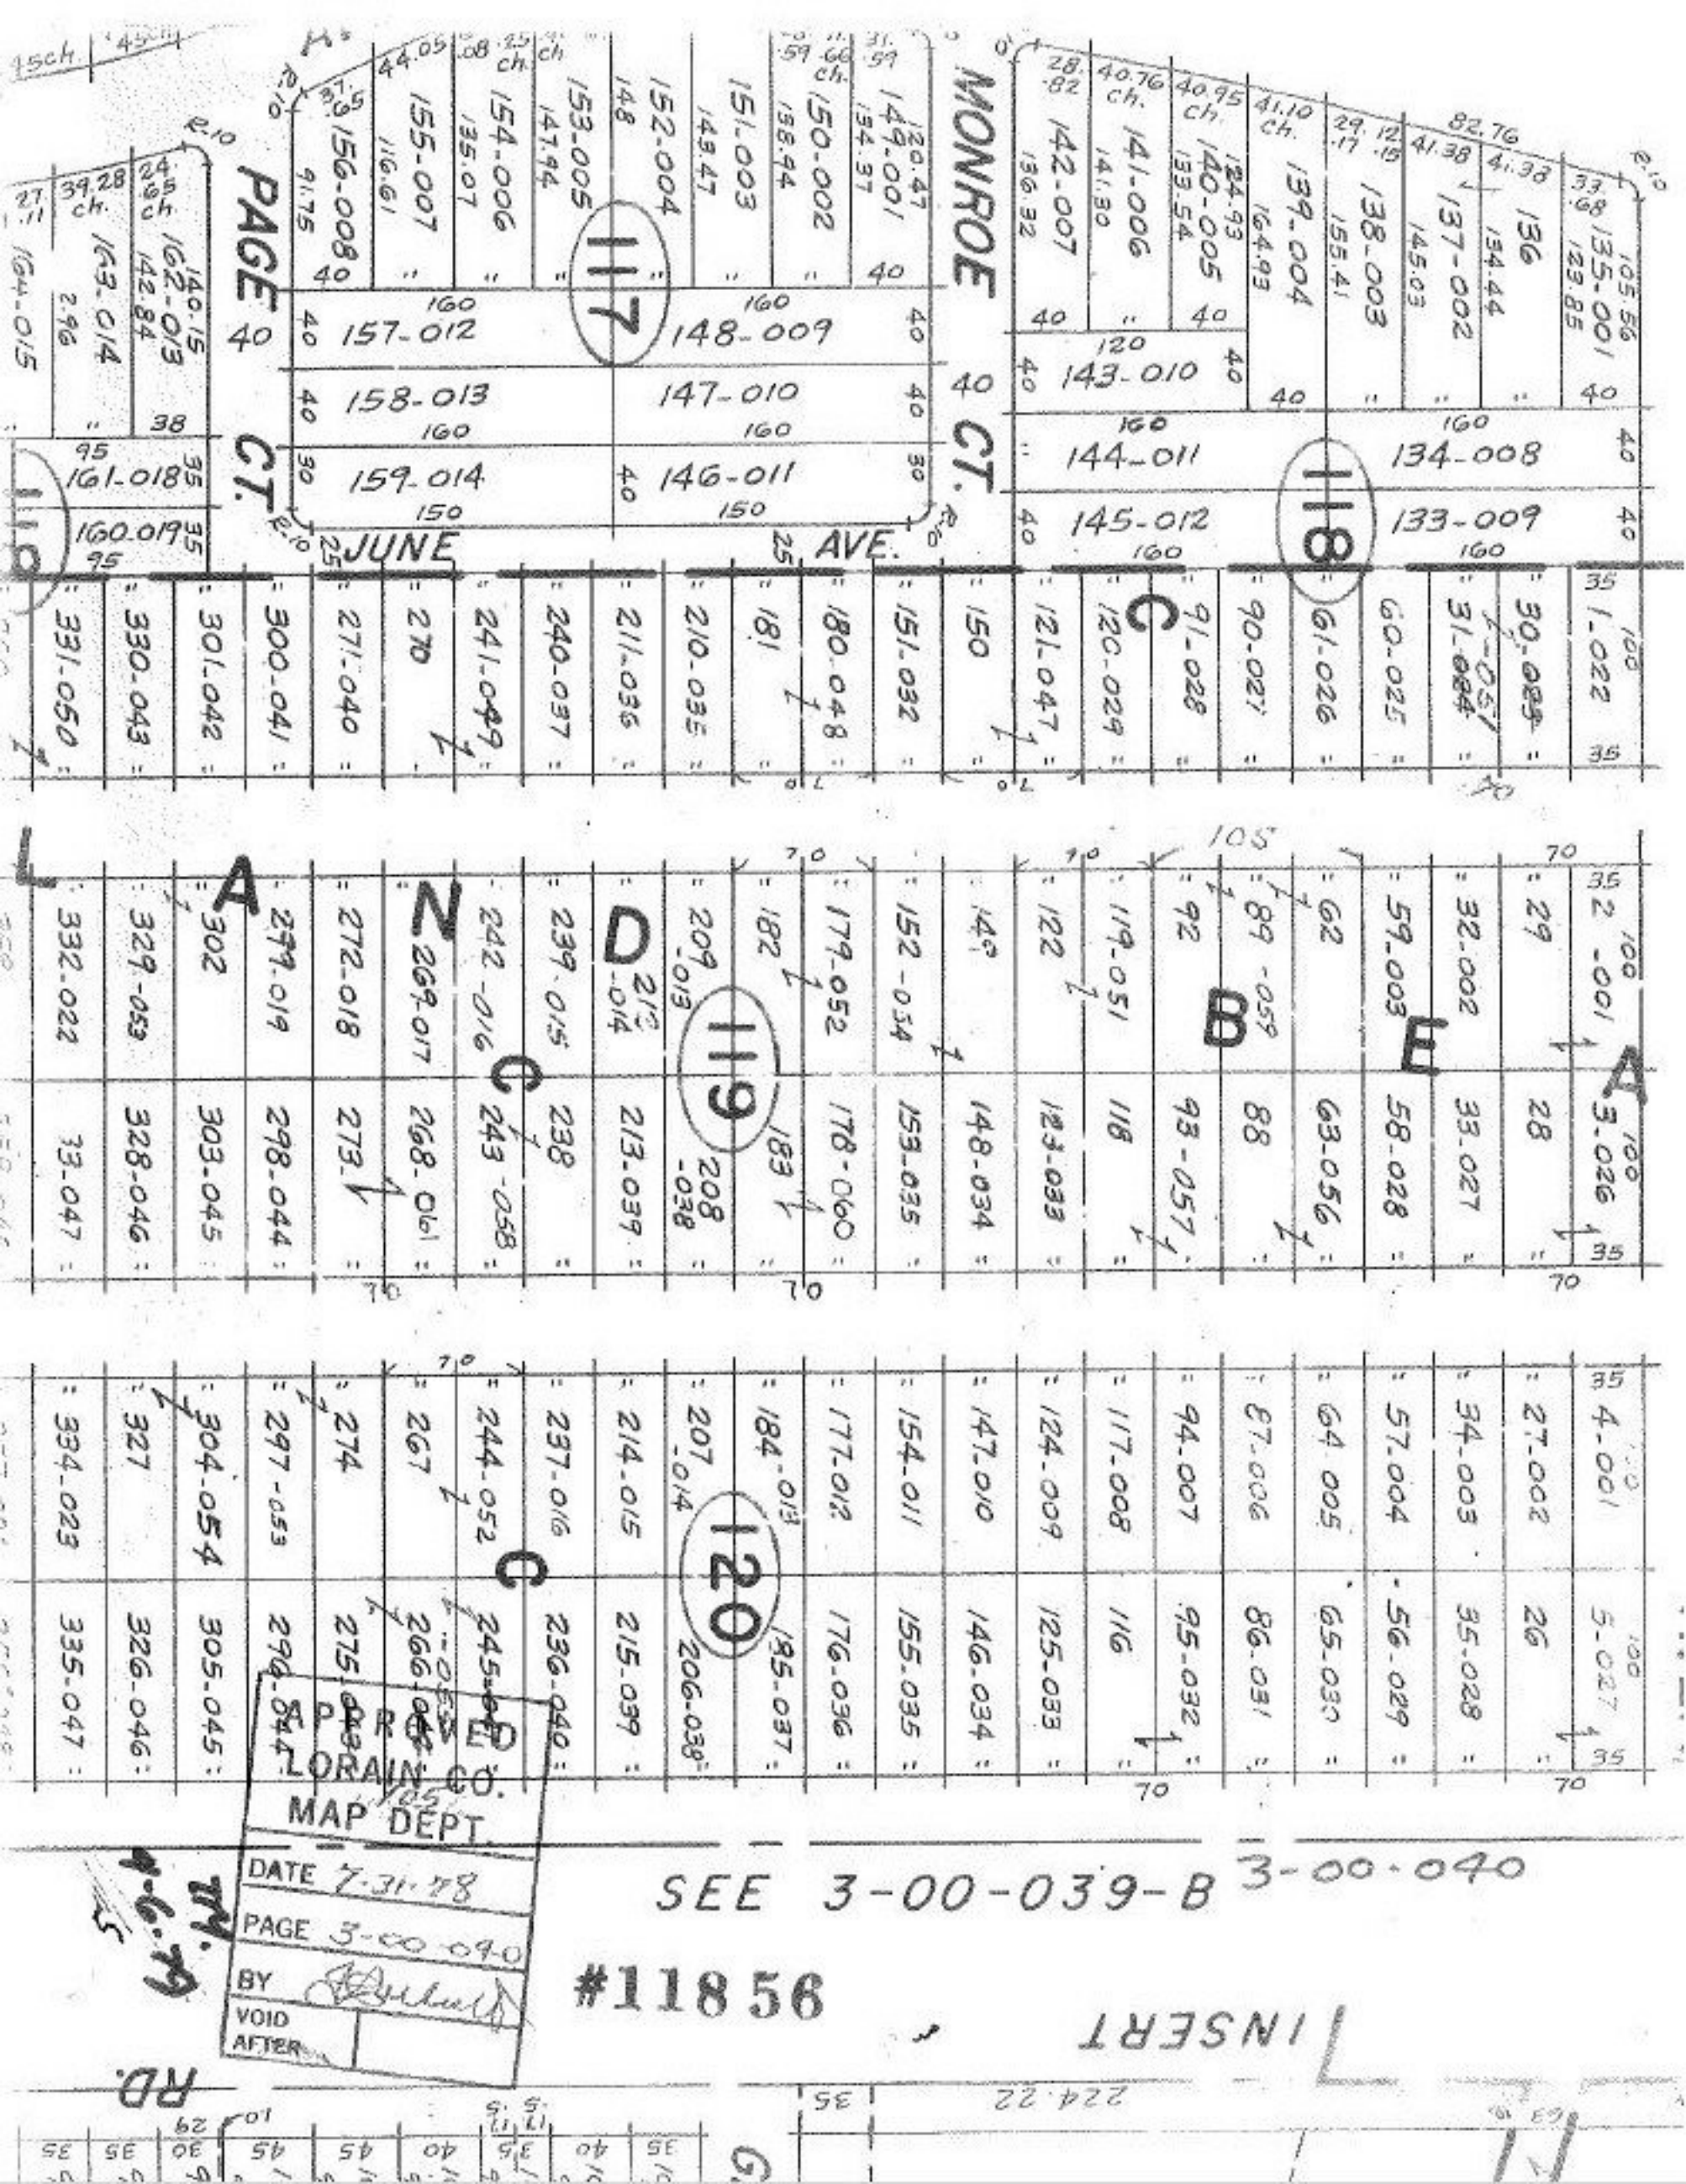

PAGE CT.
MONROE CT.
JUNE AVE.
LANDA
BEA
117
118
119
120
APPROVED
LORAIN CO.
MAP DEPT.
DATE 7-31-78
PAGE 3-00-040
BY
VOID AFTER
SEE 3-00-039-B
3-00-040
#11856
INSERT
RD.