11864

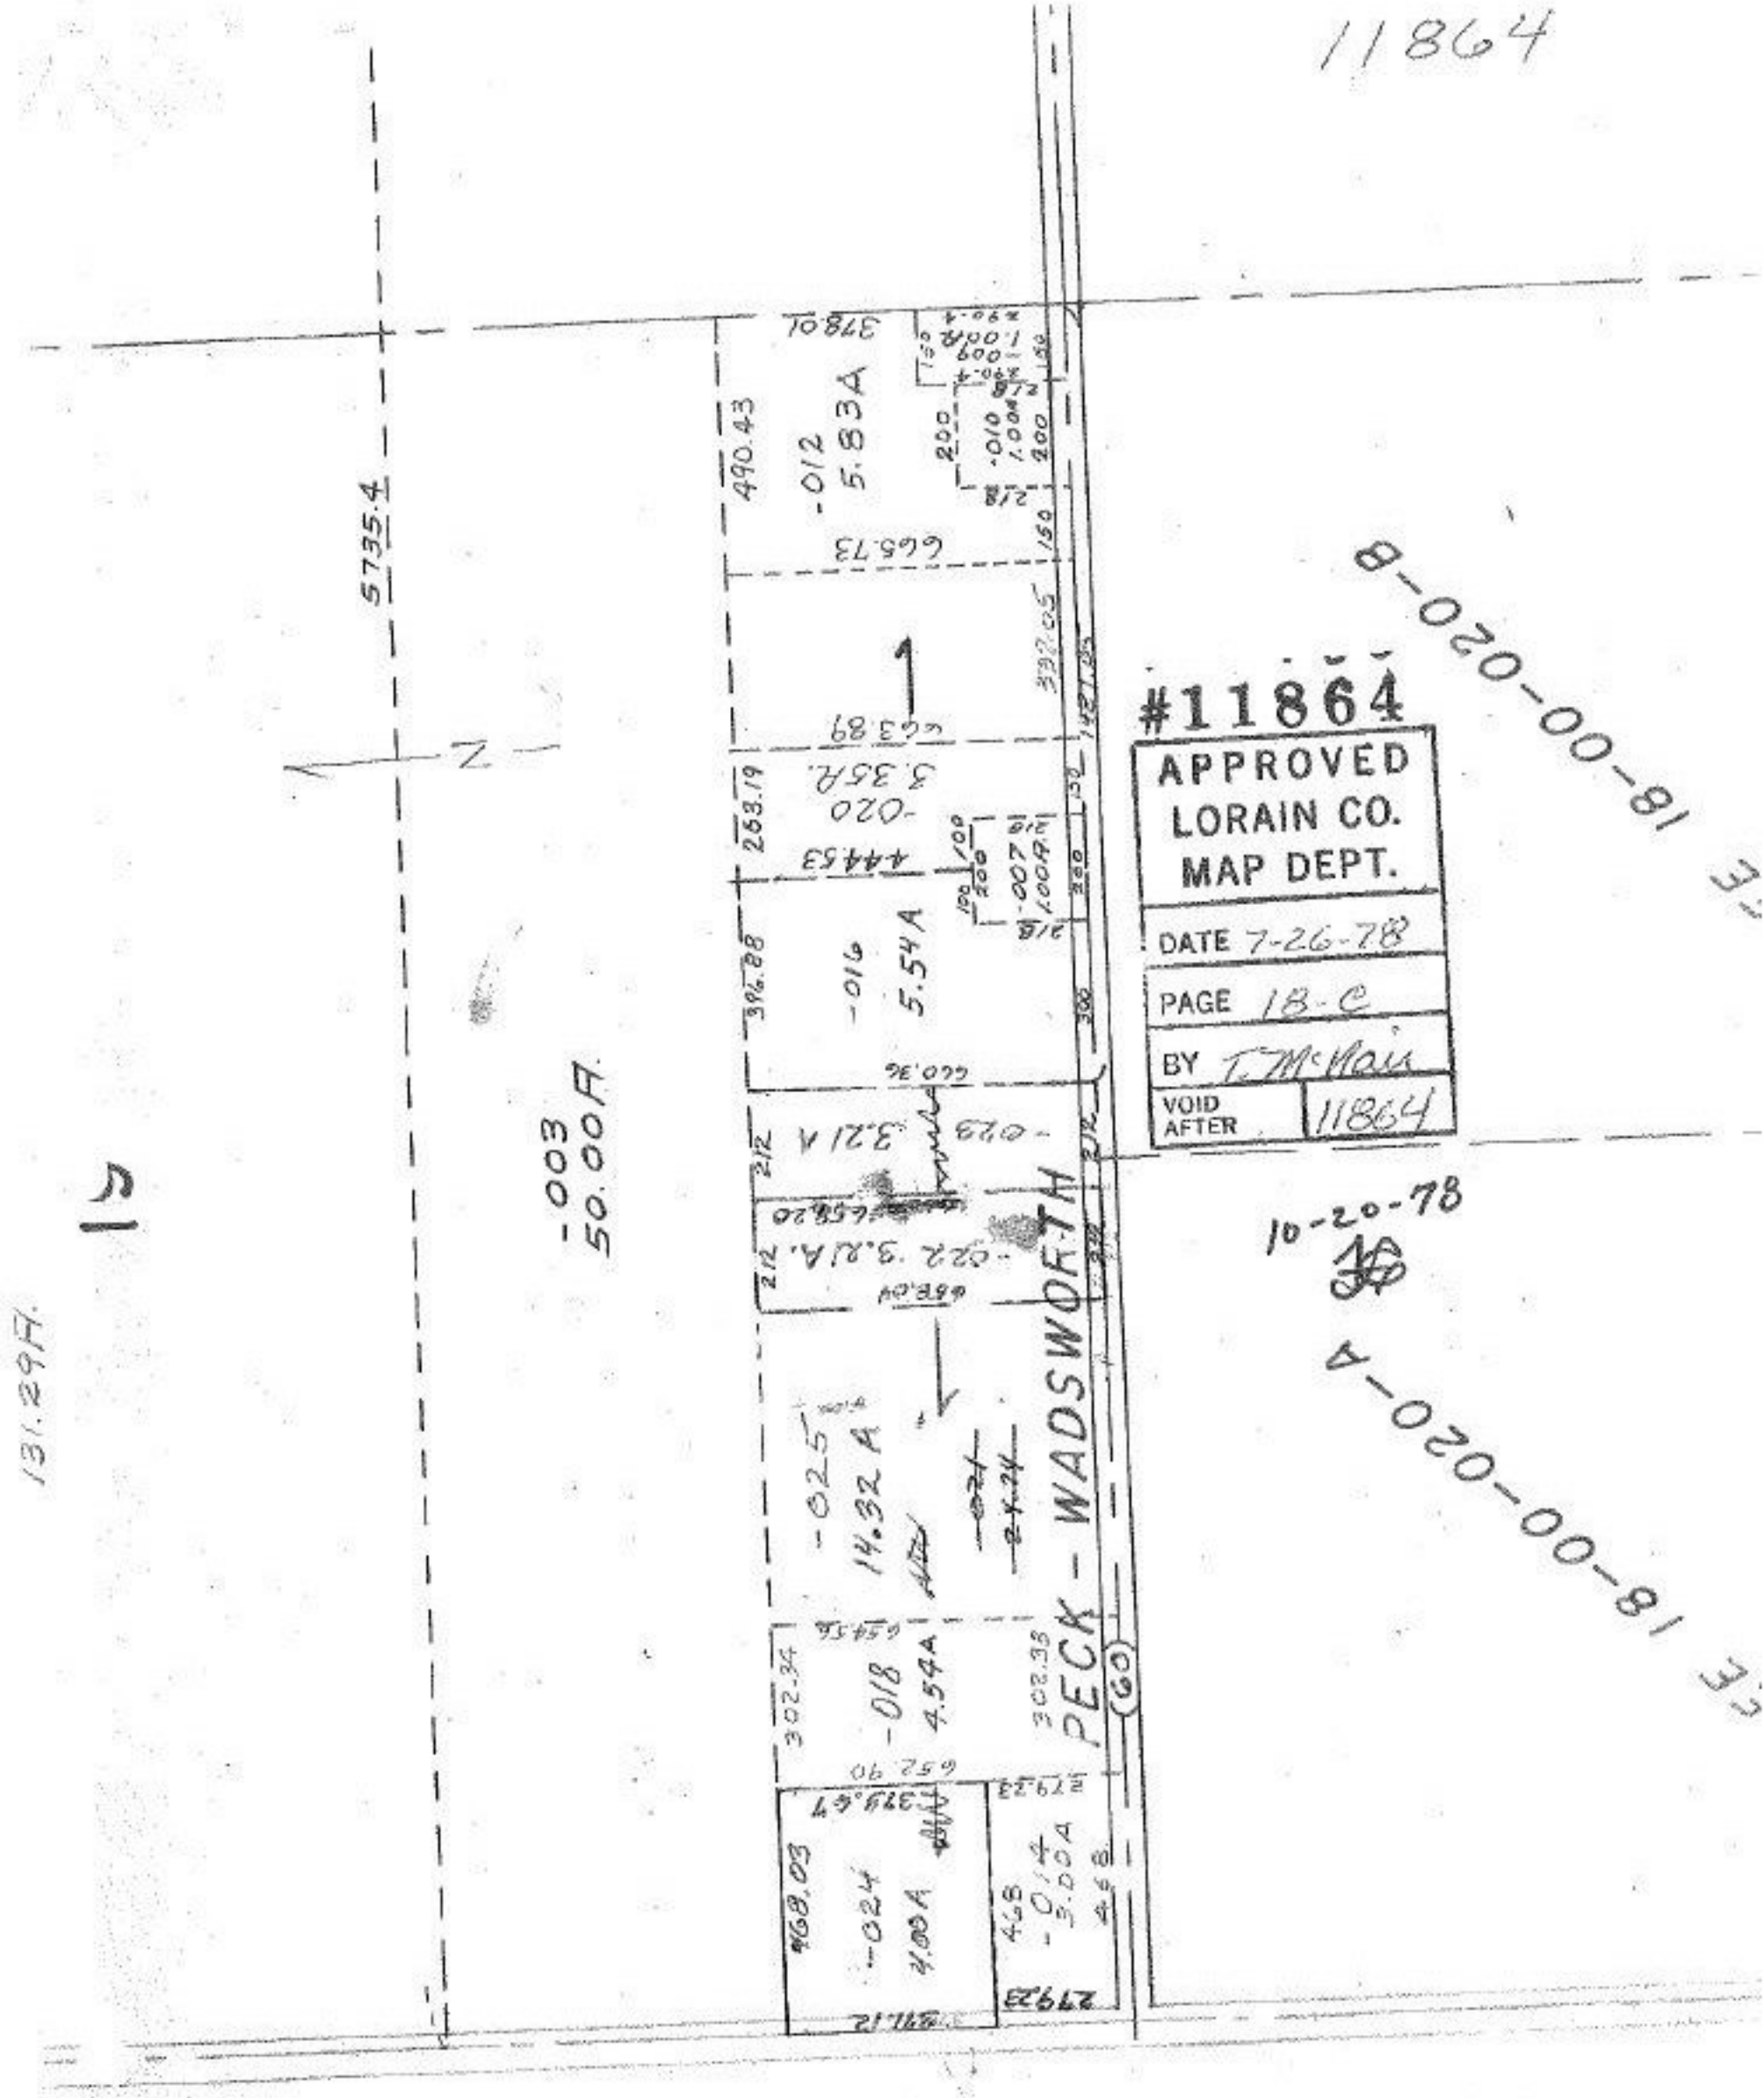

5735.4
N
-003
50.00A
131.29A
-012
5.83A
490.43
378.01
665.73
663.89
-020
3.35A
263.19
444.53
-016
5.54A
396.88
660.36
-023
3.21A
-022
3.21A
-025
14.32A
-018
4.54A
302.34
302.33
652.90
468.03
-024
4.00A
-014
3.00A
468
279.23
PECK - WADSWORTH
(60)
18-00-020-B
18-00-020-A
#11864
APPROVED
LORAIN CO.
MAP DEPT.
DATE 7-26-78
PAGE 18-C
BY T. McNair
VOID AFTER 11864
10-20-78