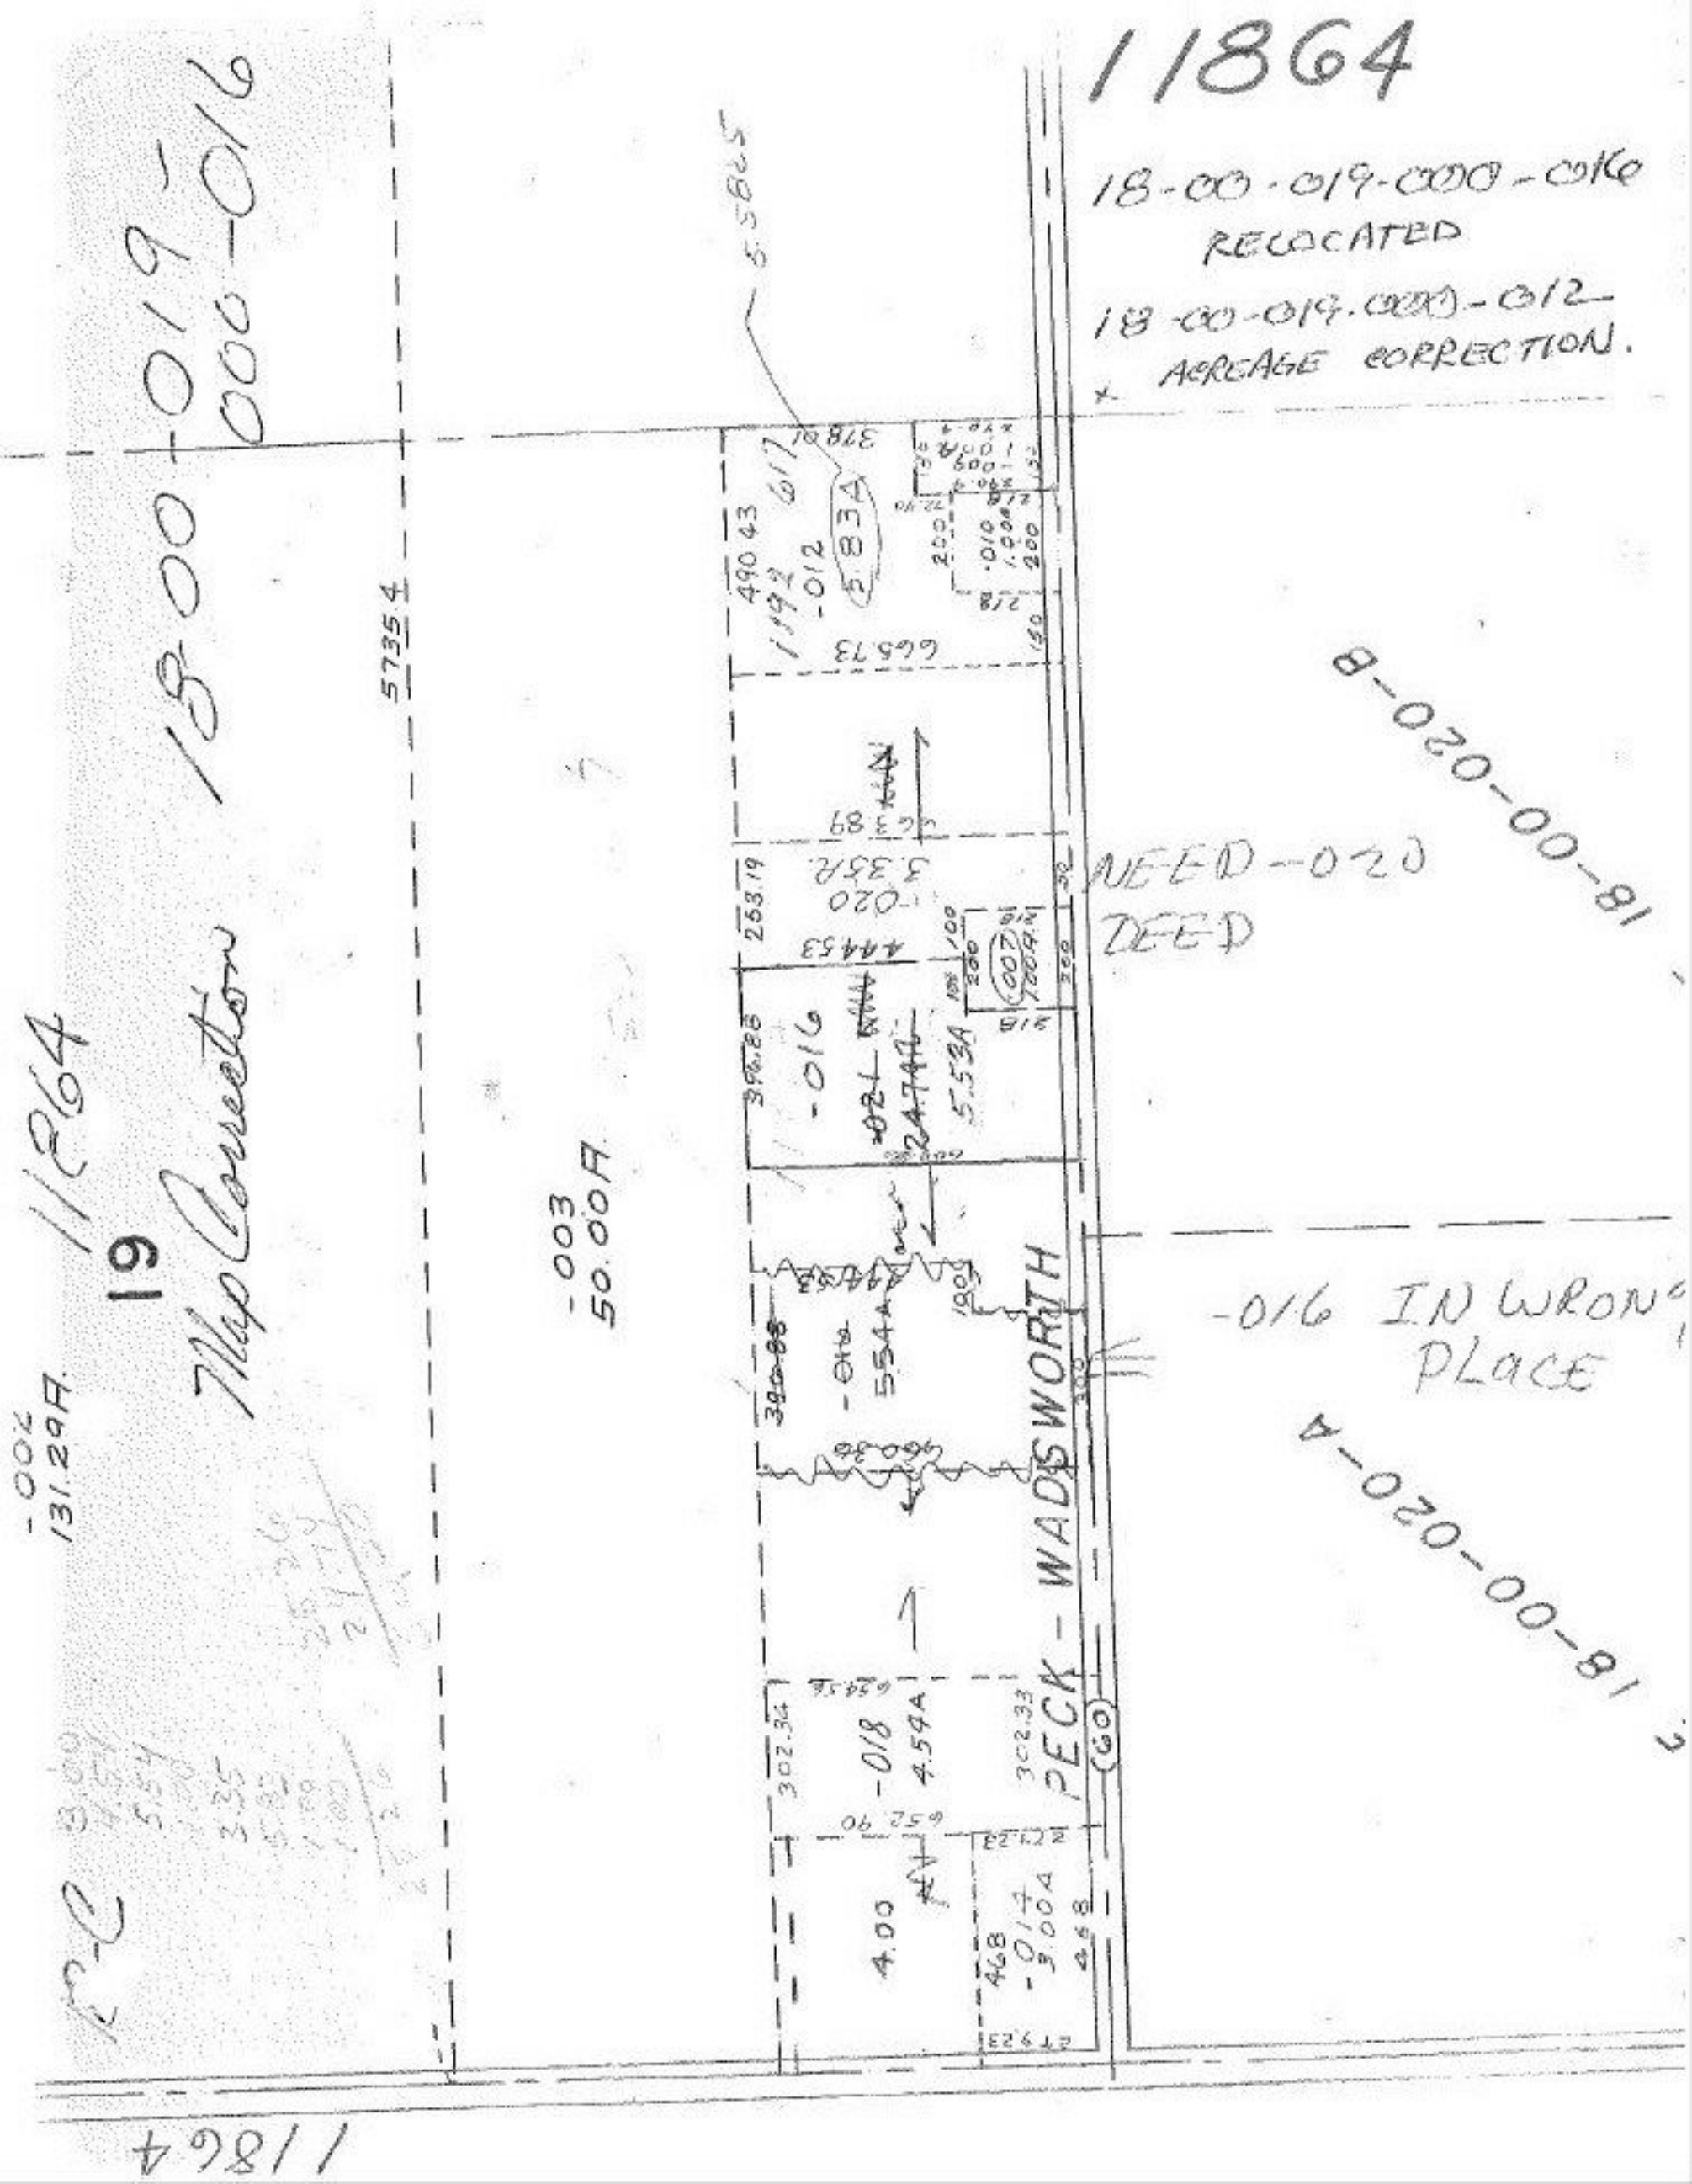
11864
18-00-019-000-016
RELOCATED
18-00-019-000-012
ACREAGE CORRECTION.
18-00-019-000-016
11864
19
Map Correction
-002
131.29A
-003
50.00A
5735.4
5.5825
490.43
1192
617
-012
5.83A
665.73
63.89
3.35A
-020
253.19
444.53
-016
-021
24.74A
5.53A
-007
1.00A
396.88
-016
5.54A
-018
4.54A
302.34
302.33
652.90
4.00
-014
3.00A
468
PECK - WADSWORTH
(60)
NEED-020
DEED
18-00-020-B
-016 IN WRONG
PLACE
18-00-020-A
11864