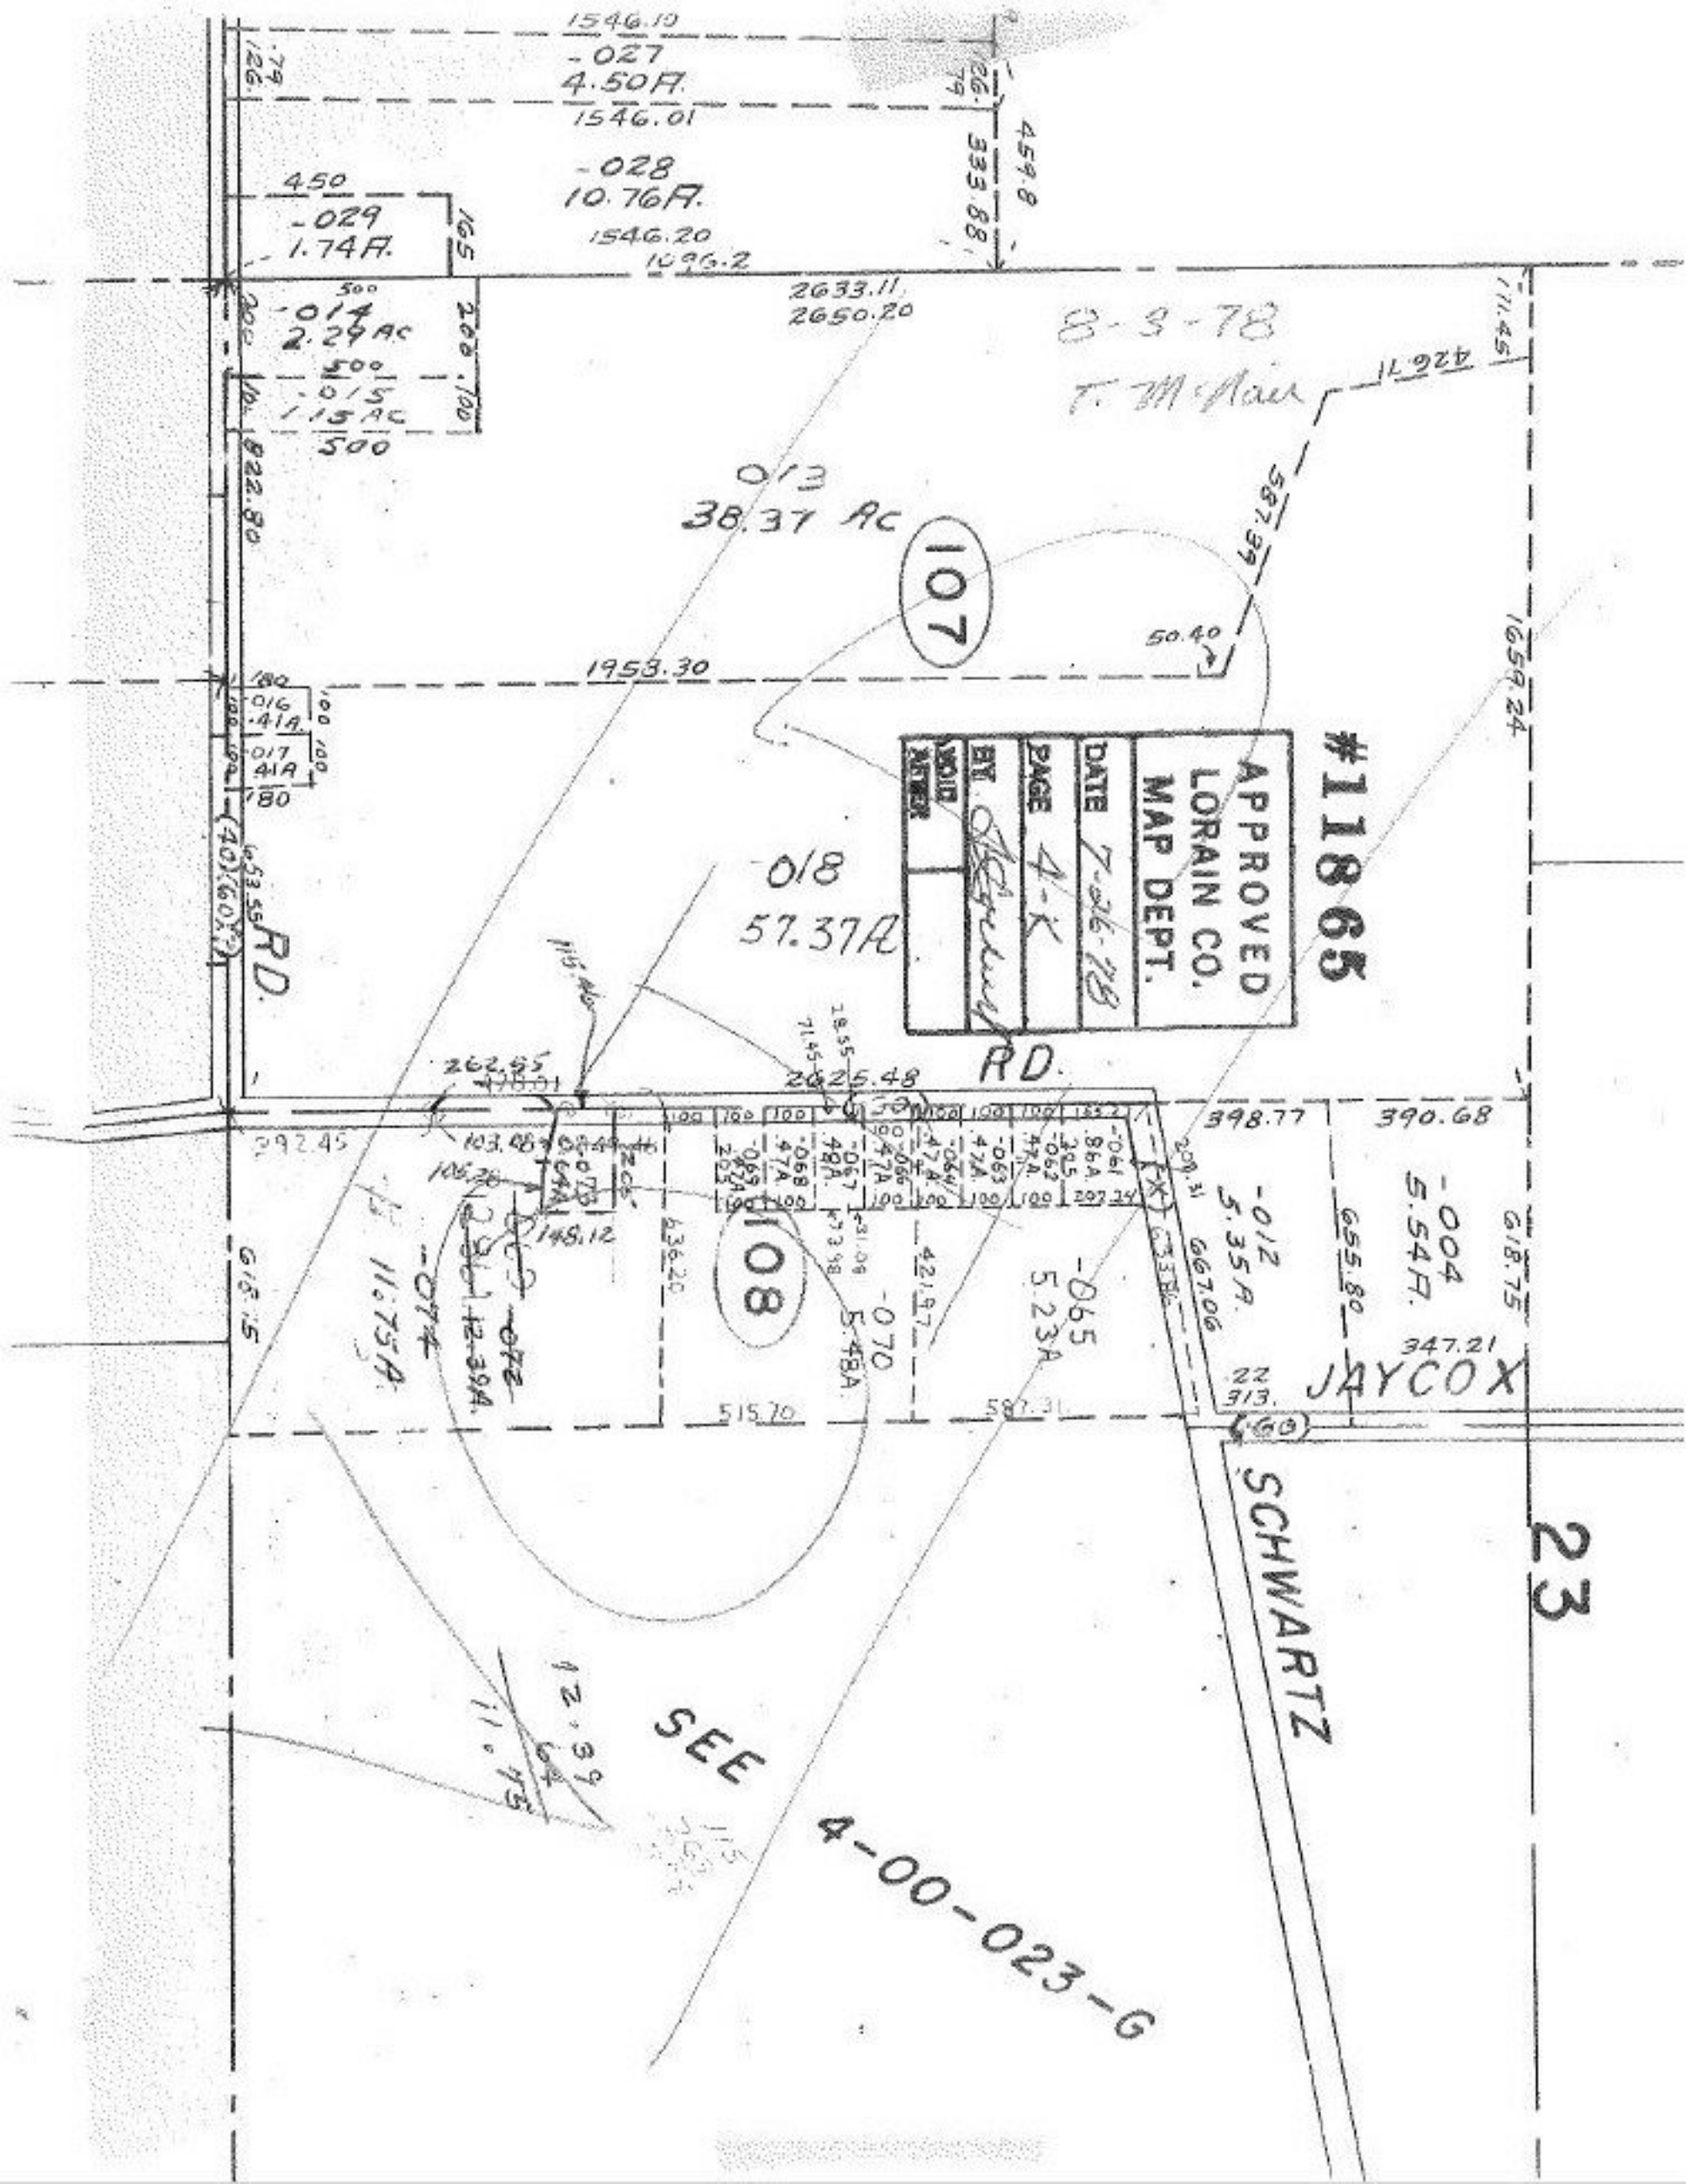

1546.10
-027
4.50A.
1546.01
-028
10.76A.
1546.20
1096.2
450
-029
1.74A.
-014
2.29 AC
-015
1.15 AC
2633.11
2650.20
8-3-78
T. McNair
013
38.37 AC
107
1953.30
50.40
APPROVED
LORAIN CO.
MAP DEPT.
DATE 7-26-78
PAGE 4-K
BY
AVOID
ATTEN
#11865
018
57.37A
RD.
2625.48
398.77
390.68
-012
5.35A.
-004
5.54A.
-065
5.23A
-070
5.48A
108
-074
11.75A.
347.21
JAYCOX
SCHWARTZ
23
SEE 4-00-023-G