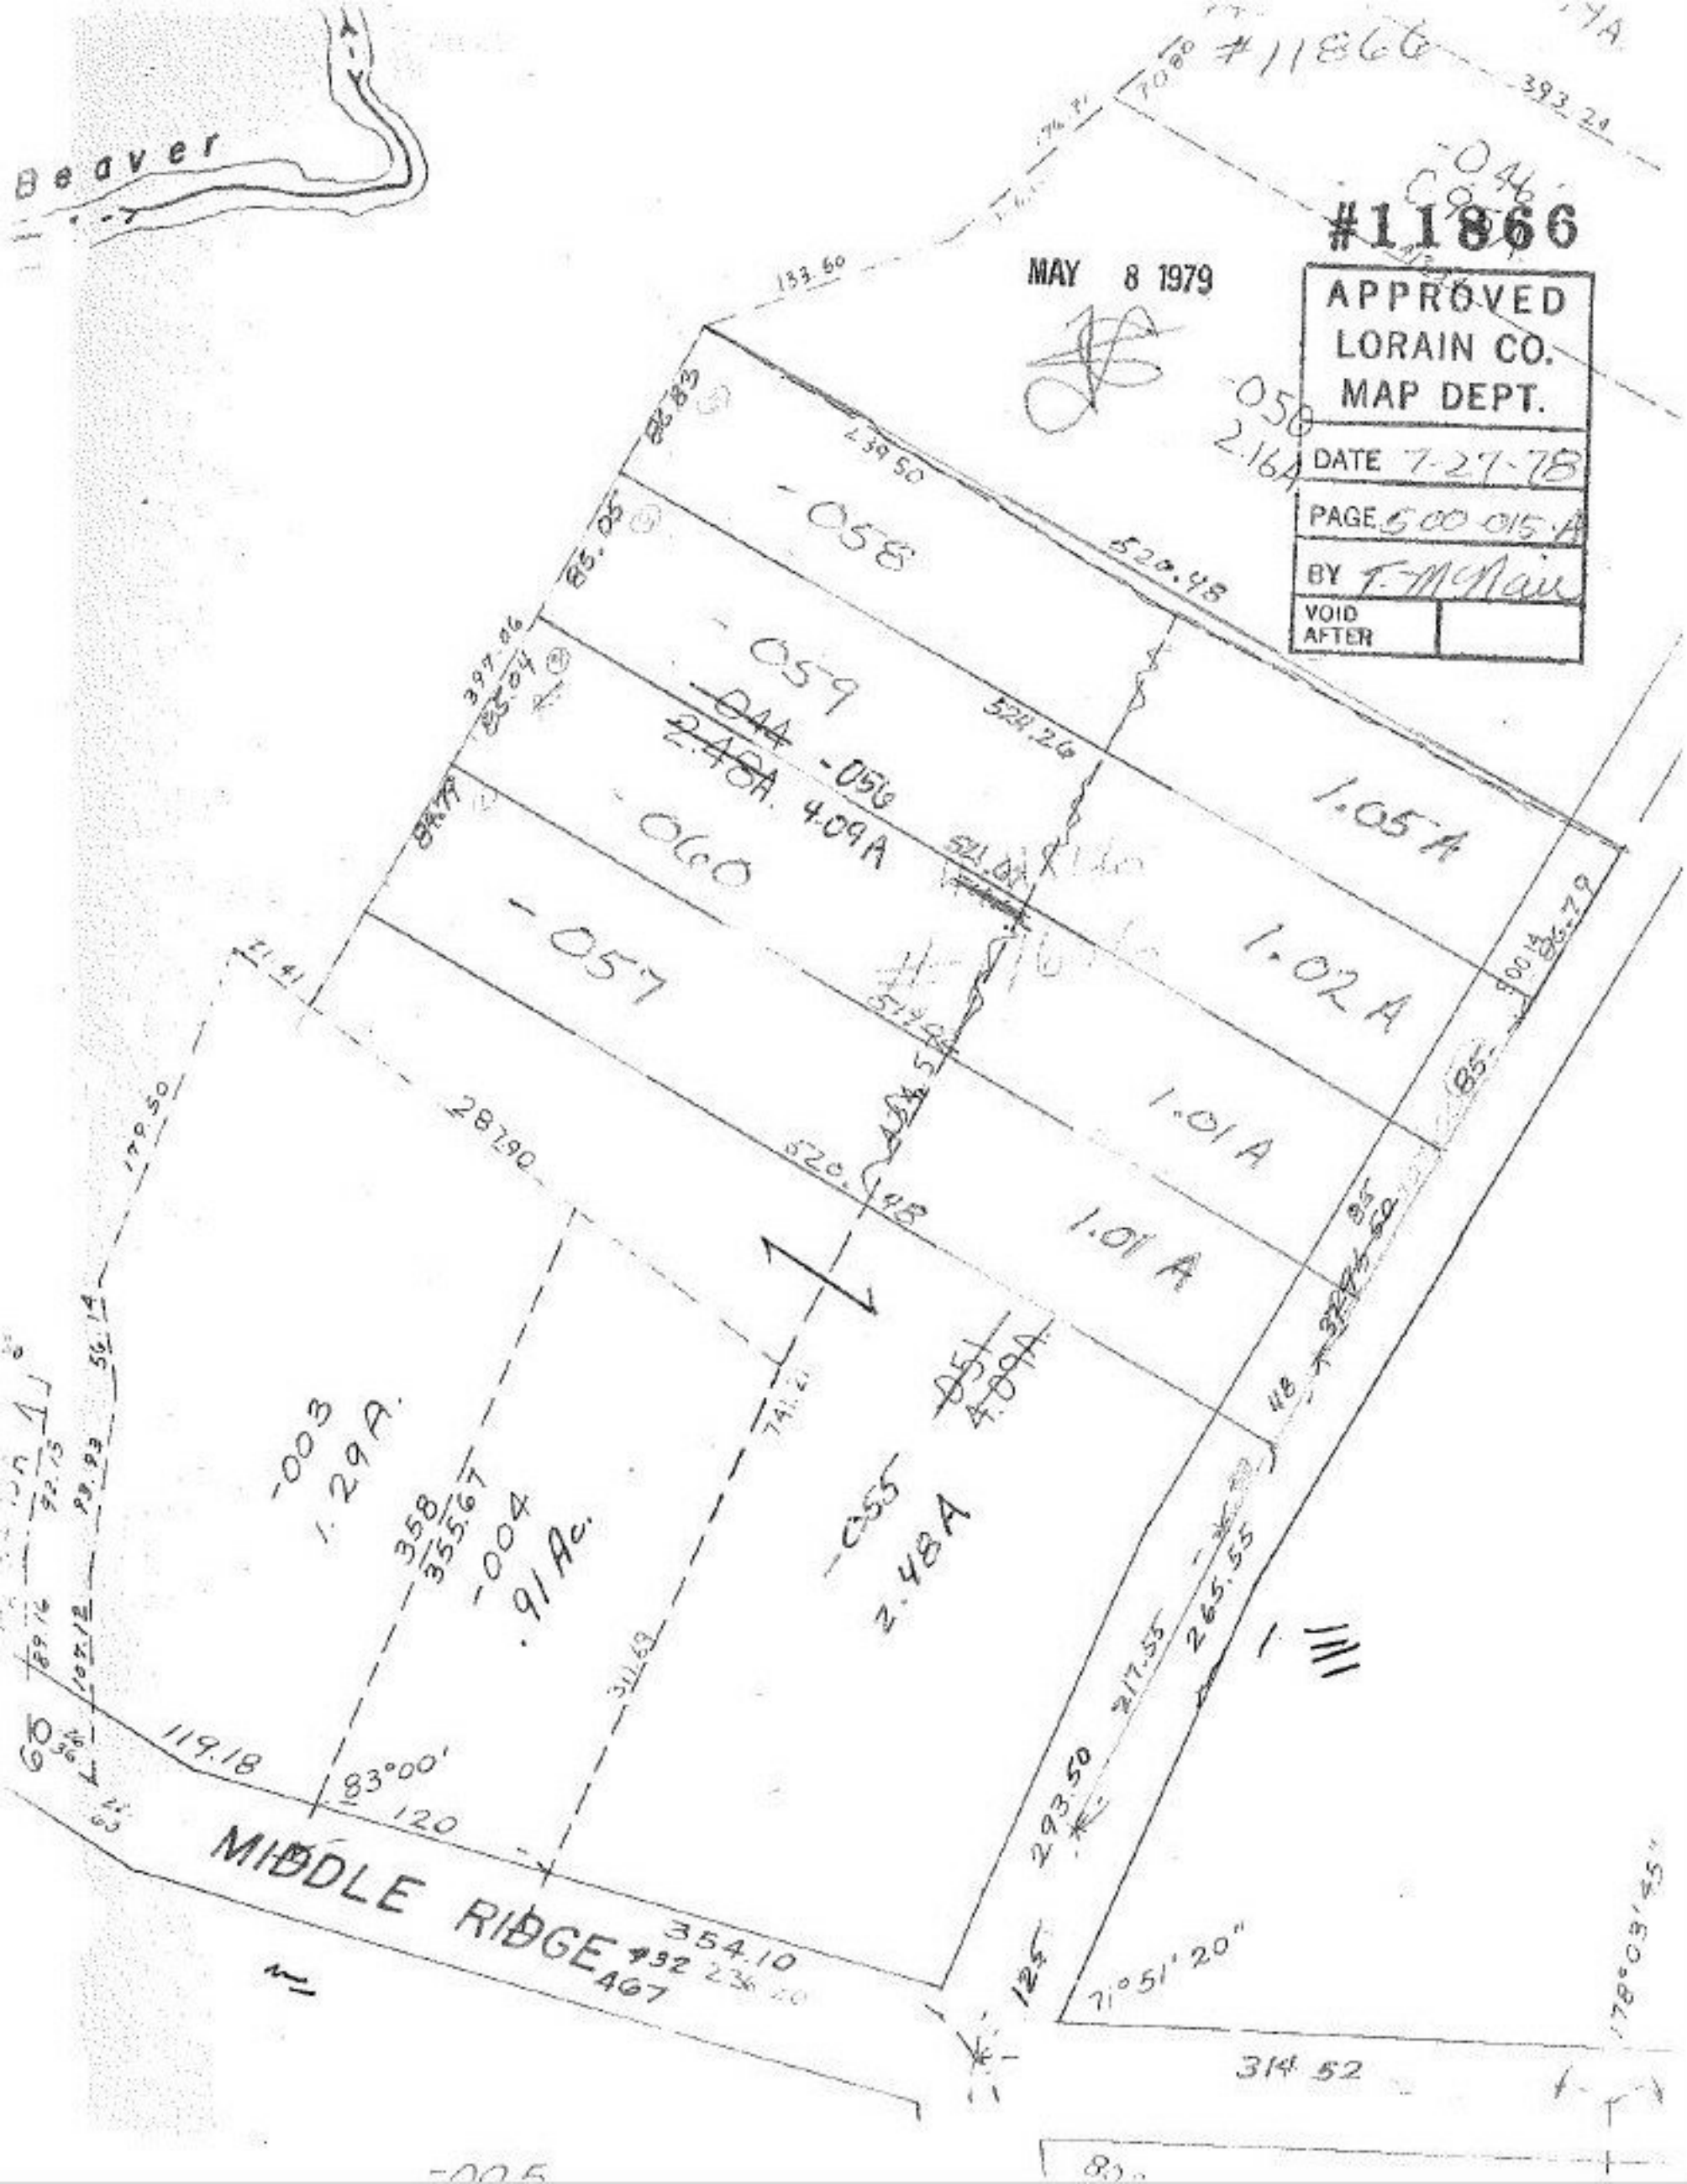

Beaver
#11866
MAY 8 1979
APPROVED
LORAIN CO.
MAP DEPT.
DATE 7-27-78
PAGE 5 00 015 A
BY T. McNair
VOID AFTER
-058
-059
-044
2.48A
-056
4.09A
-060
-057
1.05A
1.02A
1.01A
1.01A
-003
1.29A
-004
.91Ac.
-055
2.48A
MIDDLE RIDGE
354.10
314.52
71°51'20"
178°03'45"
83°00'
119.18
120
125
293.50
265.55
217.55
520.48
528.26
287.90
133.60