REF. -

DV 482/361

THIS WAS THE FIRST TIME THAT THE CTBIGGS SURVEY DESCRIPTION WAS USED.

ALSO
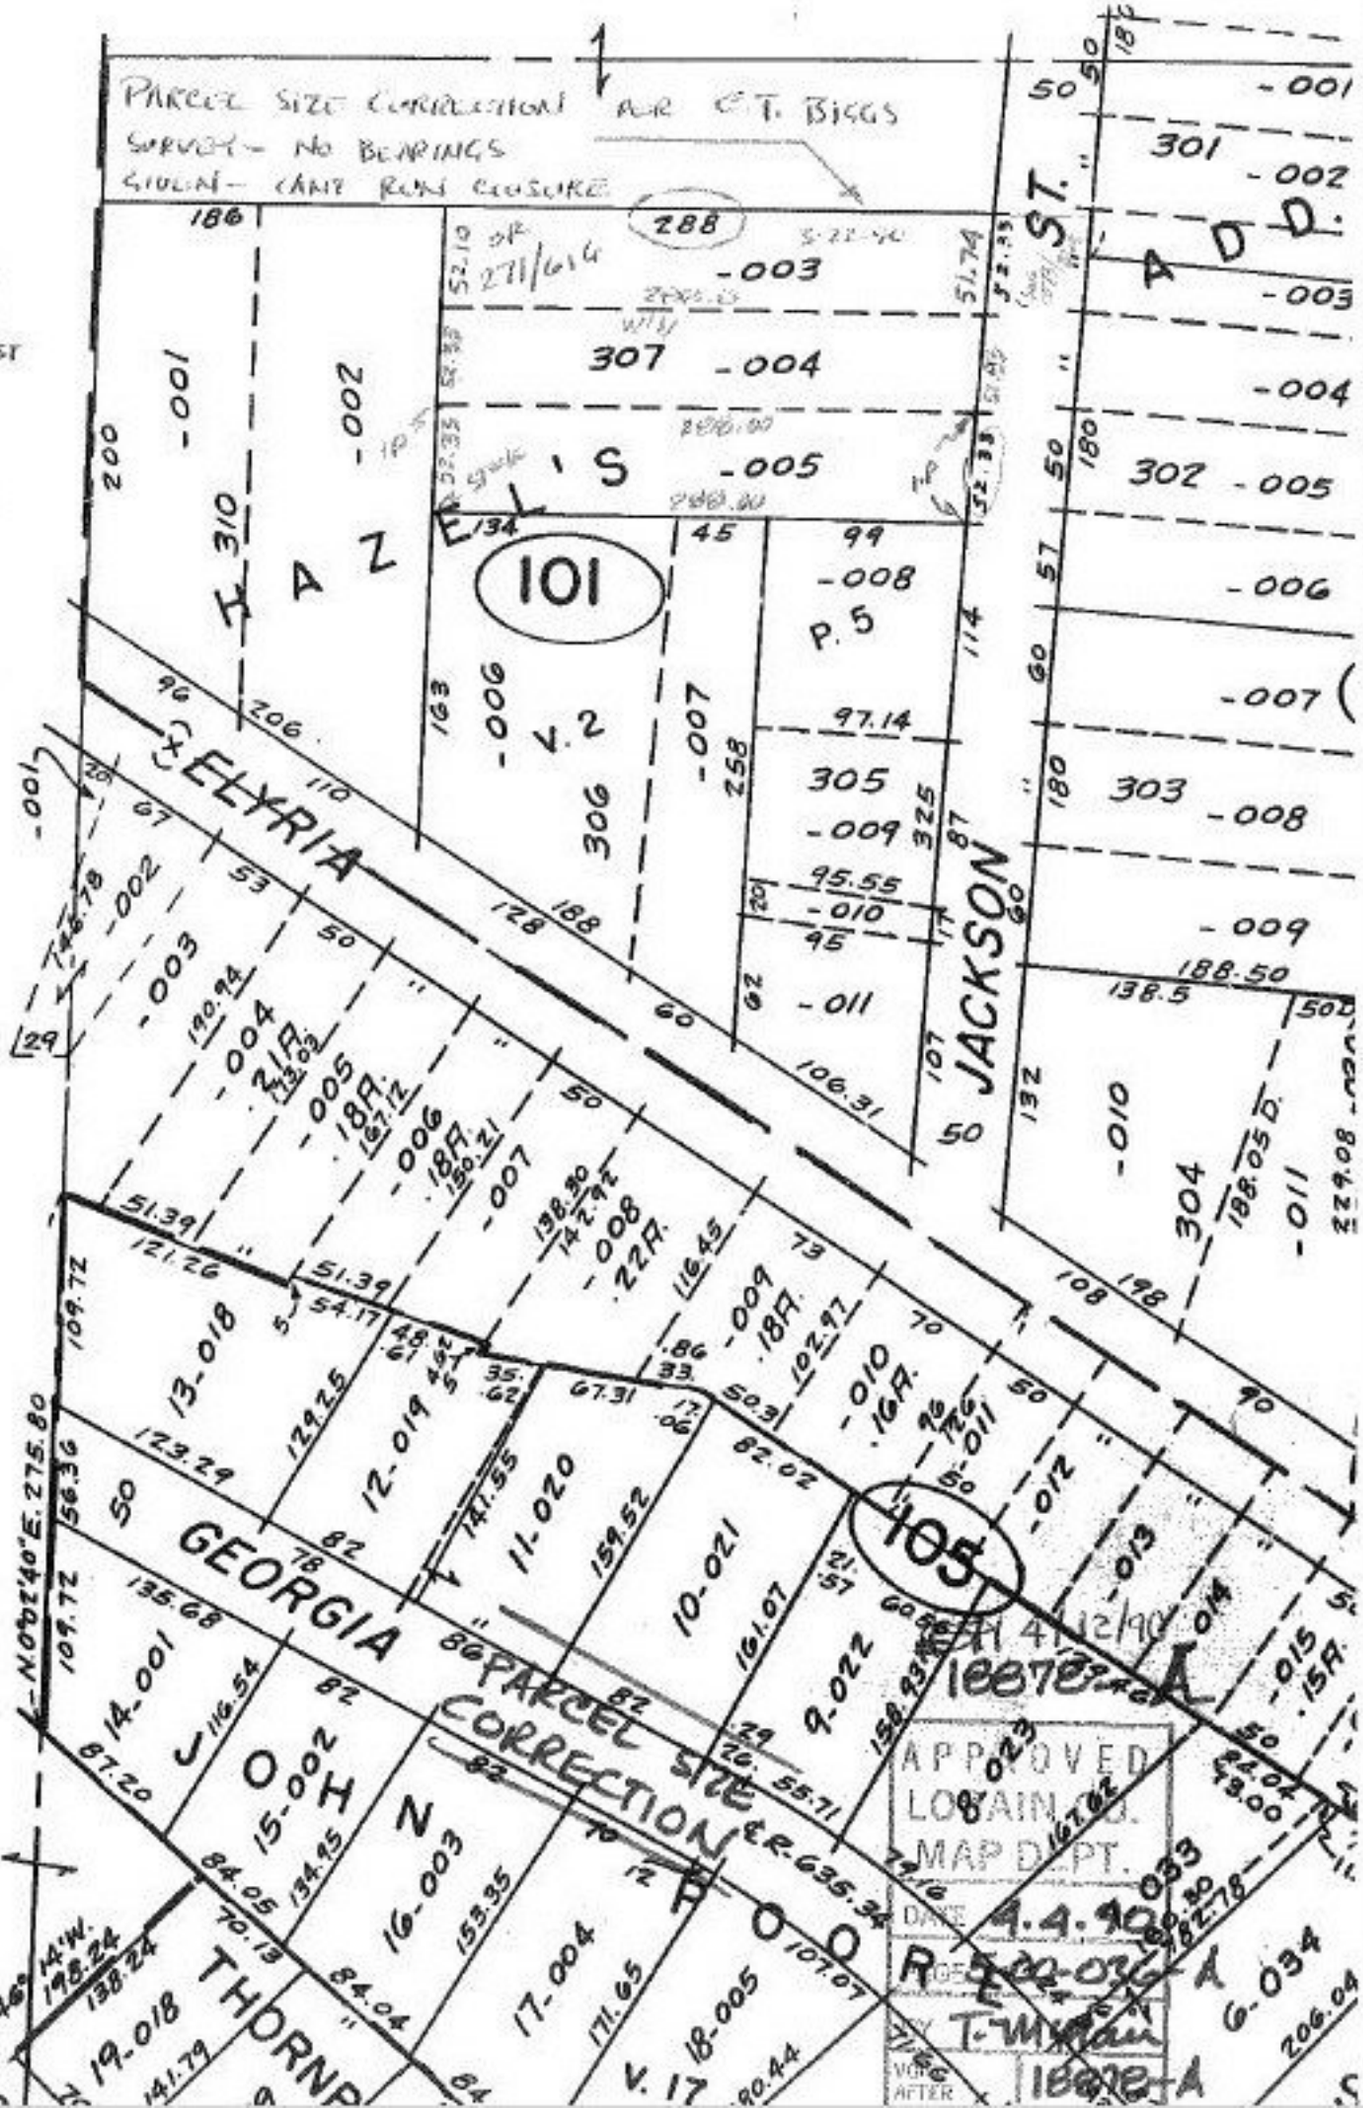
DV 1408/562