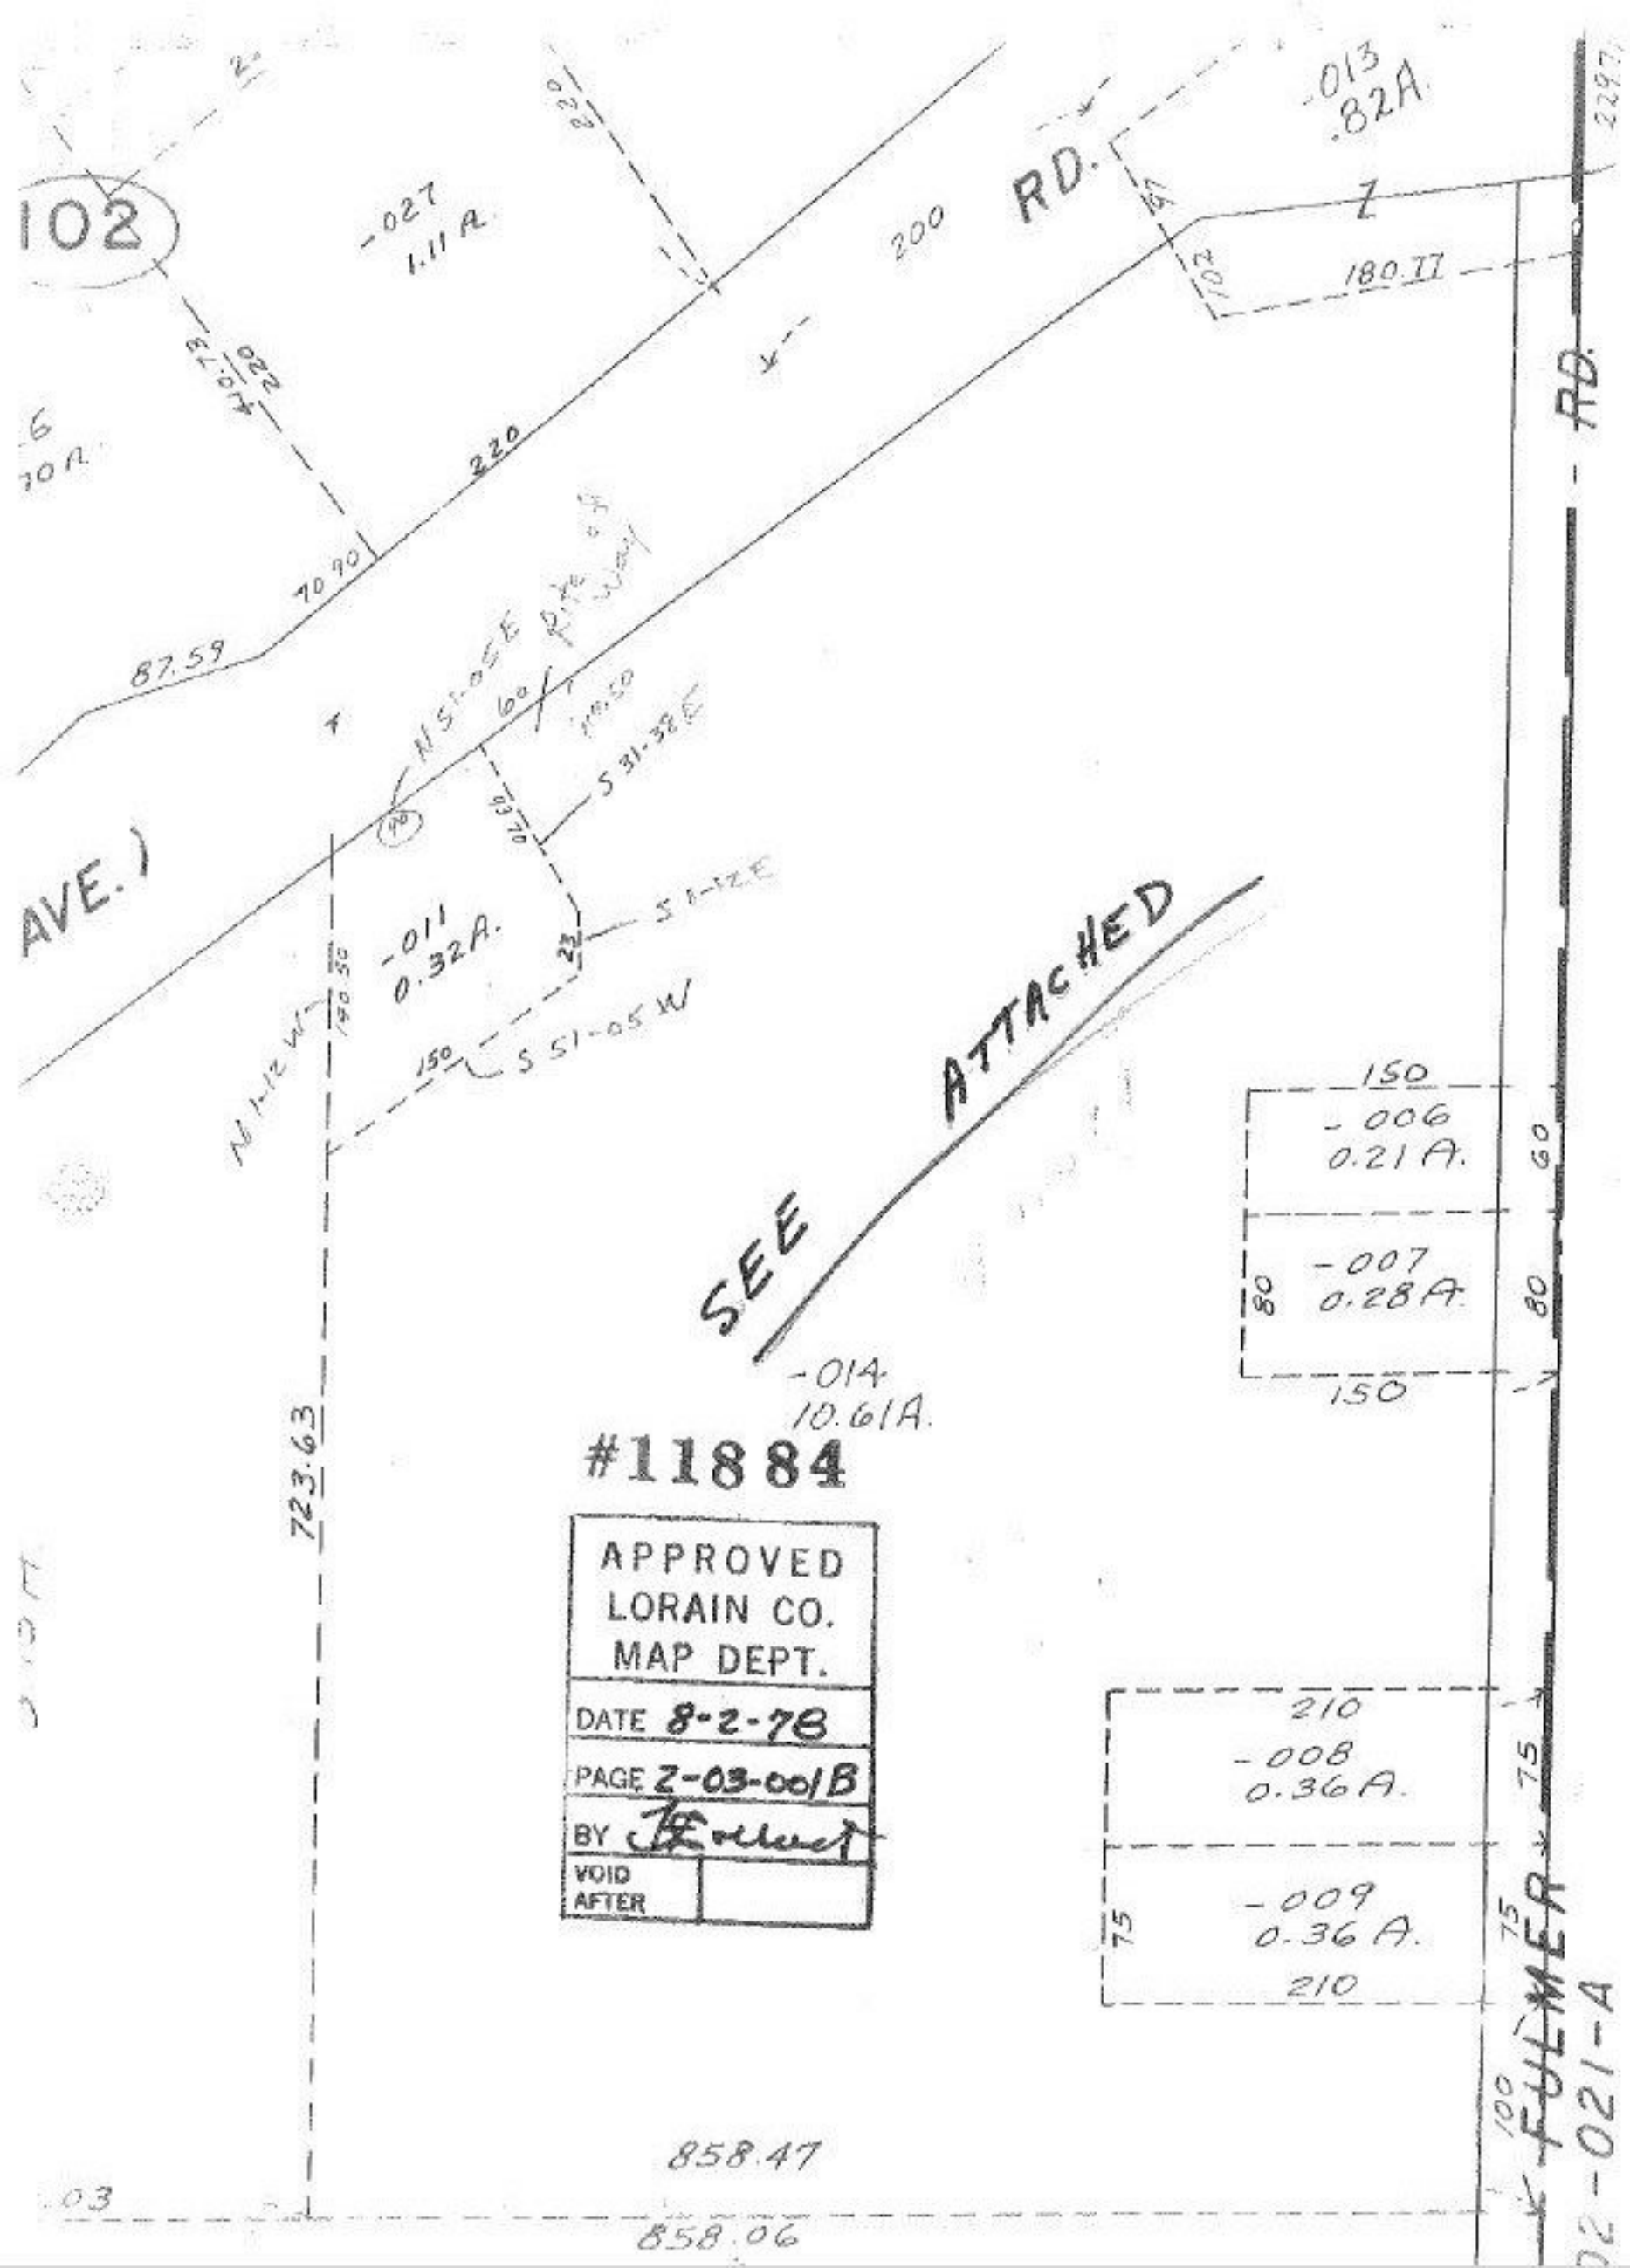
102
-027
1.11 A.
220
200
RD.
-013
.82A.
180.77
RD.
220
70.90
87.59
N 51-05 E
60
S 31-38 E
AVE.)
-011
0.32A.
S 1-12 E
N 1-12 W
150
S 51-05 W
ATTACHED
SEE
150
-006
0.21 A.
60
-007
0.28 A.
80
80
150
-014
10.61A.
723.63
#11884
APPROVED
LORAIN CO.
MAP DEPT.
DATE 8-2-78
PAGE 2-03-001B
BY
VOID
AFTER
210
-008
0.36 A.
75
-009
0.36 A.
75
75
210
FULMER
100
858.47
858.06
02-021-A