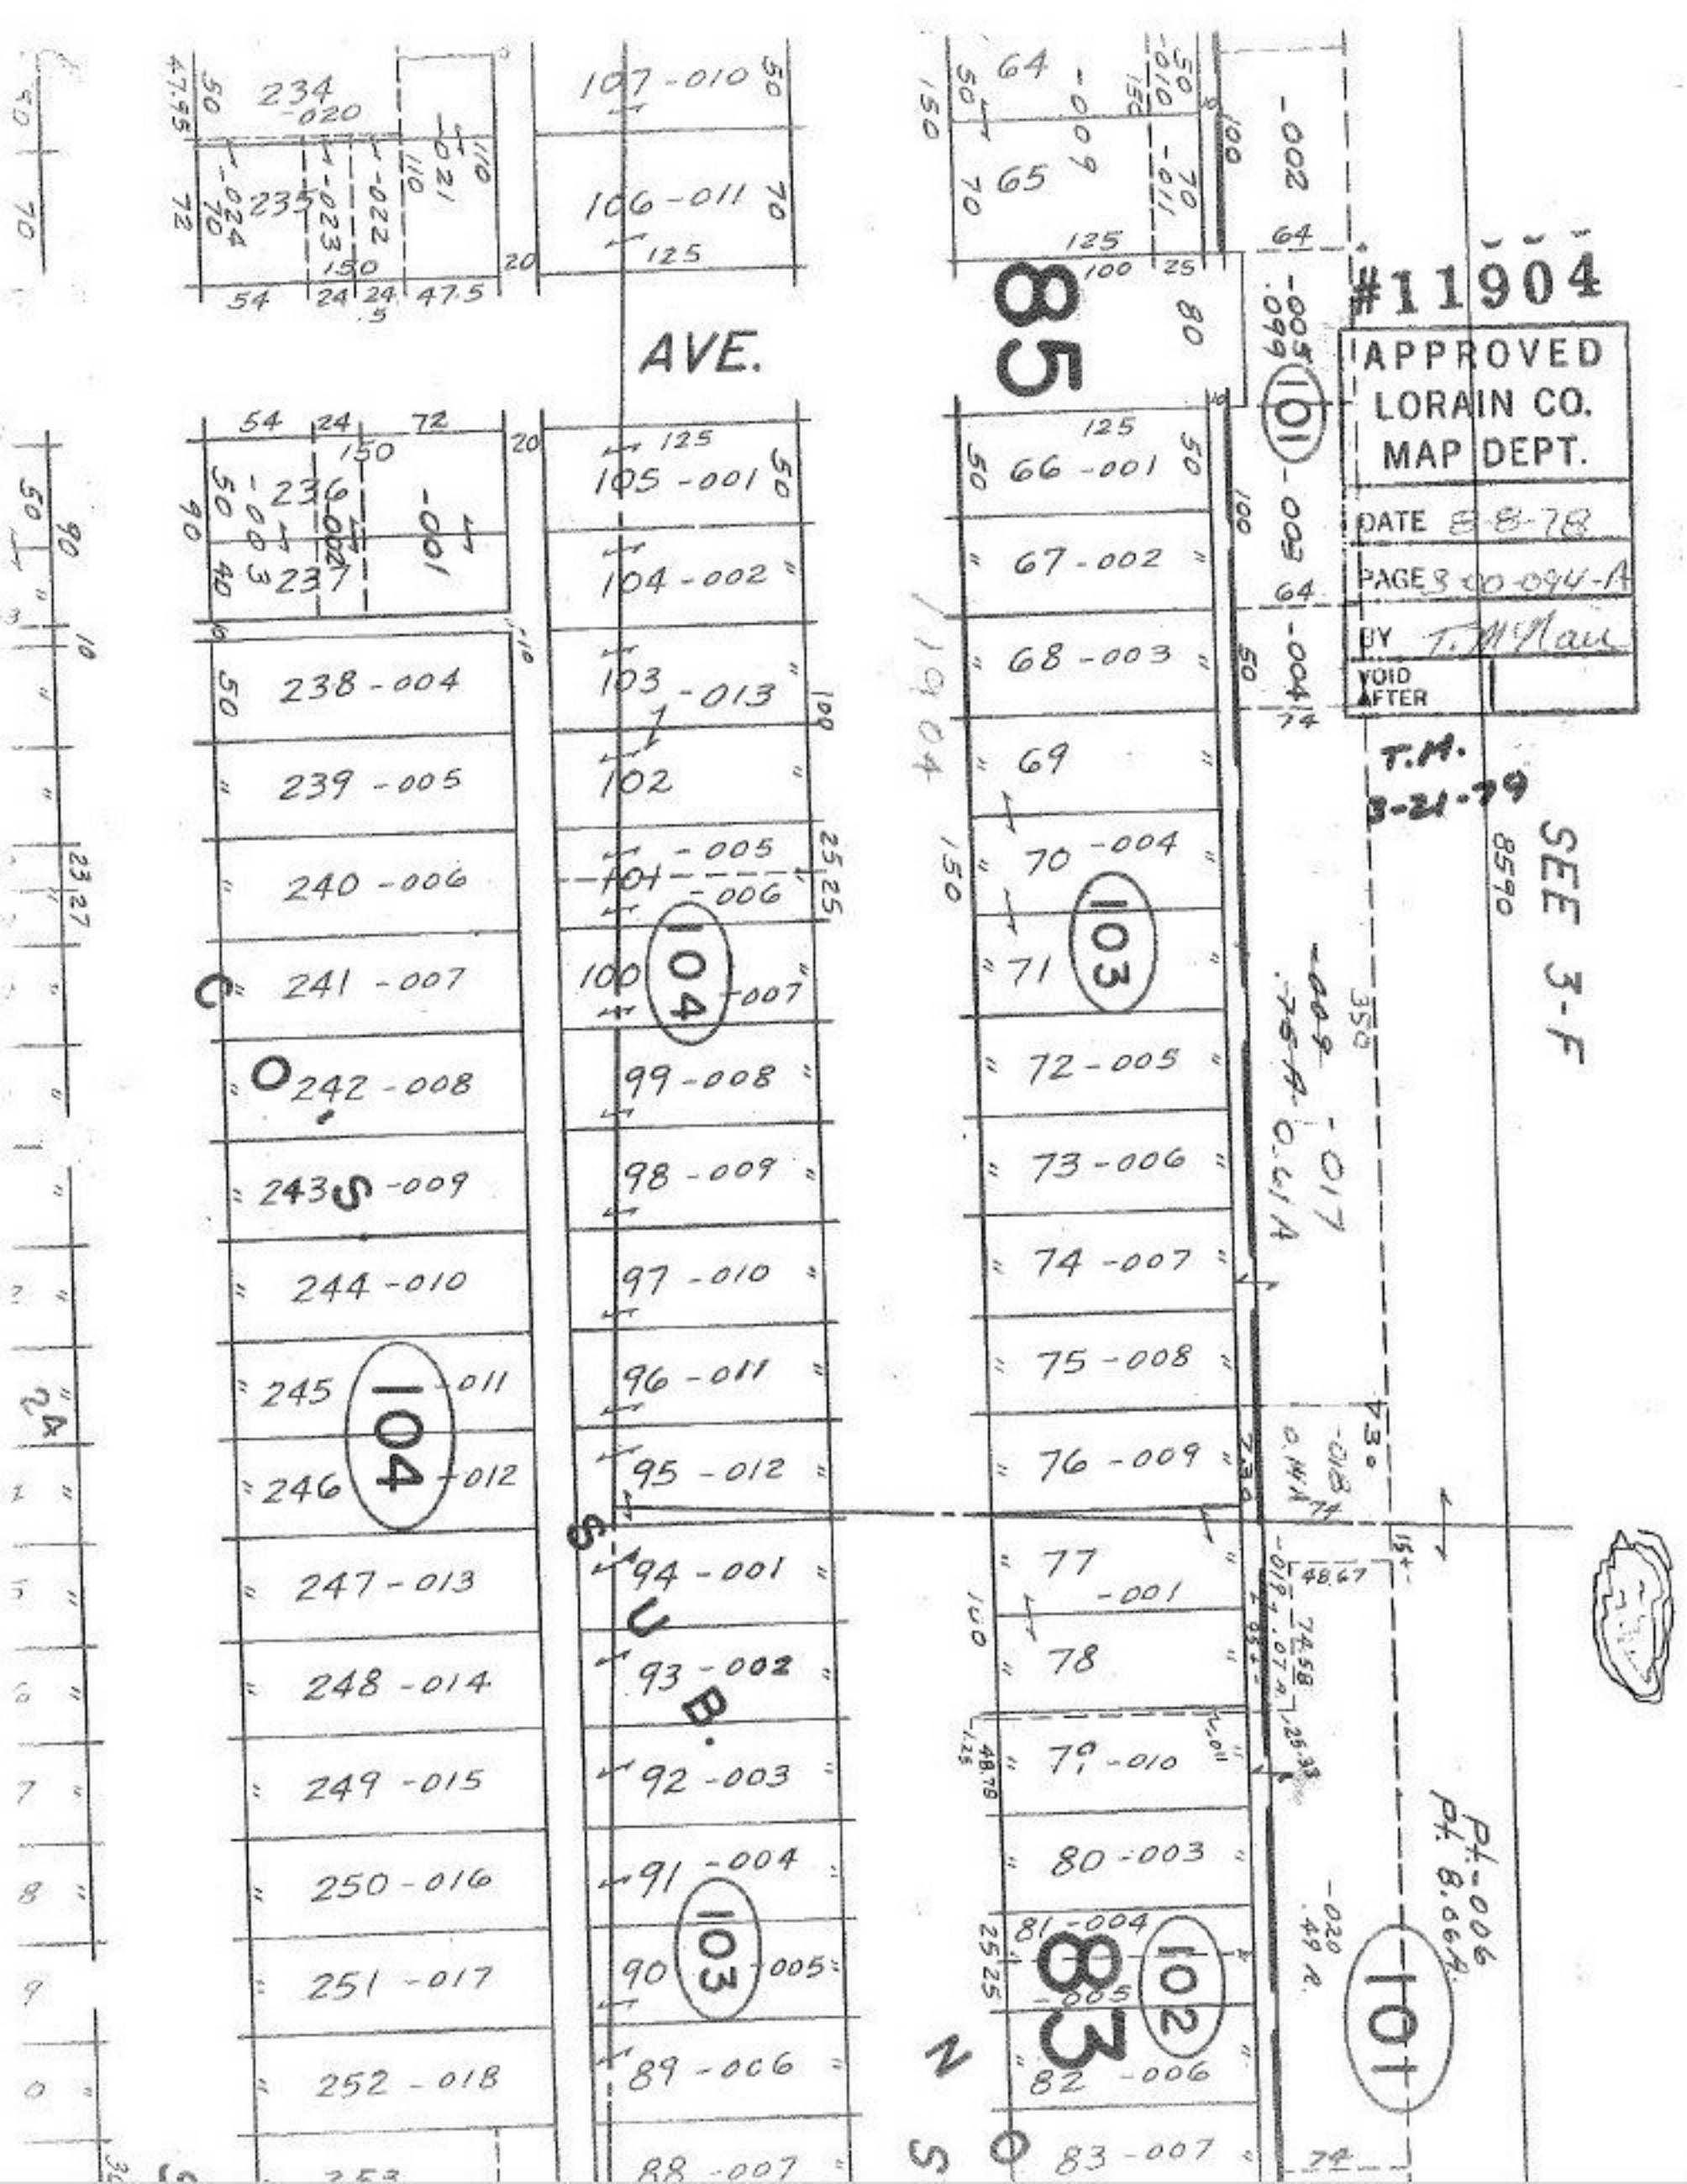

#11904
APPROVED
LORAIN CO.
MAP DEPT.
DATE 8-8-78
PAGE 3-00-094-A
BY T. McNair
VOID AFTER
T.M.
3-21-79
SEE 3-F
85
AVE.
104
103
102
101
83
SUB. B.