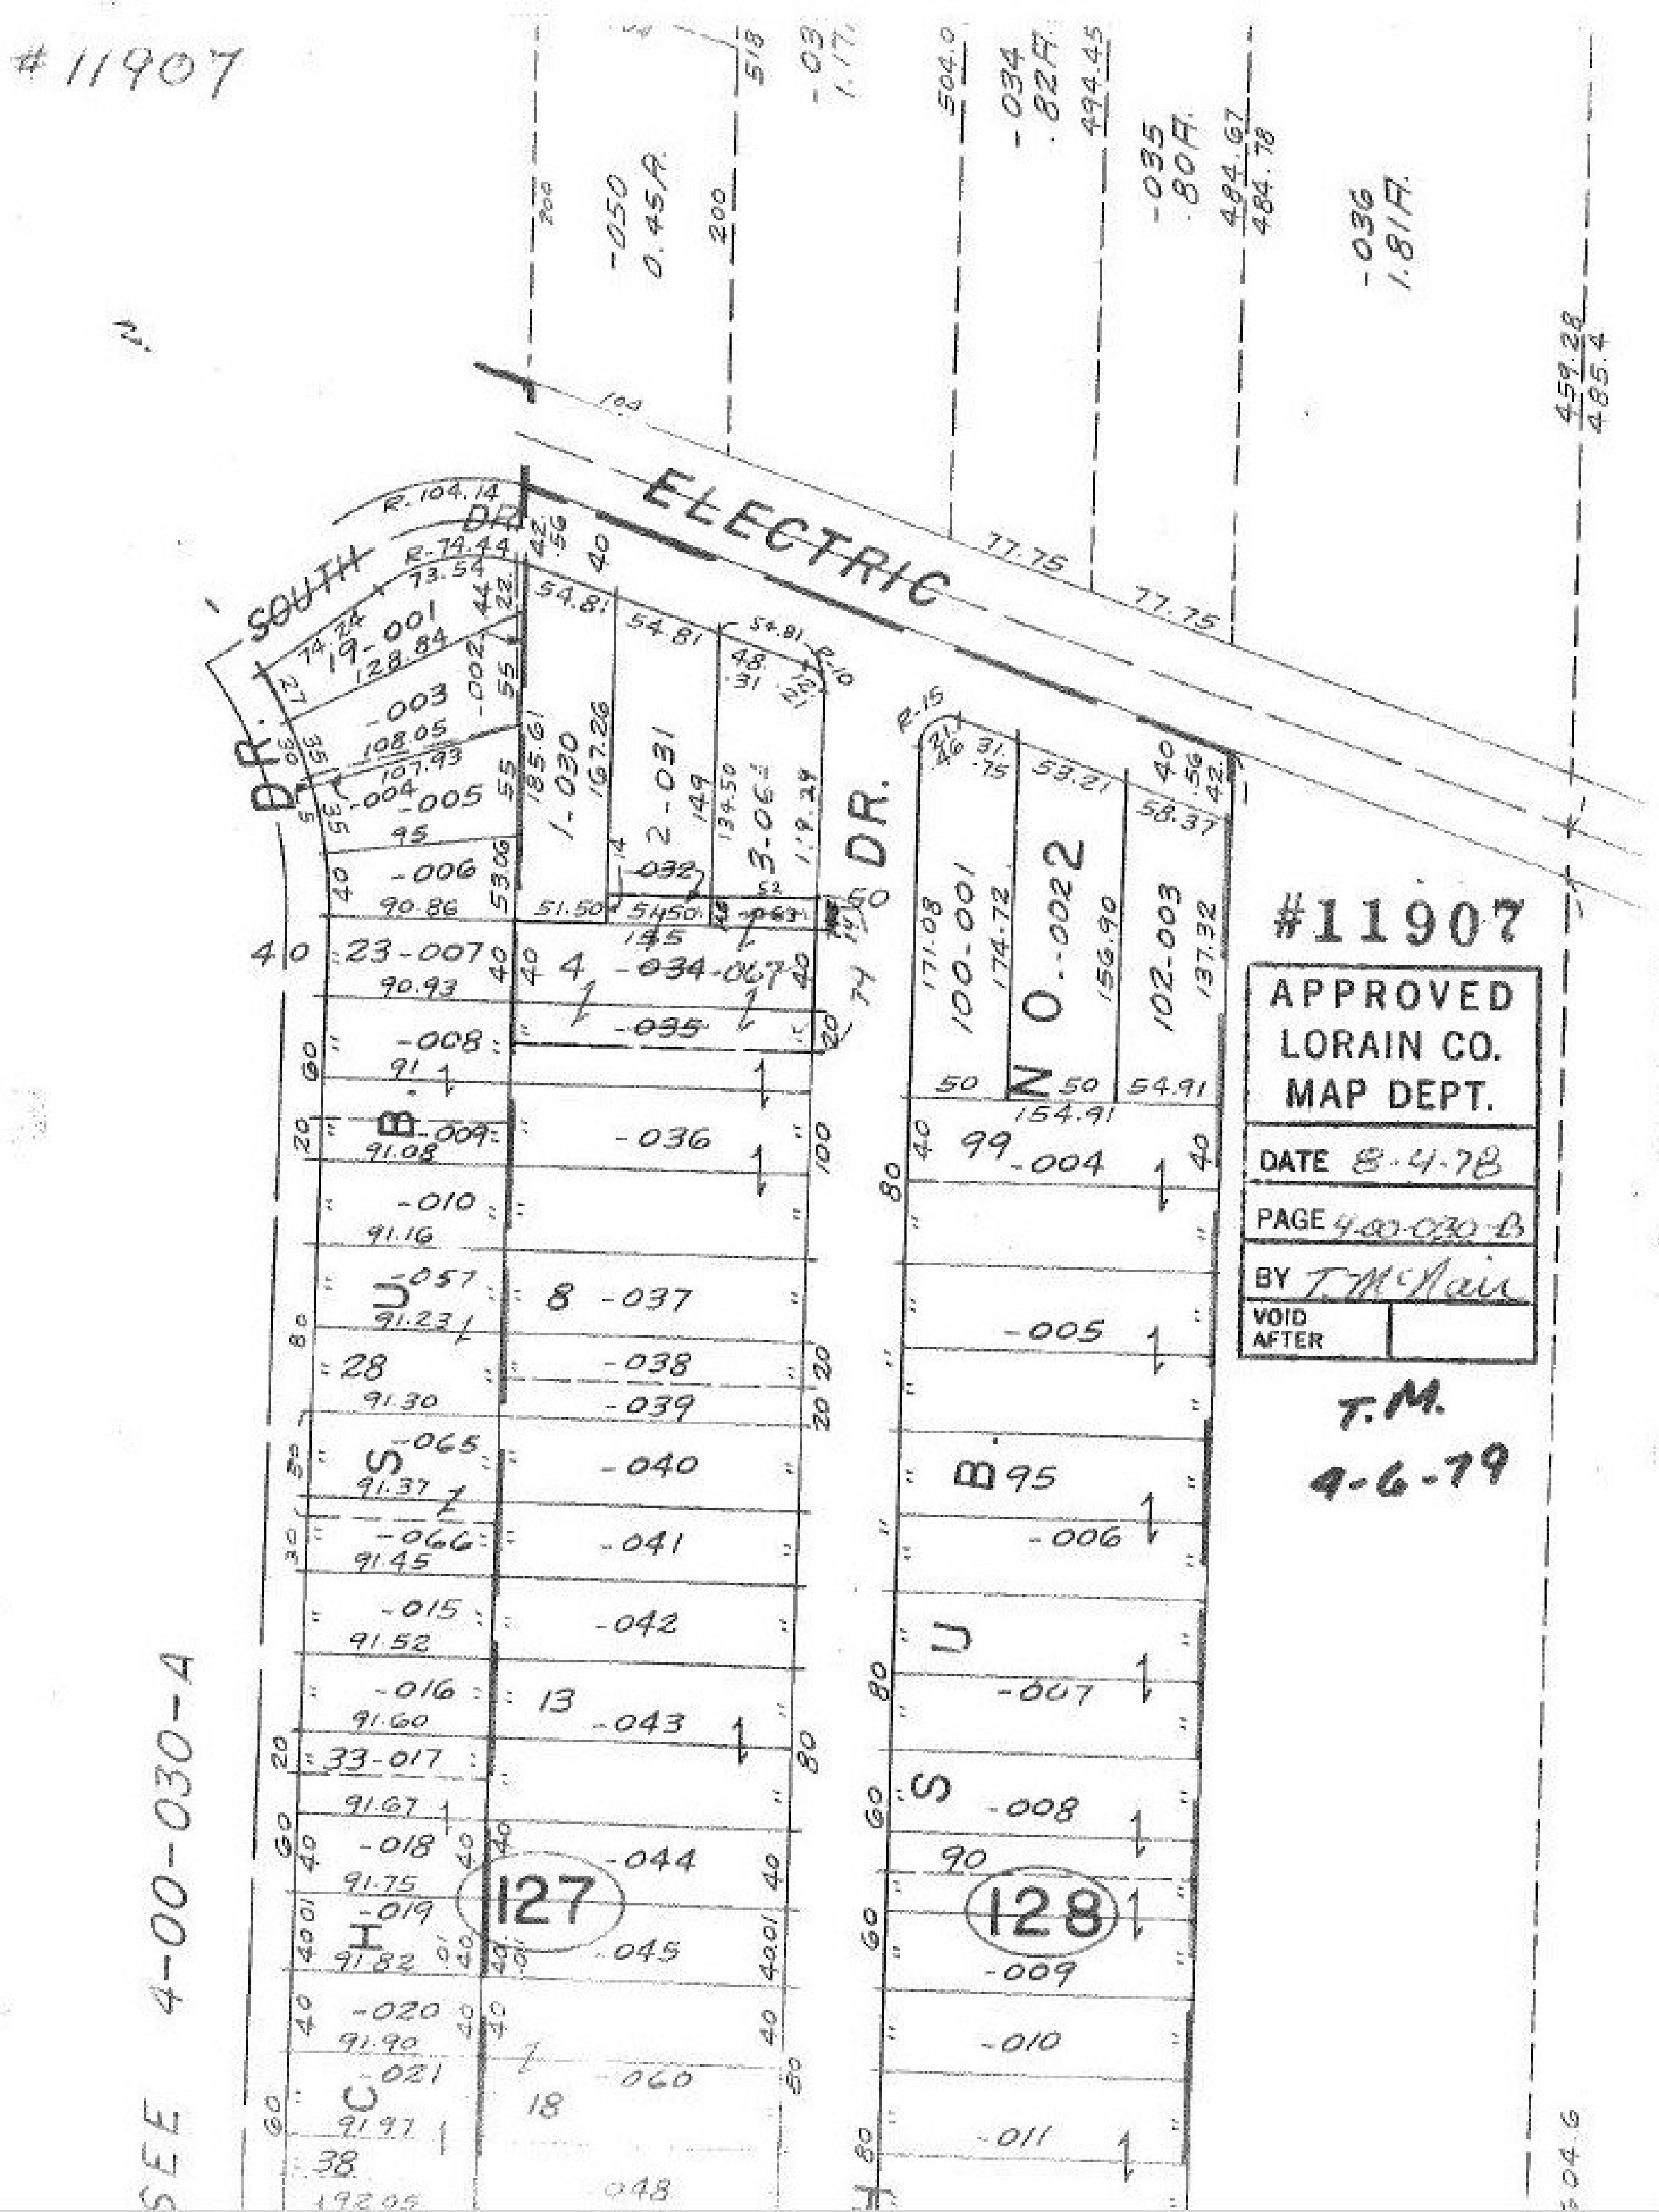
#11907
ELECTRIC
SOUTH DR.
DR.
SUB. NO. 2
SUB. NO. 2
127
128
#11907
APPROVED
LORAIN CO.
MAP DEPT.
DATE 8-4-78
PAGE 4-00-030-B
BY T. McNair
VOID AFTER
T.M.
4-6-79
SEE 4-00-030-A