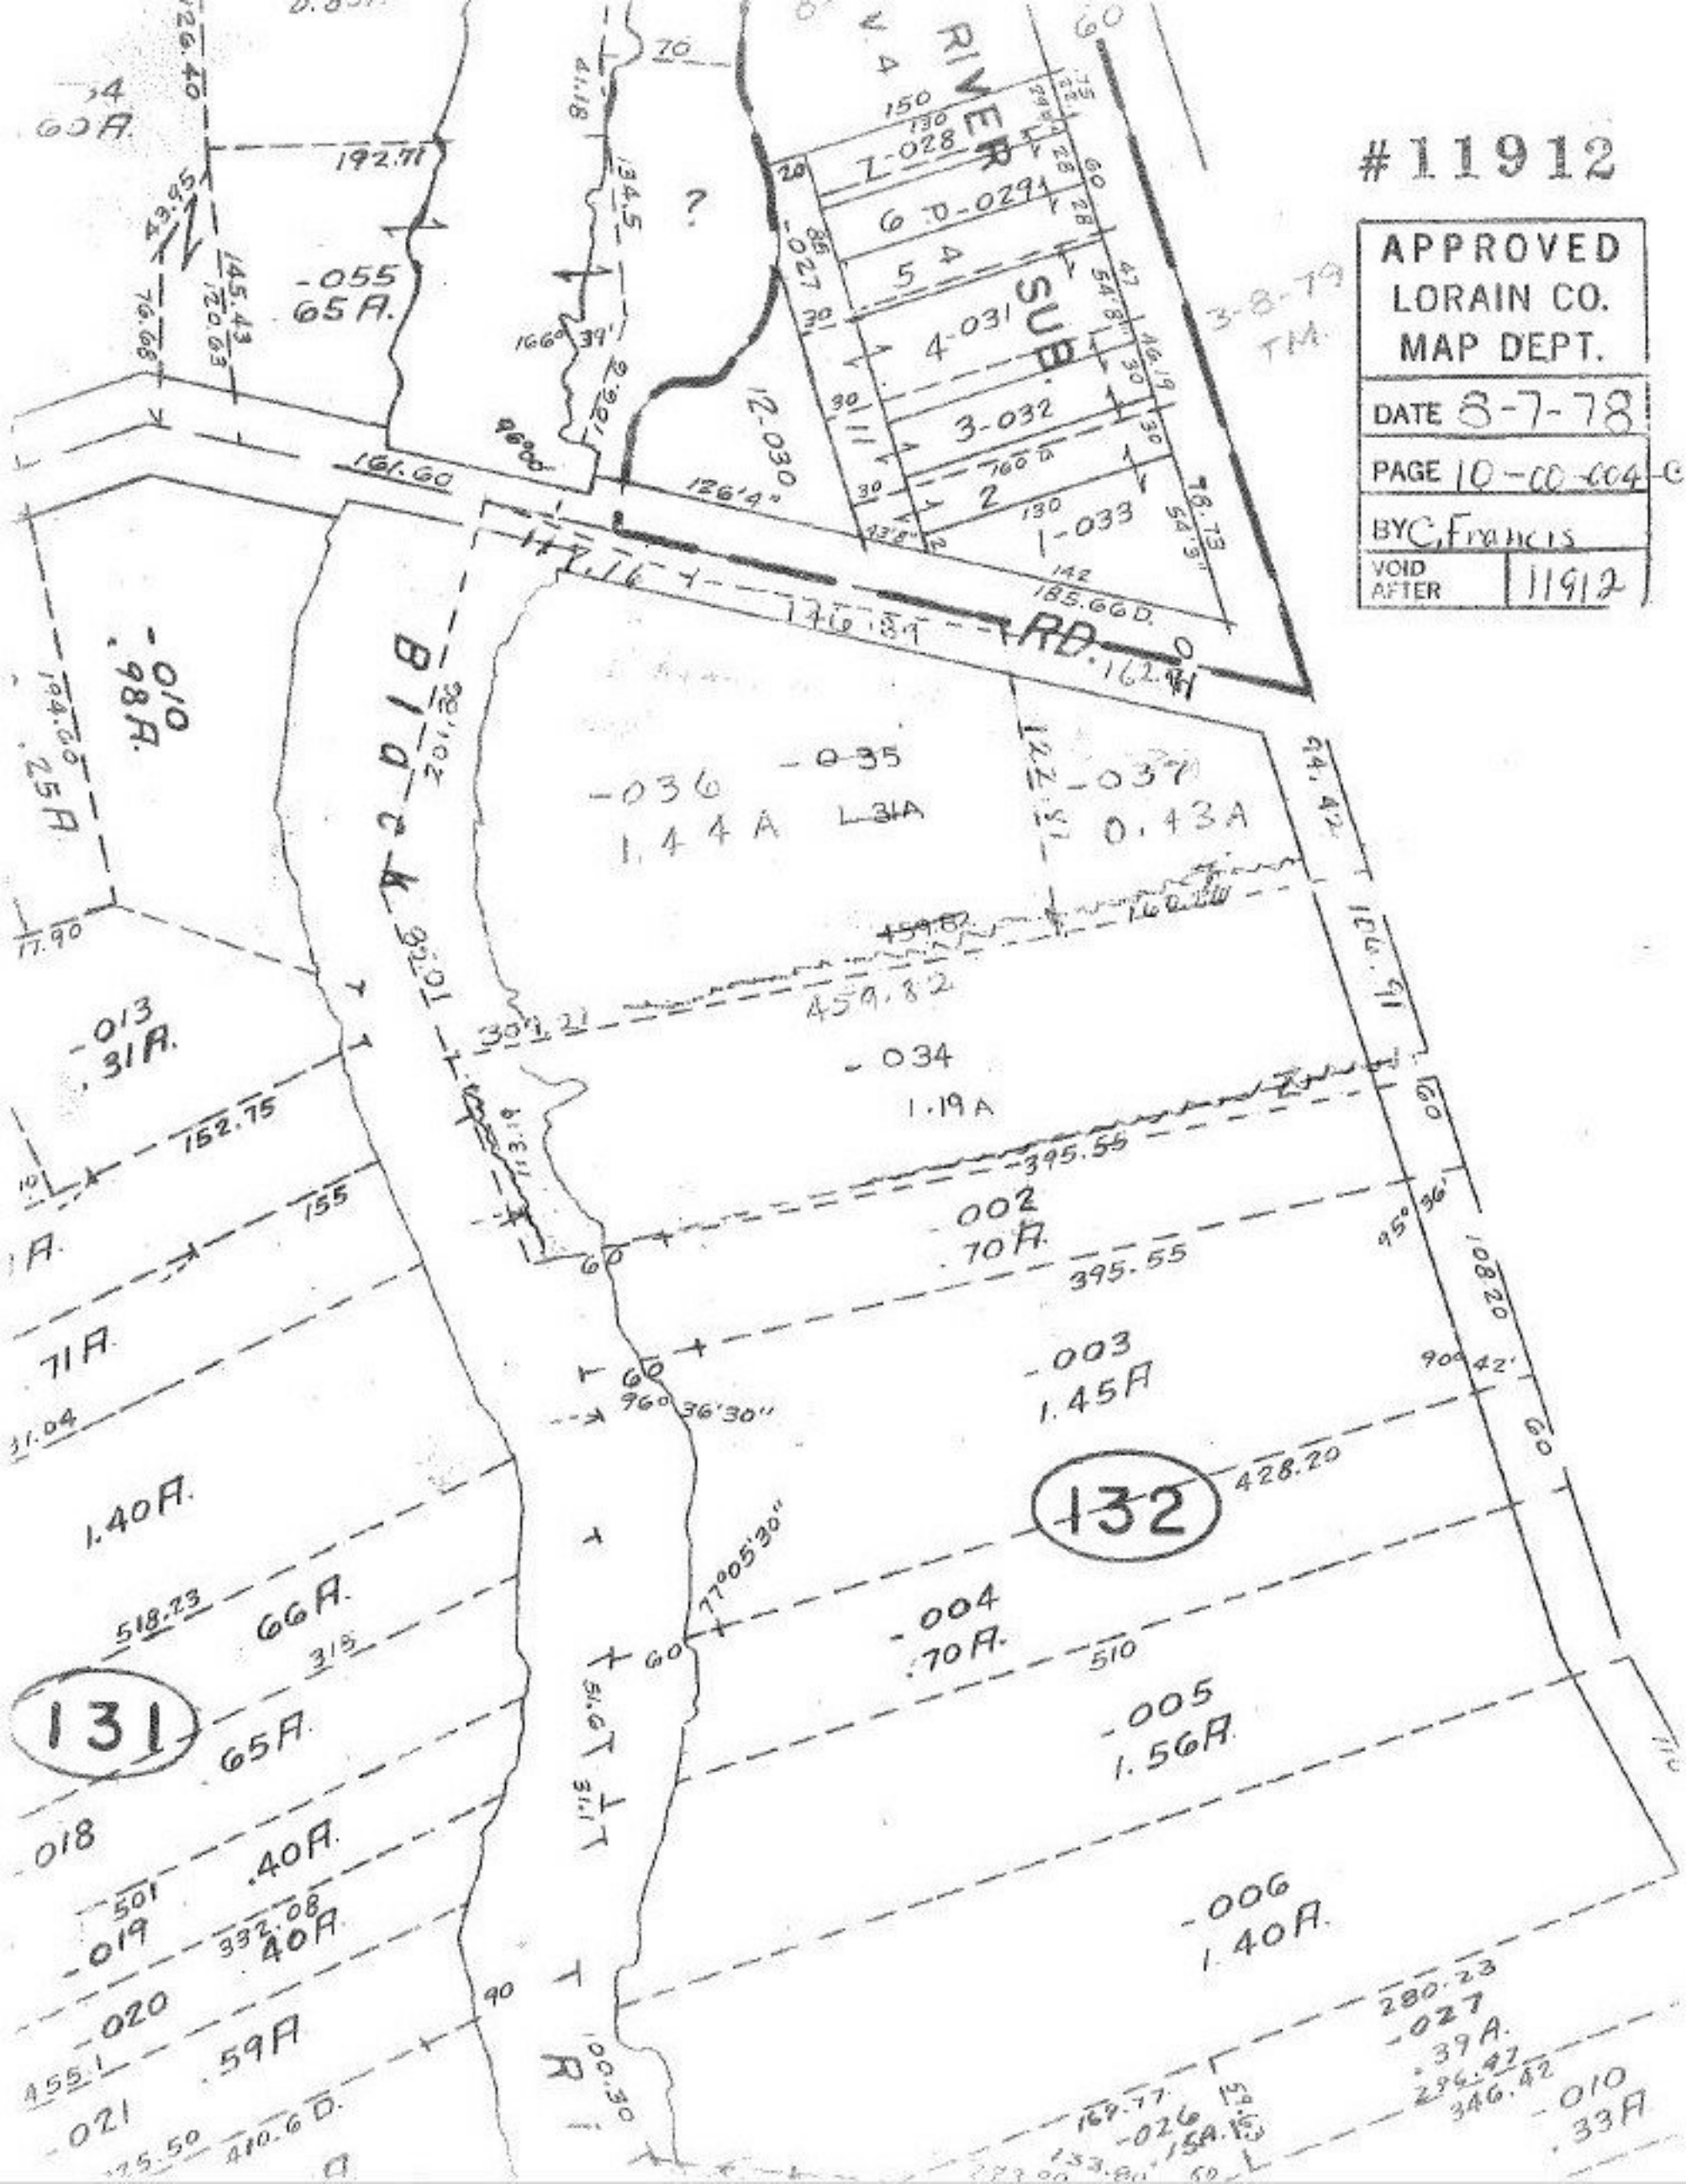

#11912
APPROVED
LORAIN CO.
MAP DEPT.
DATE 8-7-78
PAGE 10-00-004-C
BY C. Francis
VOID AFTER 11912
RIVER SUB.
RD.
Black
-036
1.44A
-037
0.43A
-034
1.19A
-002
.70A.
-003
1.45A
-004
.70A.
-005
1.56A.
-006
1.40A.
132
131
-055
65A.
-010
.98A.
-013
.31A.
-018
.40A.
-019
.40A.
-020
.59A
-021
-010
.33A
-027
.39A.
-026