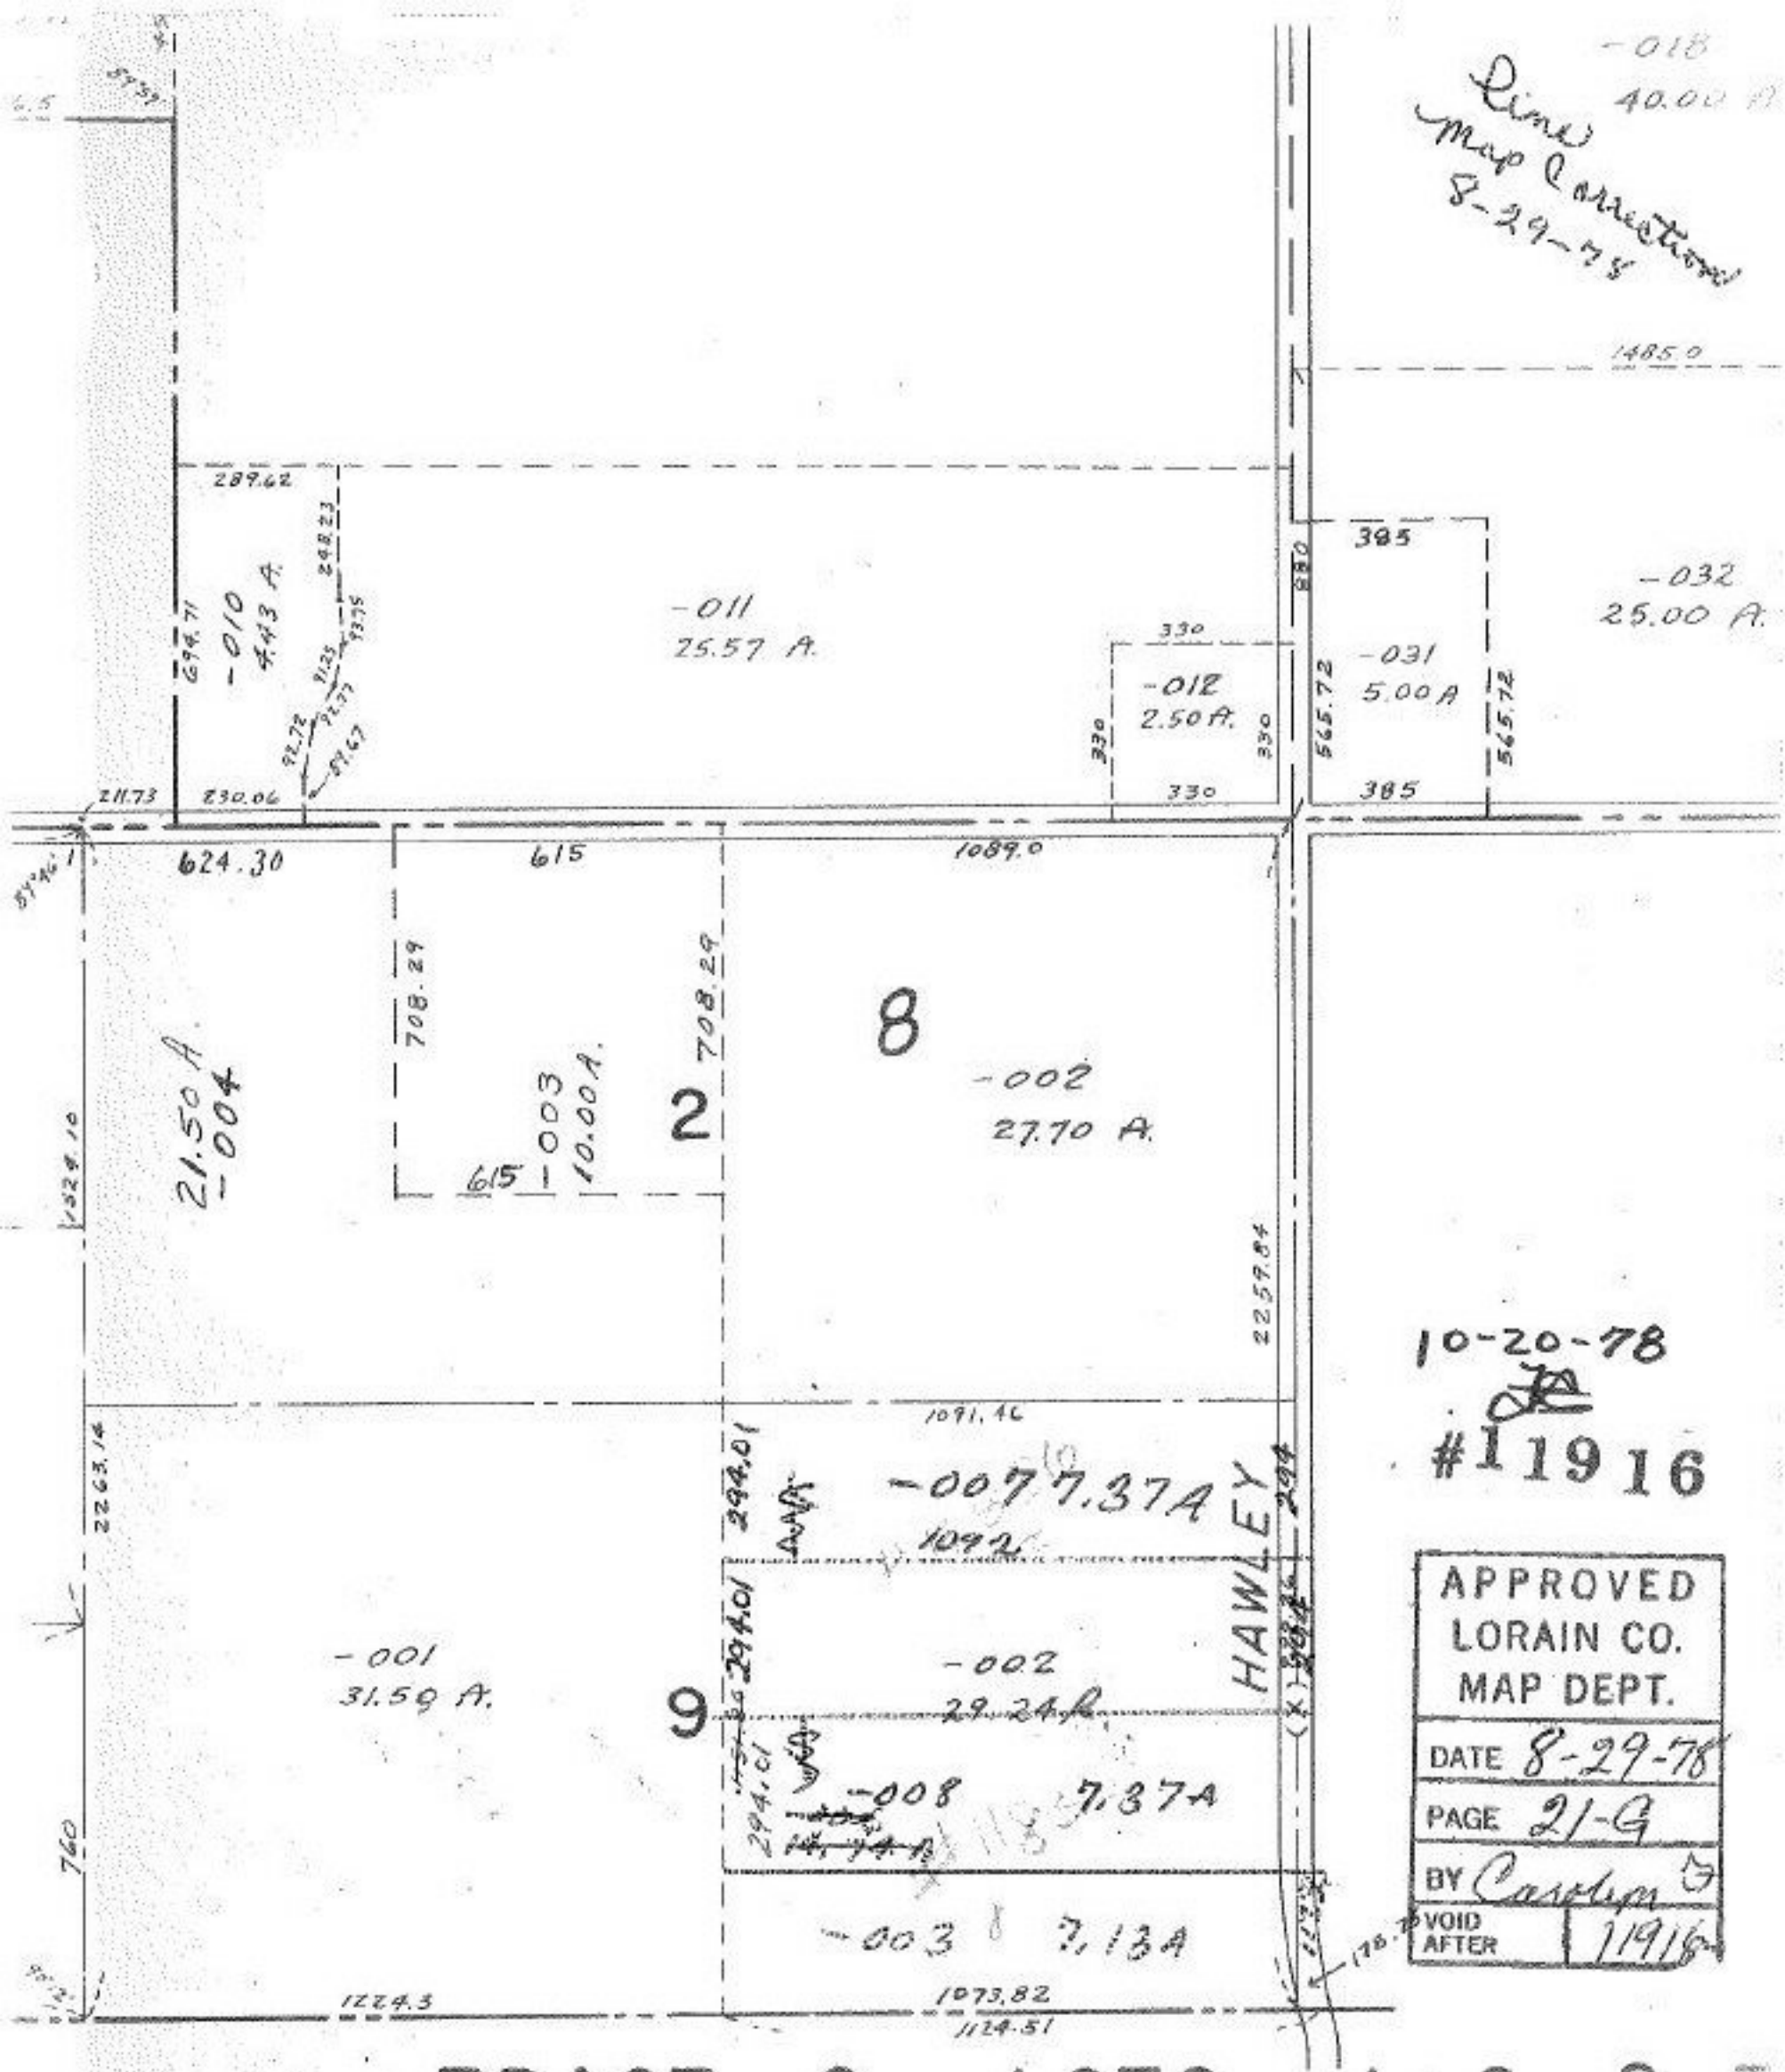

10-20-78

#11916

APPROVED
LORAIN CO.
MAP DEPT.

DATE 8-29-78

PAGE 21-G

BY Carolyn

VOID AFTER 11916

TRACT 8 LOTS 1, 2, 9 T
TRACTS 9, 10, 11, 13, 14, 15
TRACT 17 LOT 15