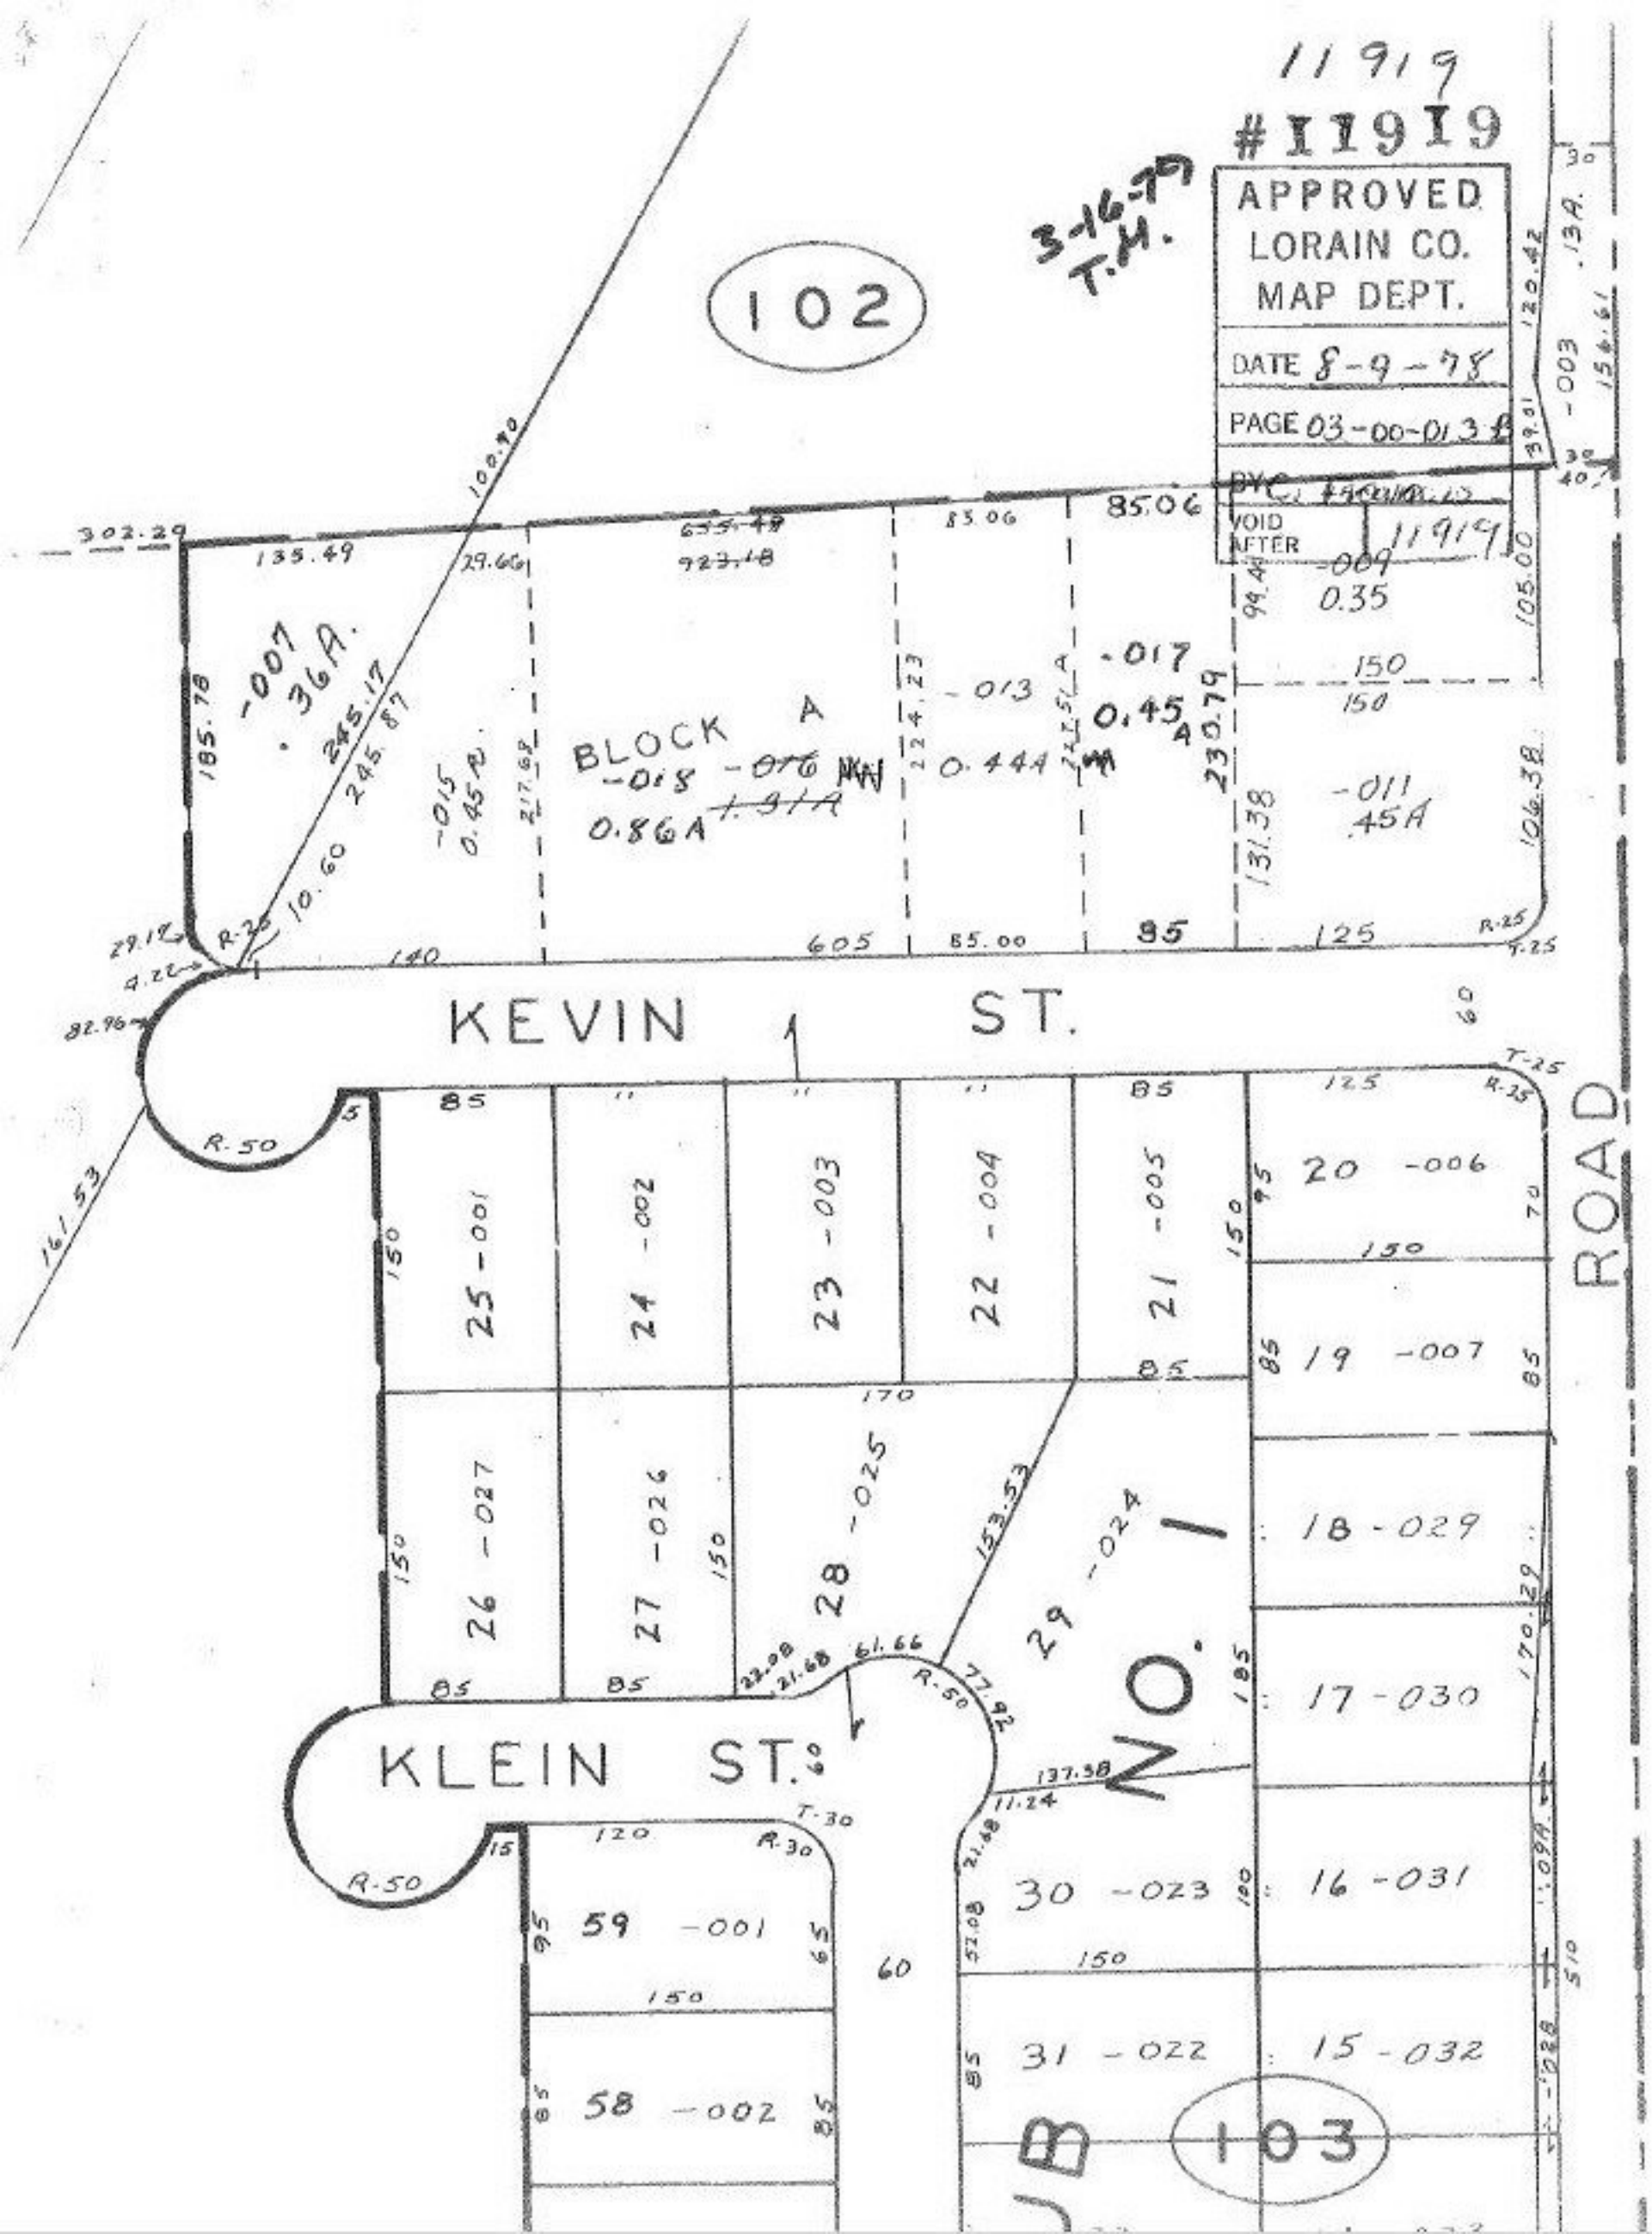
11919
#11919
APPROVED
LORAIN CO.
MAP DEPT.
DATE 8-9-78
PAGE 03-00-013 B
VOID AFTER 11919
3-16-79 T.H.
102
BLOCK A
-018 -016
0.86A
-015 0.45A
-013
0.44A
-017
0.45A
-009
0.35
-011
.45A
-007
.36A
KEVIN ST.
KLEIN ST.
ROAD
NO. 1
103
25 -001
24 -002
23 -003
22 -004
21 -005
20 -006
19 -007
18 -029
17 -030
16 -031
15 -032
26 -027
27 -026
28 -025
29 -024
30 -023
31 -022
59 -001
58 -002
-003
.13A.
302.29
135.49
29.66
100.90
85.06
85.00
85
125
140
605
185.78
245.17
245.87
10.60
217.68
224.23
230.79
131.38
106.38
105.00
120.42
156.61
39.01
29.19
4.22
82.96
161.53
153.53
61.66
77.92
137.38
11.24
21.68
52.08
170.29
120
150
170
60