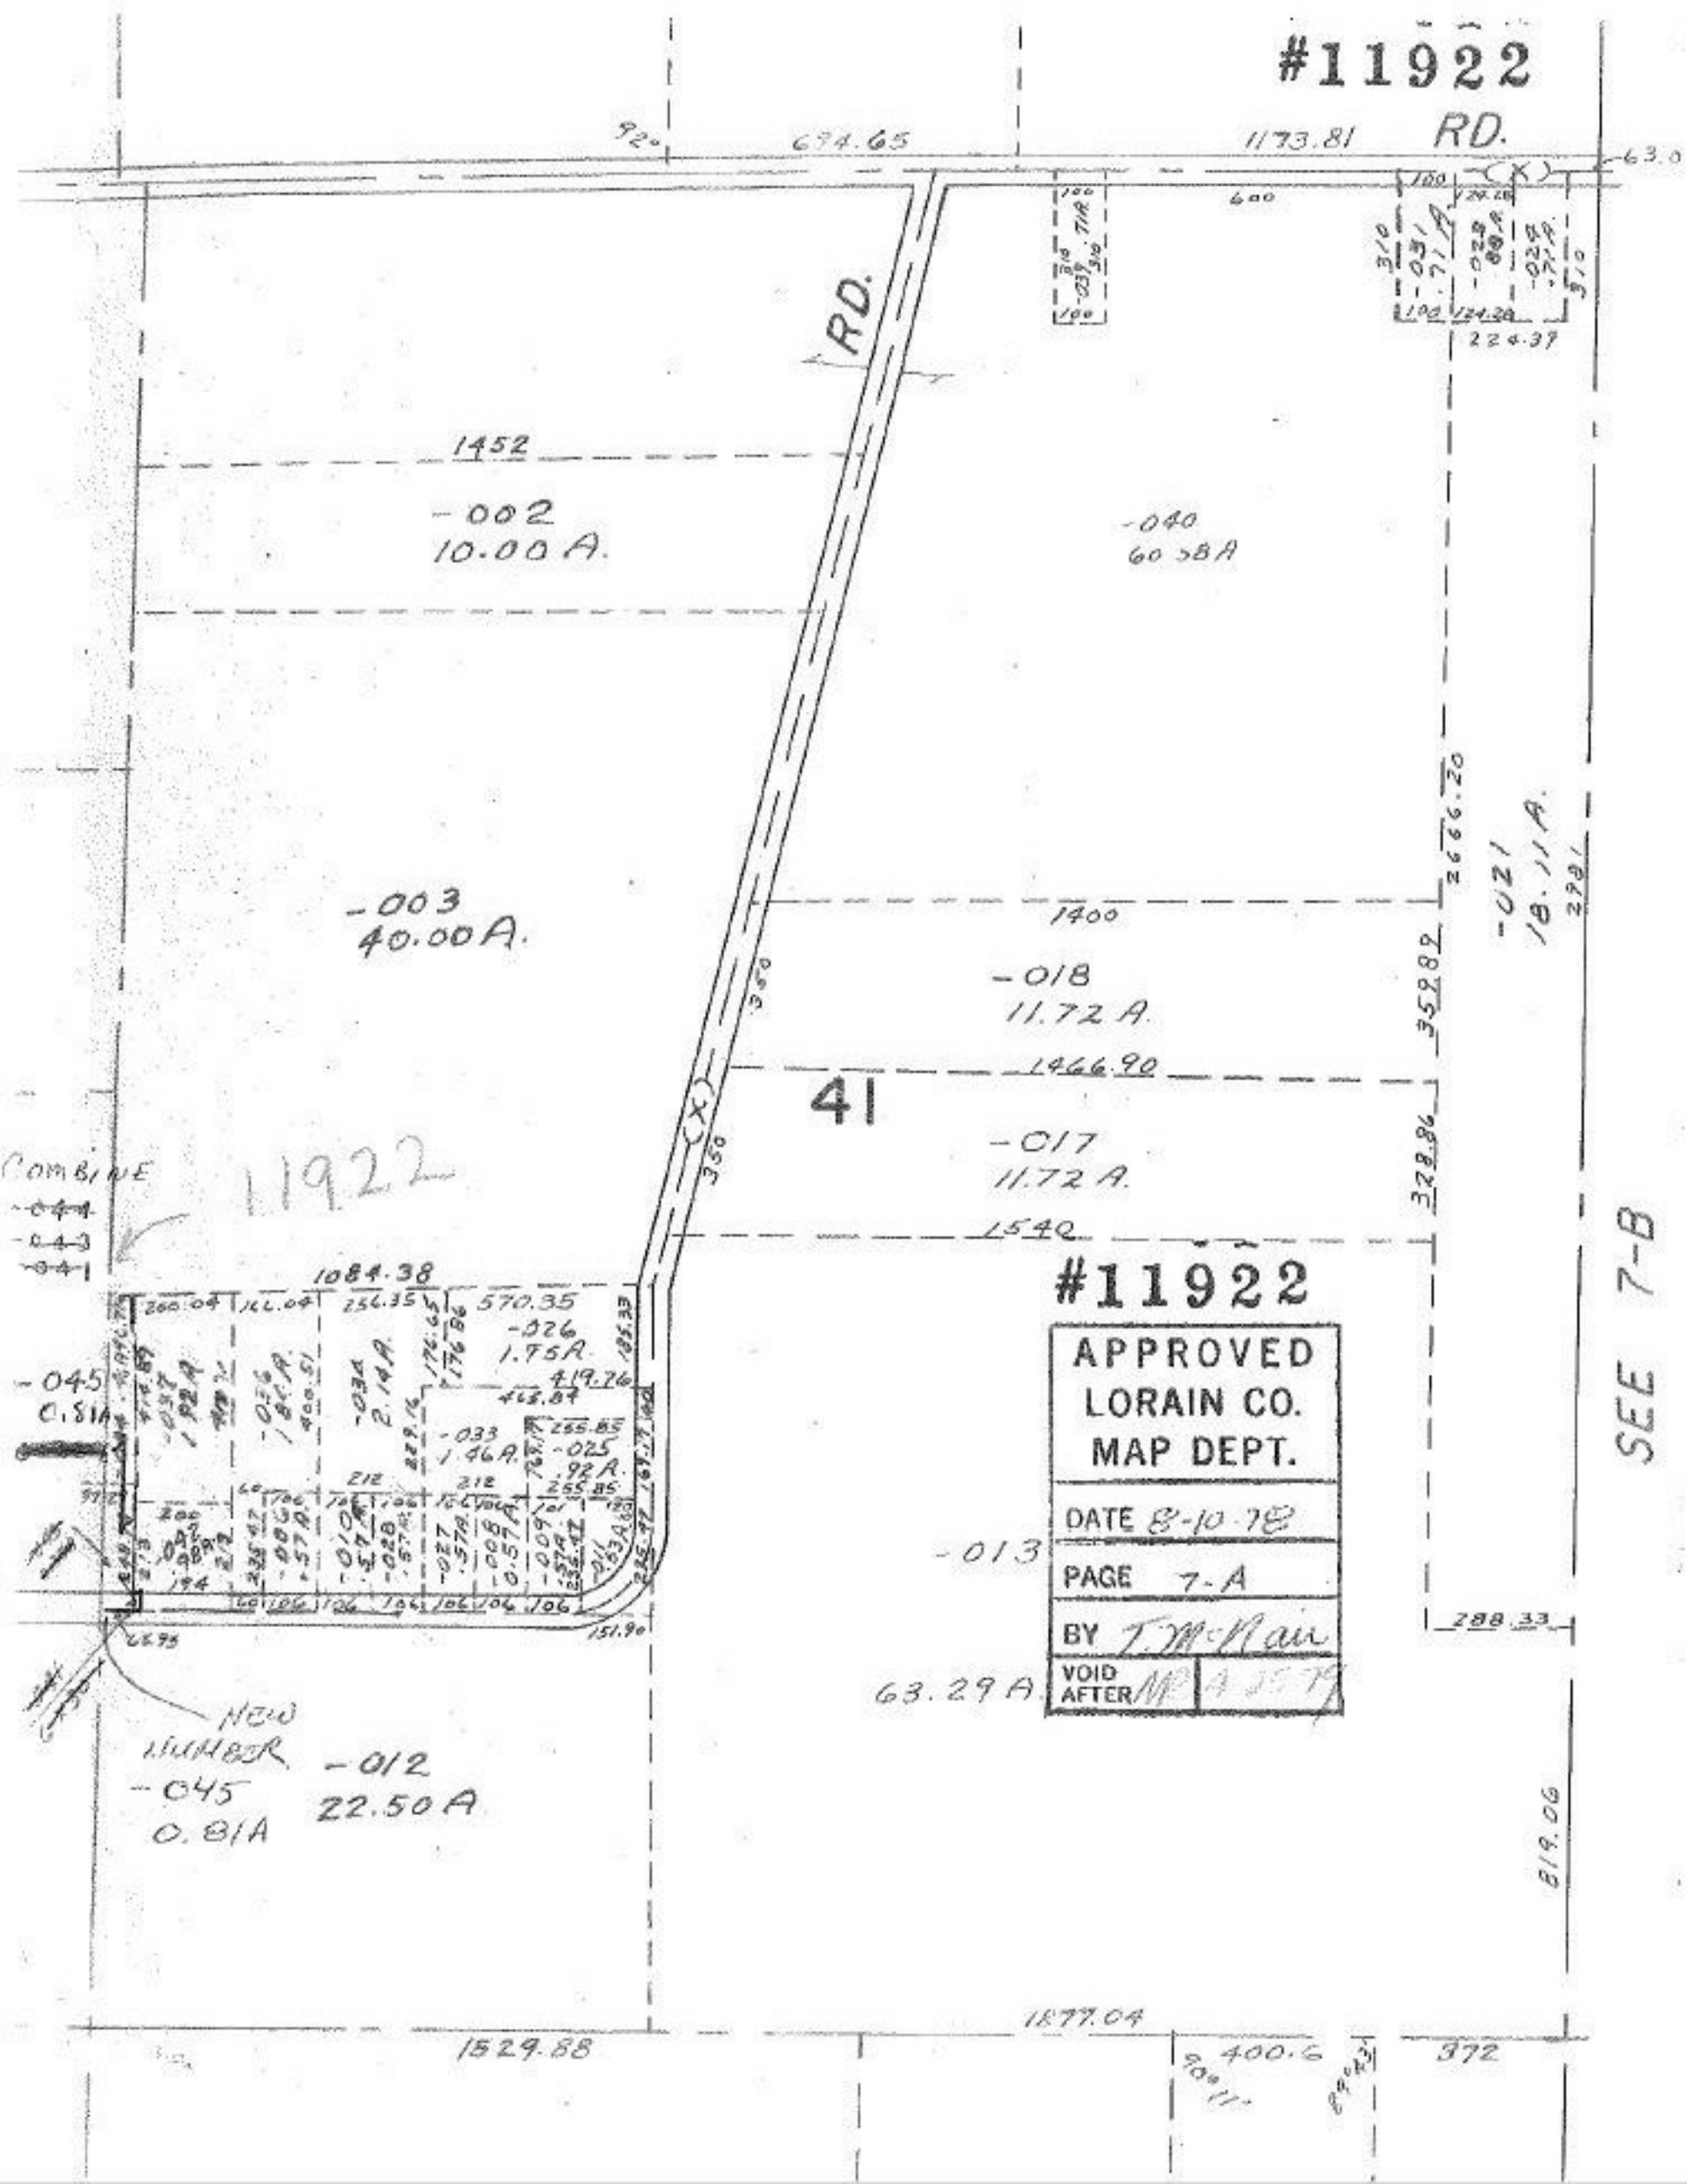
#11922
RD.
694.65
1173.81
63.0
600
RD.
1452
-002
10.00 A.
-040
60.58 A
-003
40.00 A.
1400
-018
11.72 A.
1466.90
41
-017
11.72 A.
1540
COMBINE
11922
1084.38
570.35
-026
1.75 A.
419.76
-045
0.81 A
-033
1.46 A.
-025
.92 A.
-013
63.29 A.
NEW NUMBER
-045
0.81 A
-012
22.50 A
1529.88
1877.04
400.6
372
819.06
288.33
328.86
359.89
2666.20
-021
18.11 A.
2981
SEE 7-B
#11922
APPROVED
LORAIN CO.
MAP DEPT.
DATE 8-10-78
PAGE 7-A
BY T. McNair
VOID AFTER