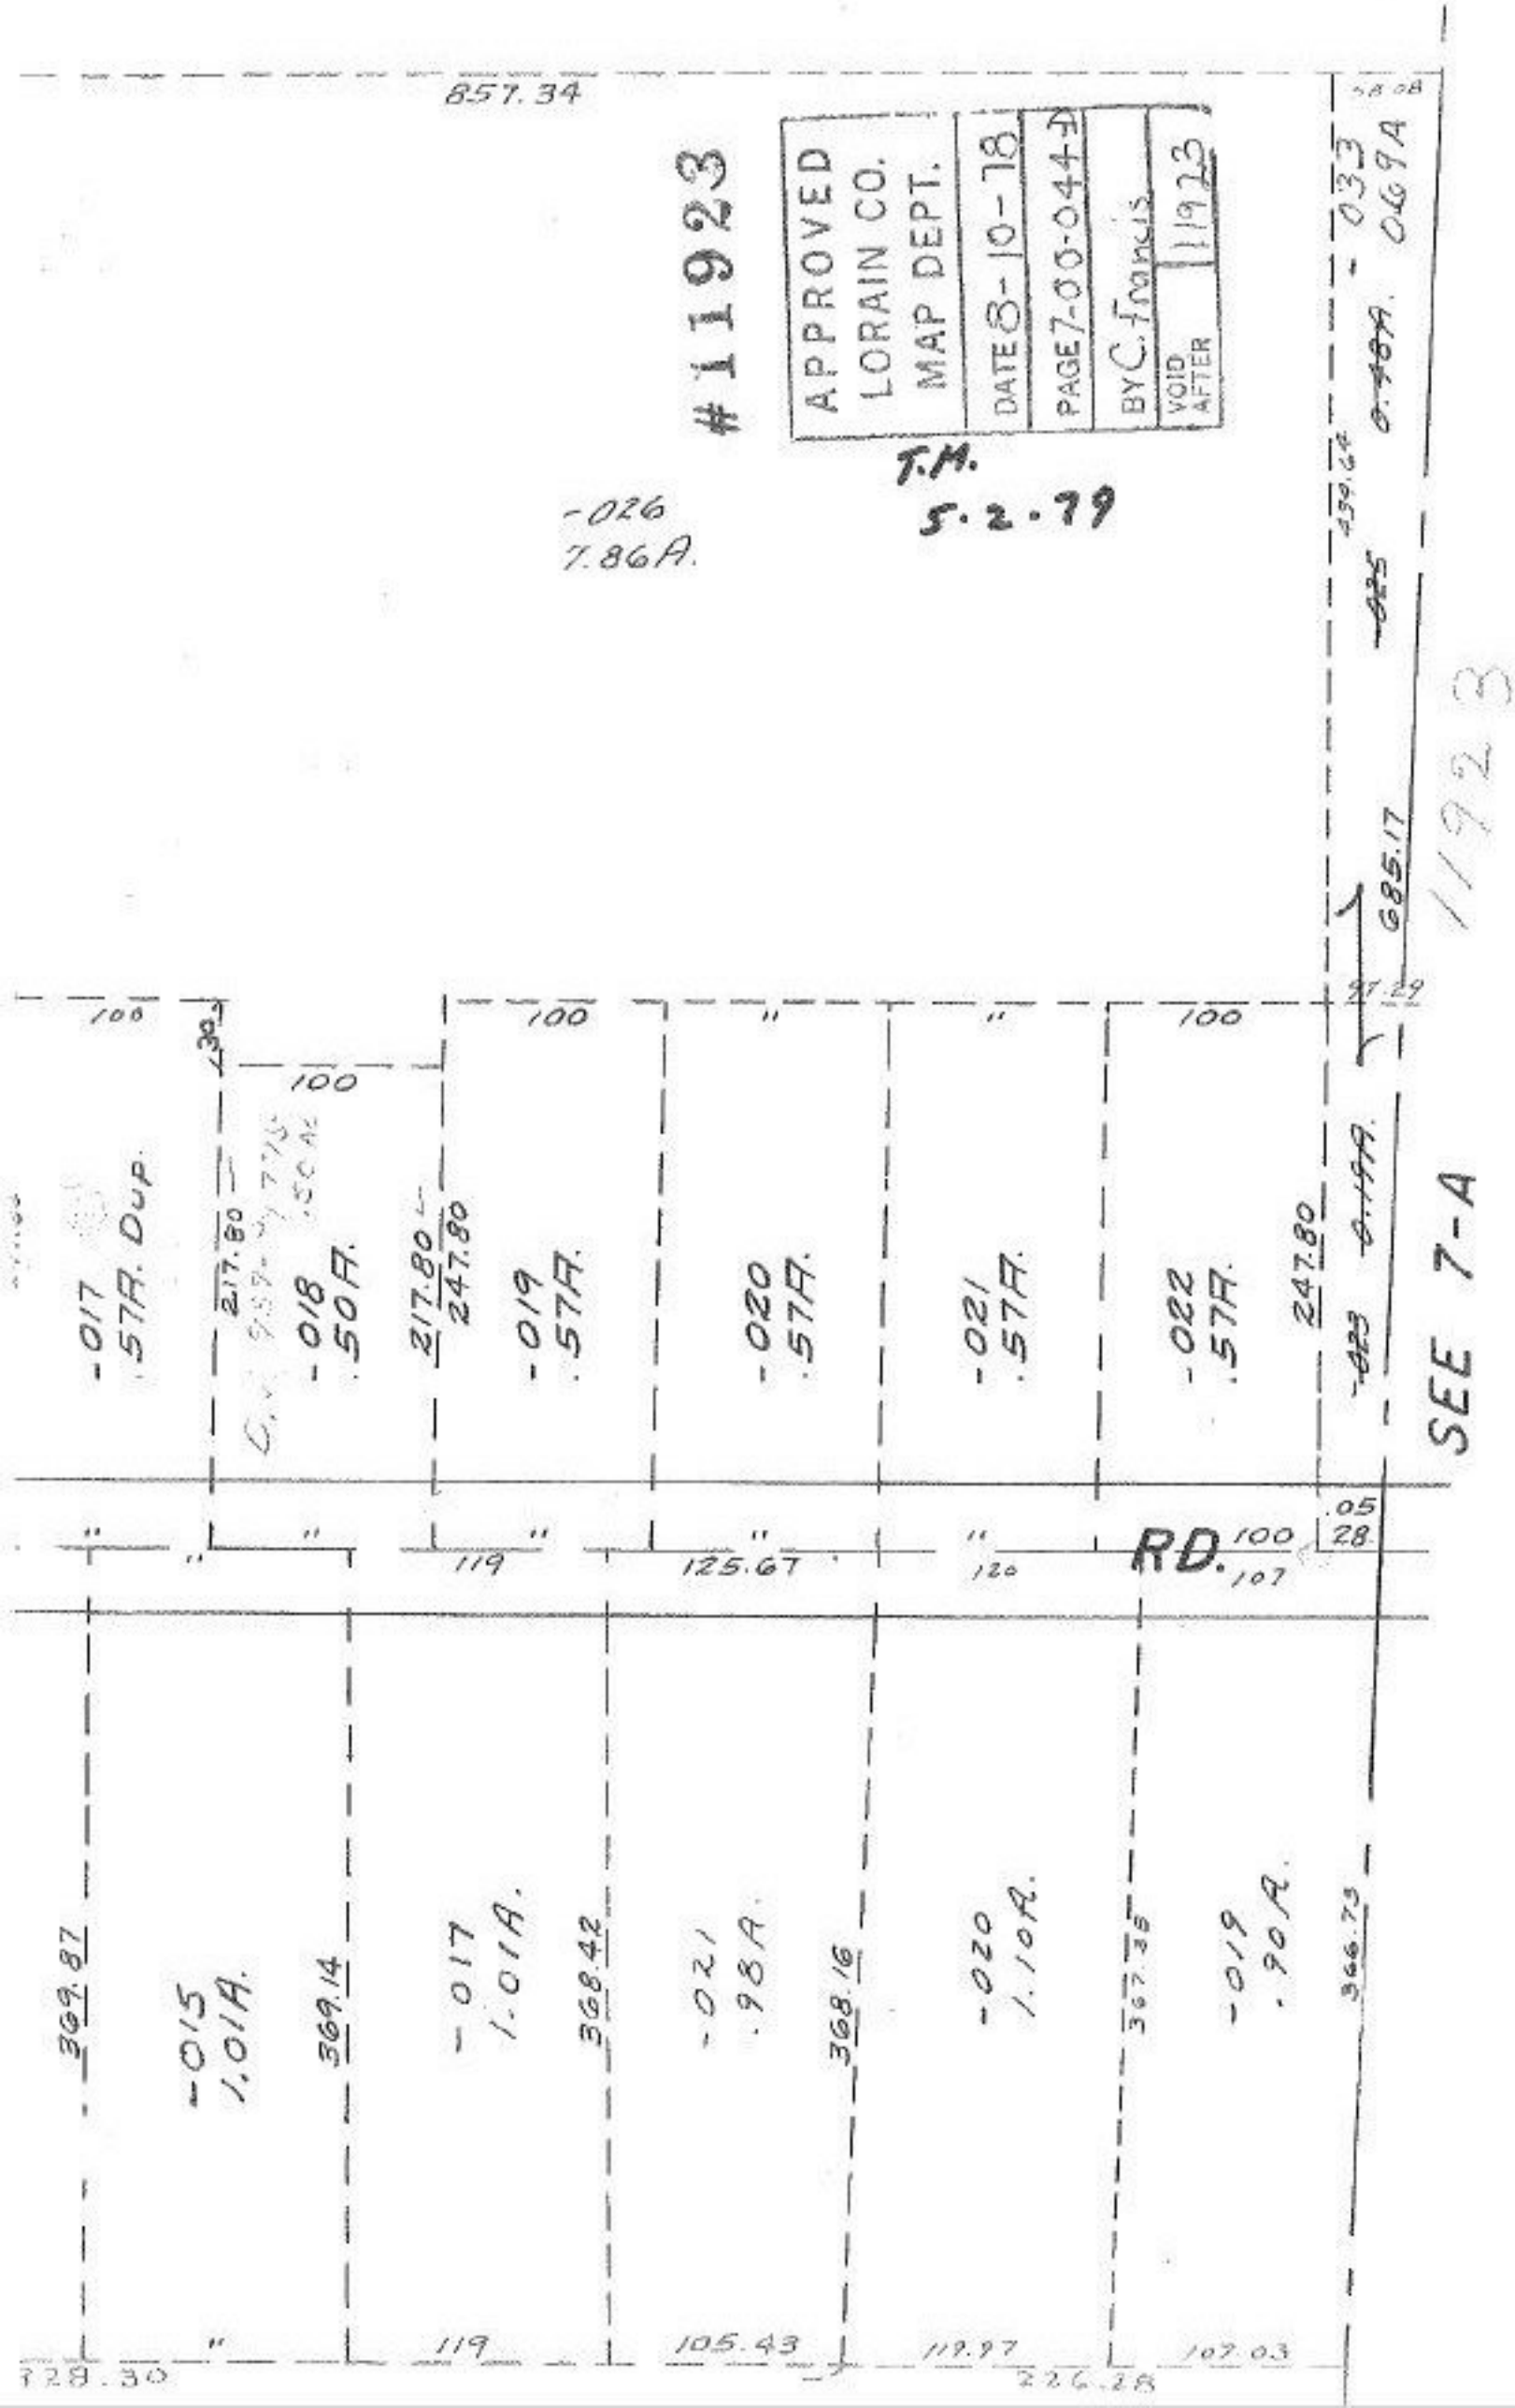

857.34
#11923
APPROVED
LORAIN CO.
MAP DEPT.
DATE 8-10-78
PAGE 7-00-044-D
BY C. Francis
VOID AFTER 11923
T.M.
5.2.79
-026
7.86A.
-033
0.69A
685.17
11923
SEE 7-A
-017
.57A. Dup.
-018
.50A.
217.80
247.80
-019
.57A.
-020
.57A.
-021
.57A.
-022
.57A.
247.80
RD.
100
107
.05
28
119
125.67
120
369.87
-015
1.01A.
369.14
-017
1.01A.
368.42
-021
.98A.
368.16
-020
1.10A.
367.38
-019
.90A.
366.73
119
105.43
119.97
107.03
228.30
226.28