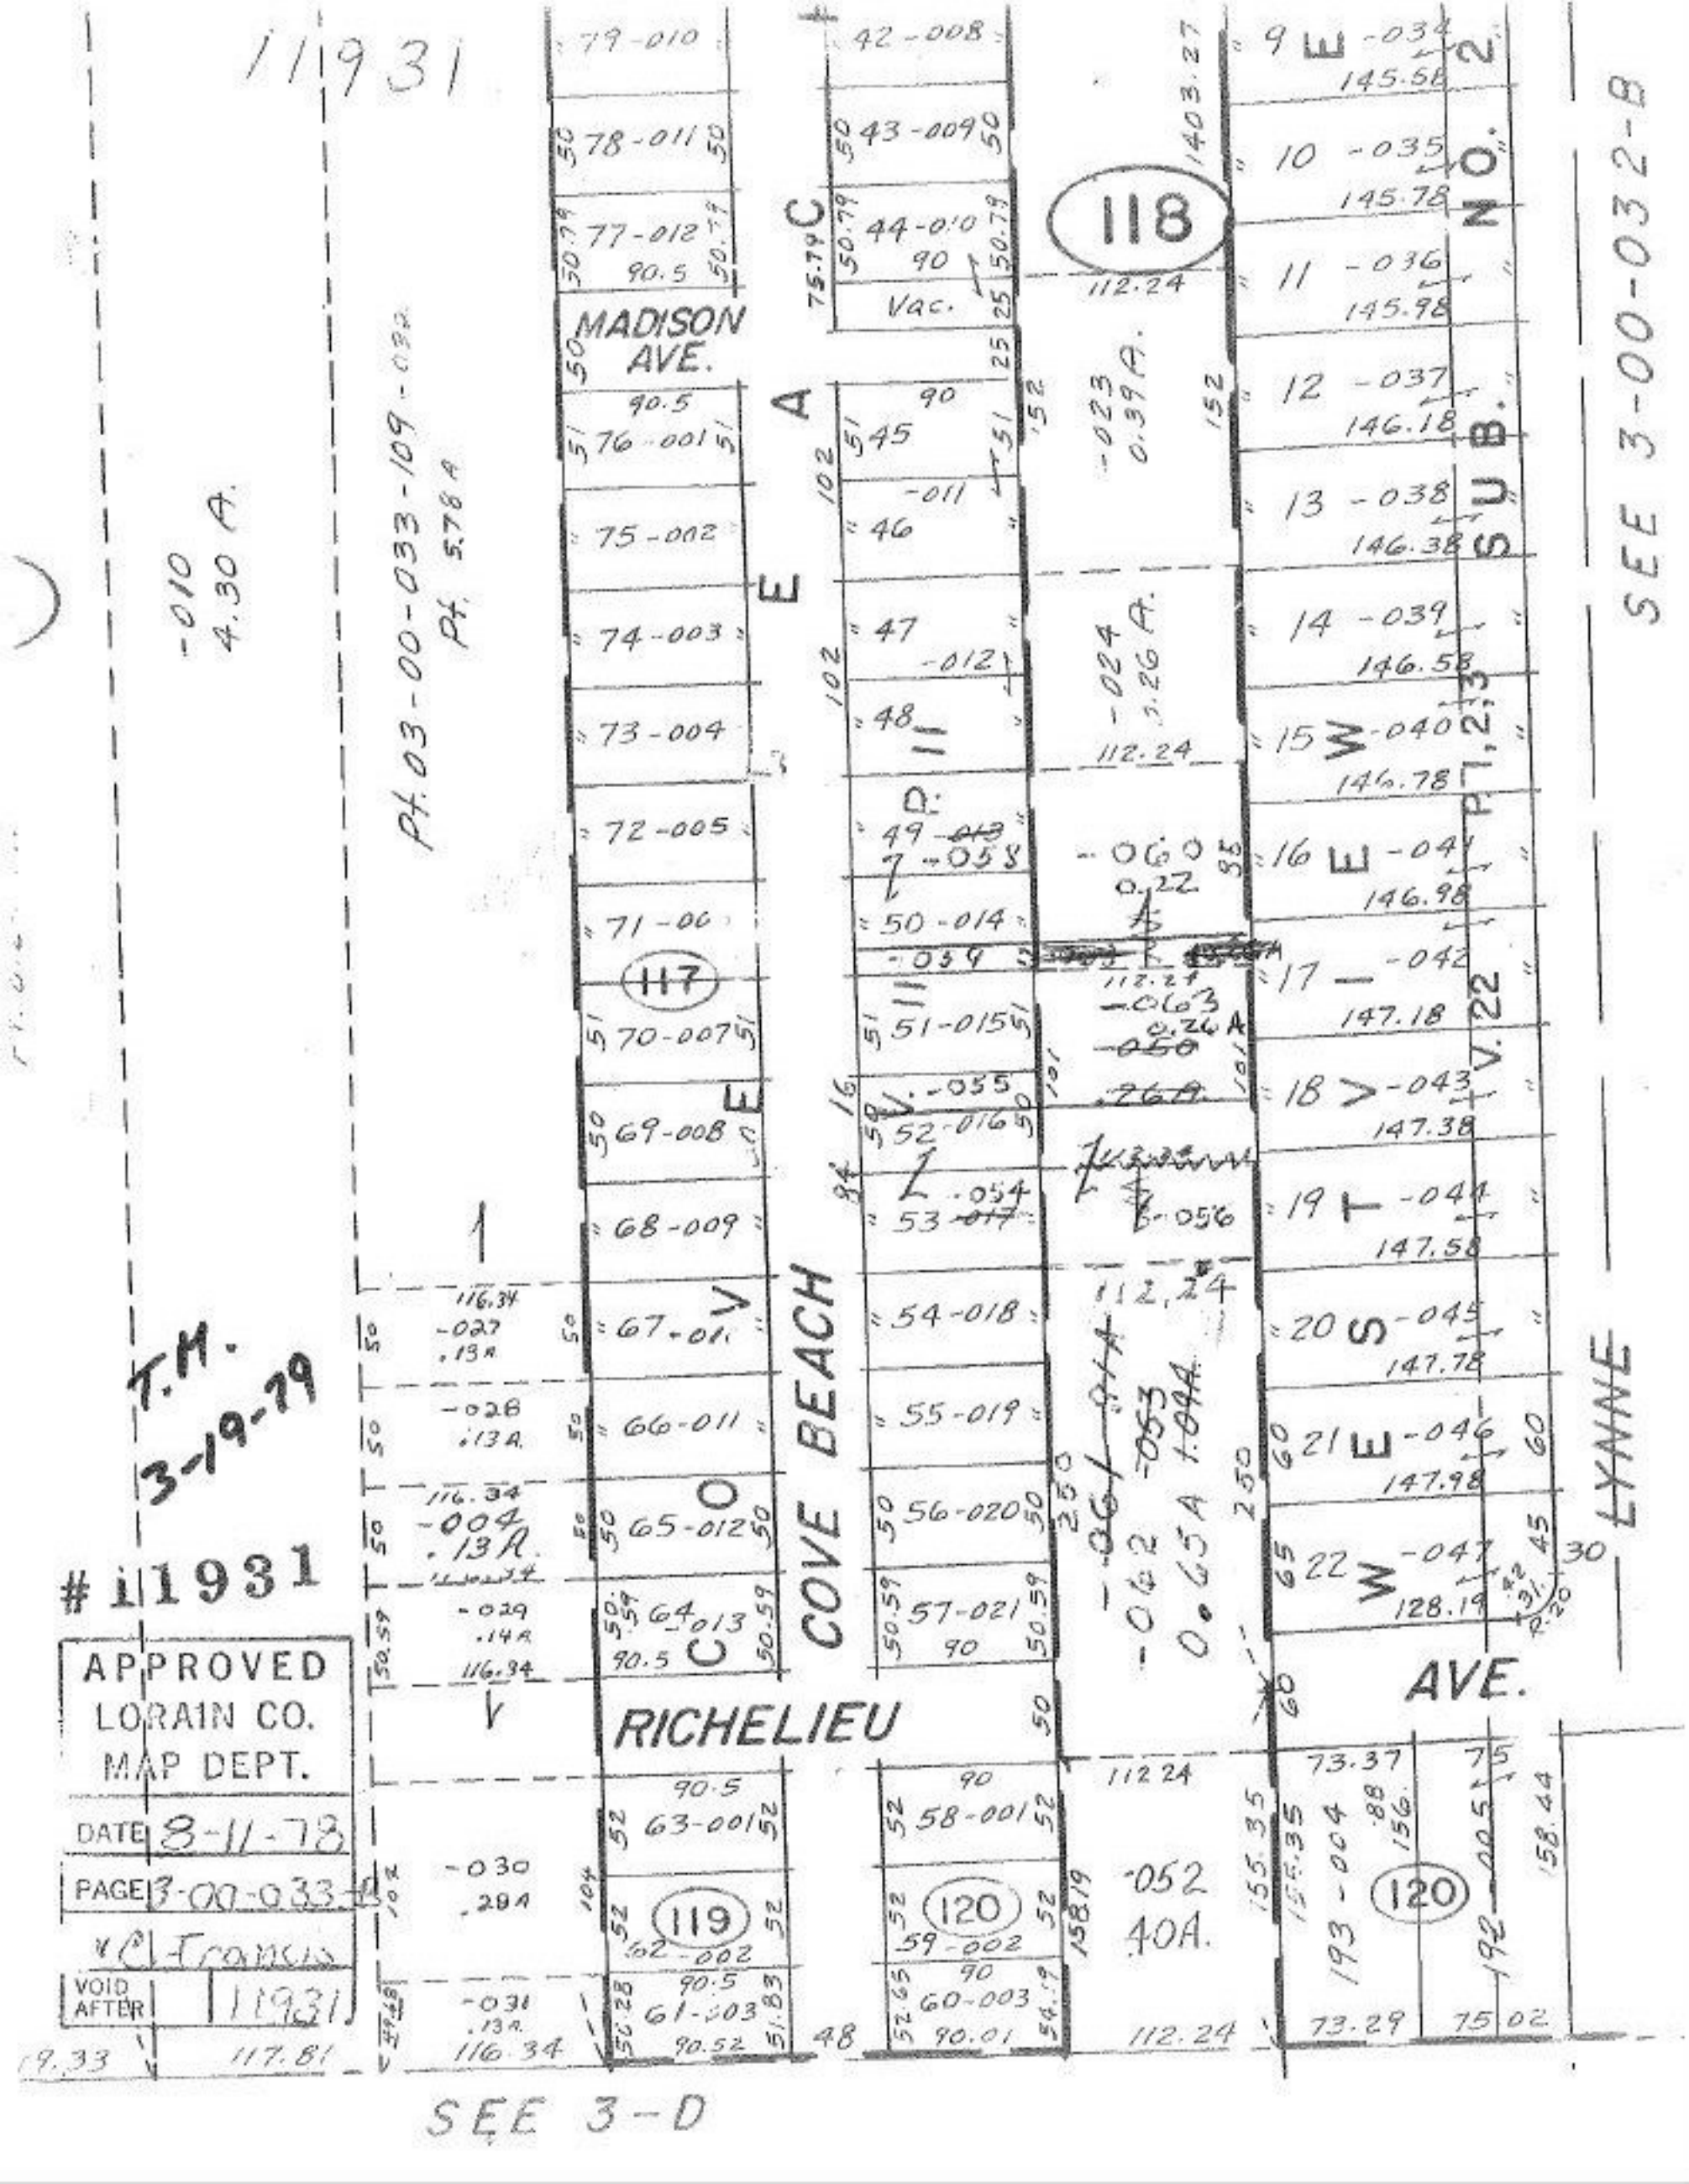

11931
MADISON AVE.
COVE BEACH
RICHELIEU
AVE.
LYNNE
SUB. NO. 2
SEE 3-00-032-B
SEE 3-D
T.M. 3-19-79
#11931
APPROVED
LORAIN CO.
MAP DEPT.
DATE 8-11-78
PAGE 3-00-033-B
VOID AFTER 11931
117
118
119
120