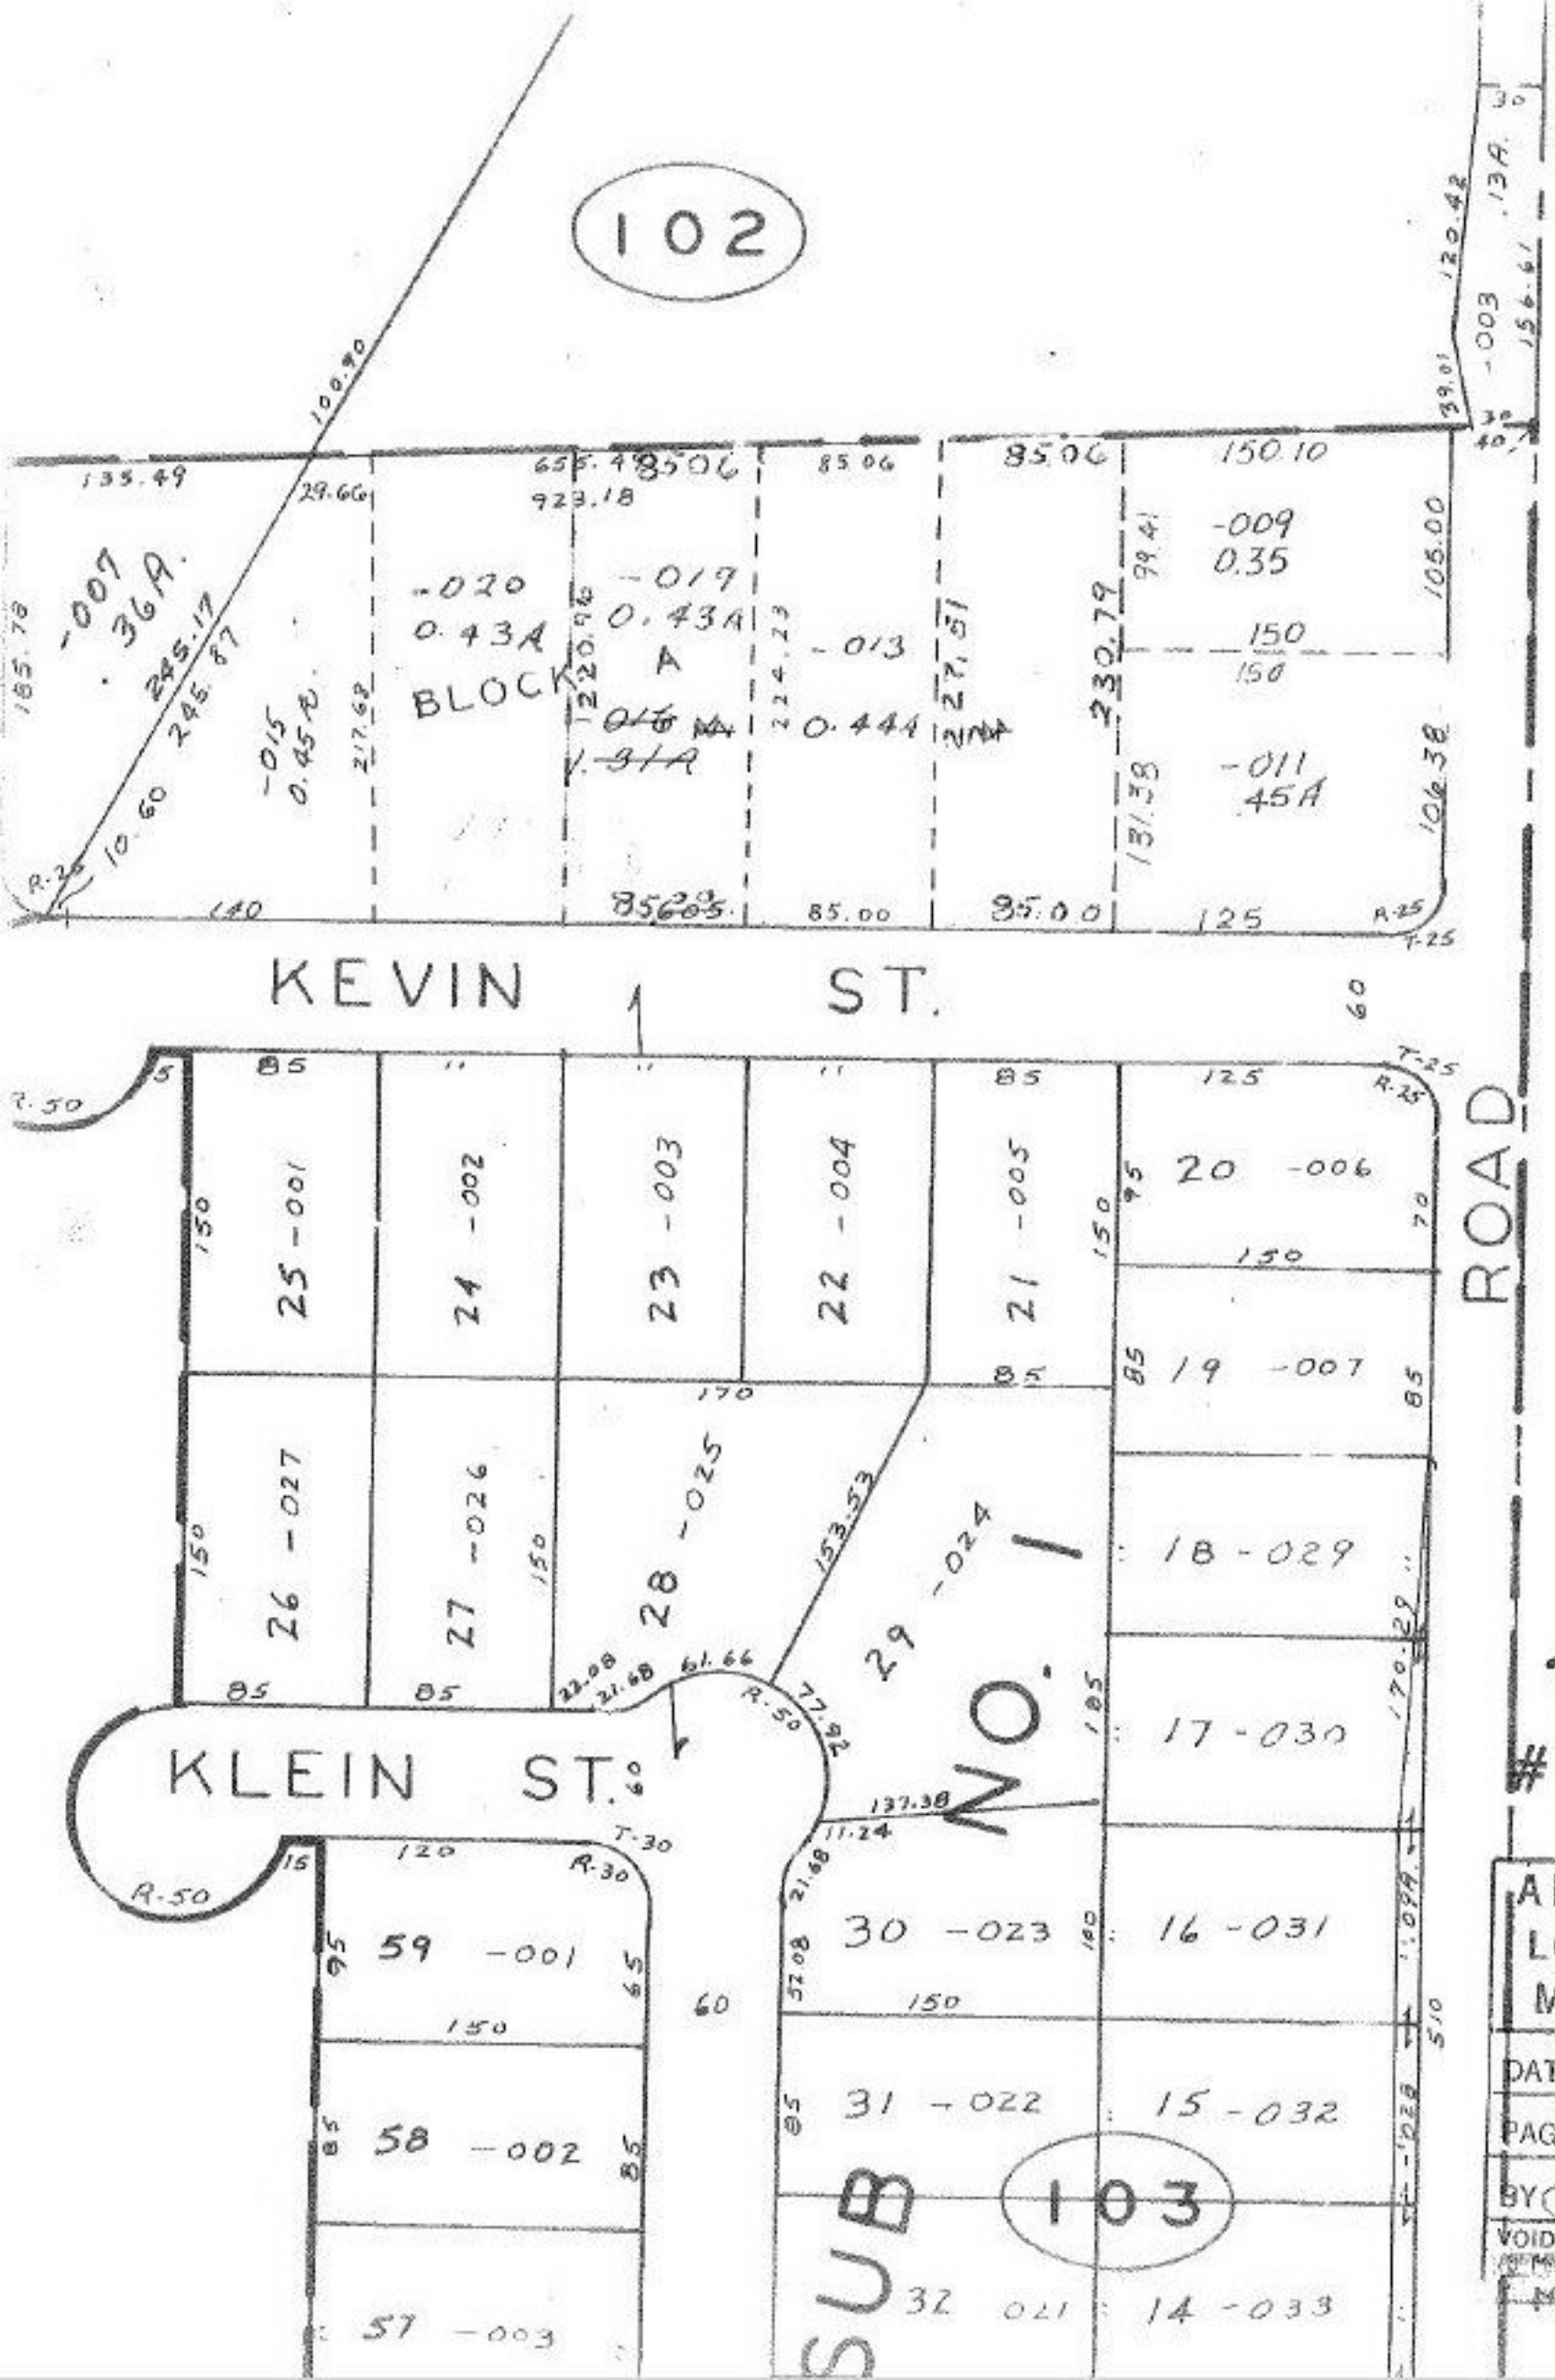
102
KEVIN ST.
KLEIN ST.
ROAD
SUB NO. 1
103
BLOCK A
-007 .36A.
-015 0.45A.
-020 0.43A
-019 0.43A
-013 0.44A
-009 0.35
-011 .45A
-003 .13A.
25 -001
24 -002
23 -003
22 -004
21 -005
20 -006
19 -007
18 -029
17 -030
16 -031
15 -032
14 -033
26 -027
27 -026
28 -025
29 -024
30 -023
31 -022
32 021
59 -001
58 -002
57 -003
T.M. 3-16-79
#11932
APPROVED
LORAIN CO.
MAP DEPT.
DATE 8-11-78
PAGE 03-00-013-B
BY C. Francis
VOID 11932