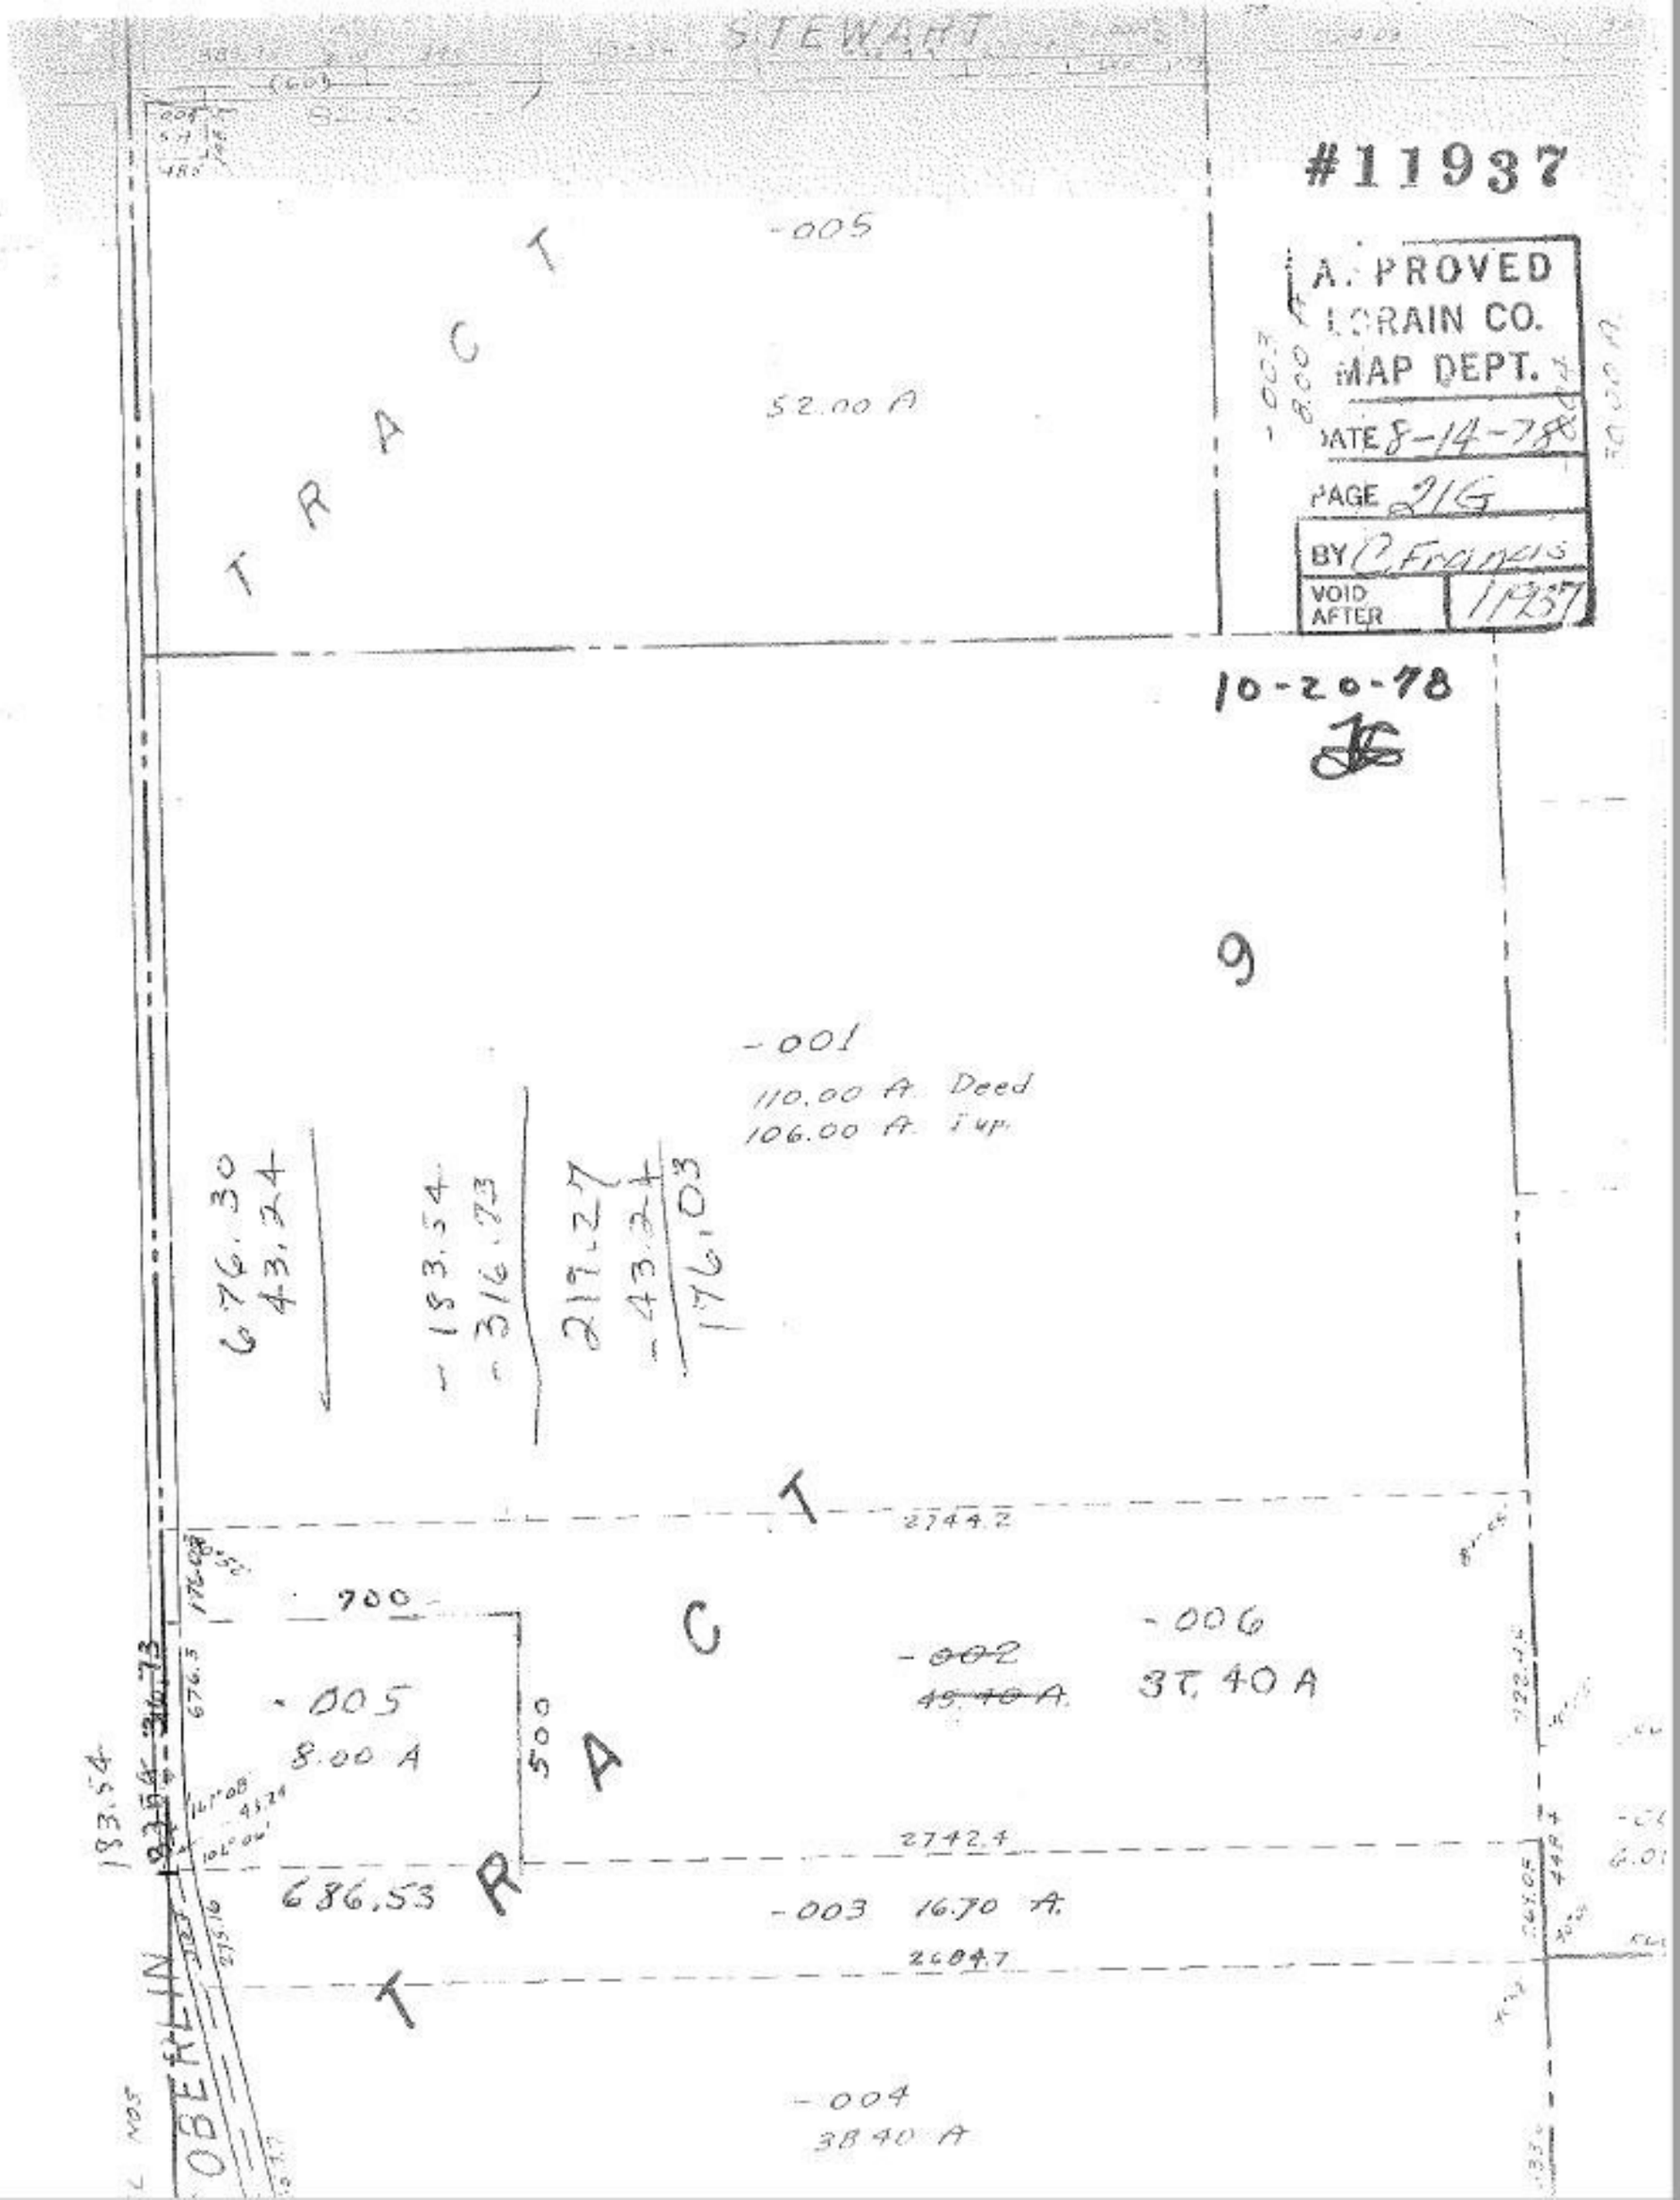
STEWART
#11937
APPROVED
LORAIN CO.
MAP DEPT.
DATE 8-14-78
PAGE 21G
BY C. Francis
VOID AFTER 11937
10-20-78
TRACT
-005
52.00 A
9
-001
110.00 A. Deed
106.00 A. Twp.
676.30
43.24
-183.54
-316.73
219.27
-43.24
176.03
2744.2
700
-005
8.00 A
500
-006
37.40 A
-002
49.40 A
2742.4
686.53
-003 16.70 A.
2684.7
-004
38.40 A
183.54
OBERLIN