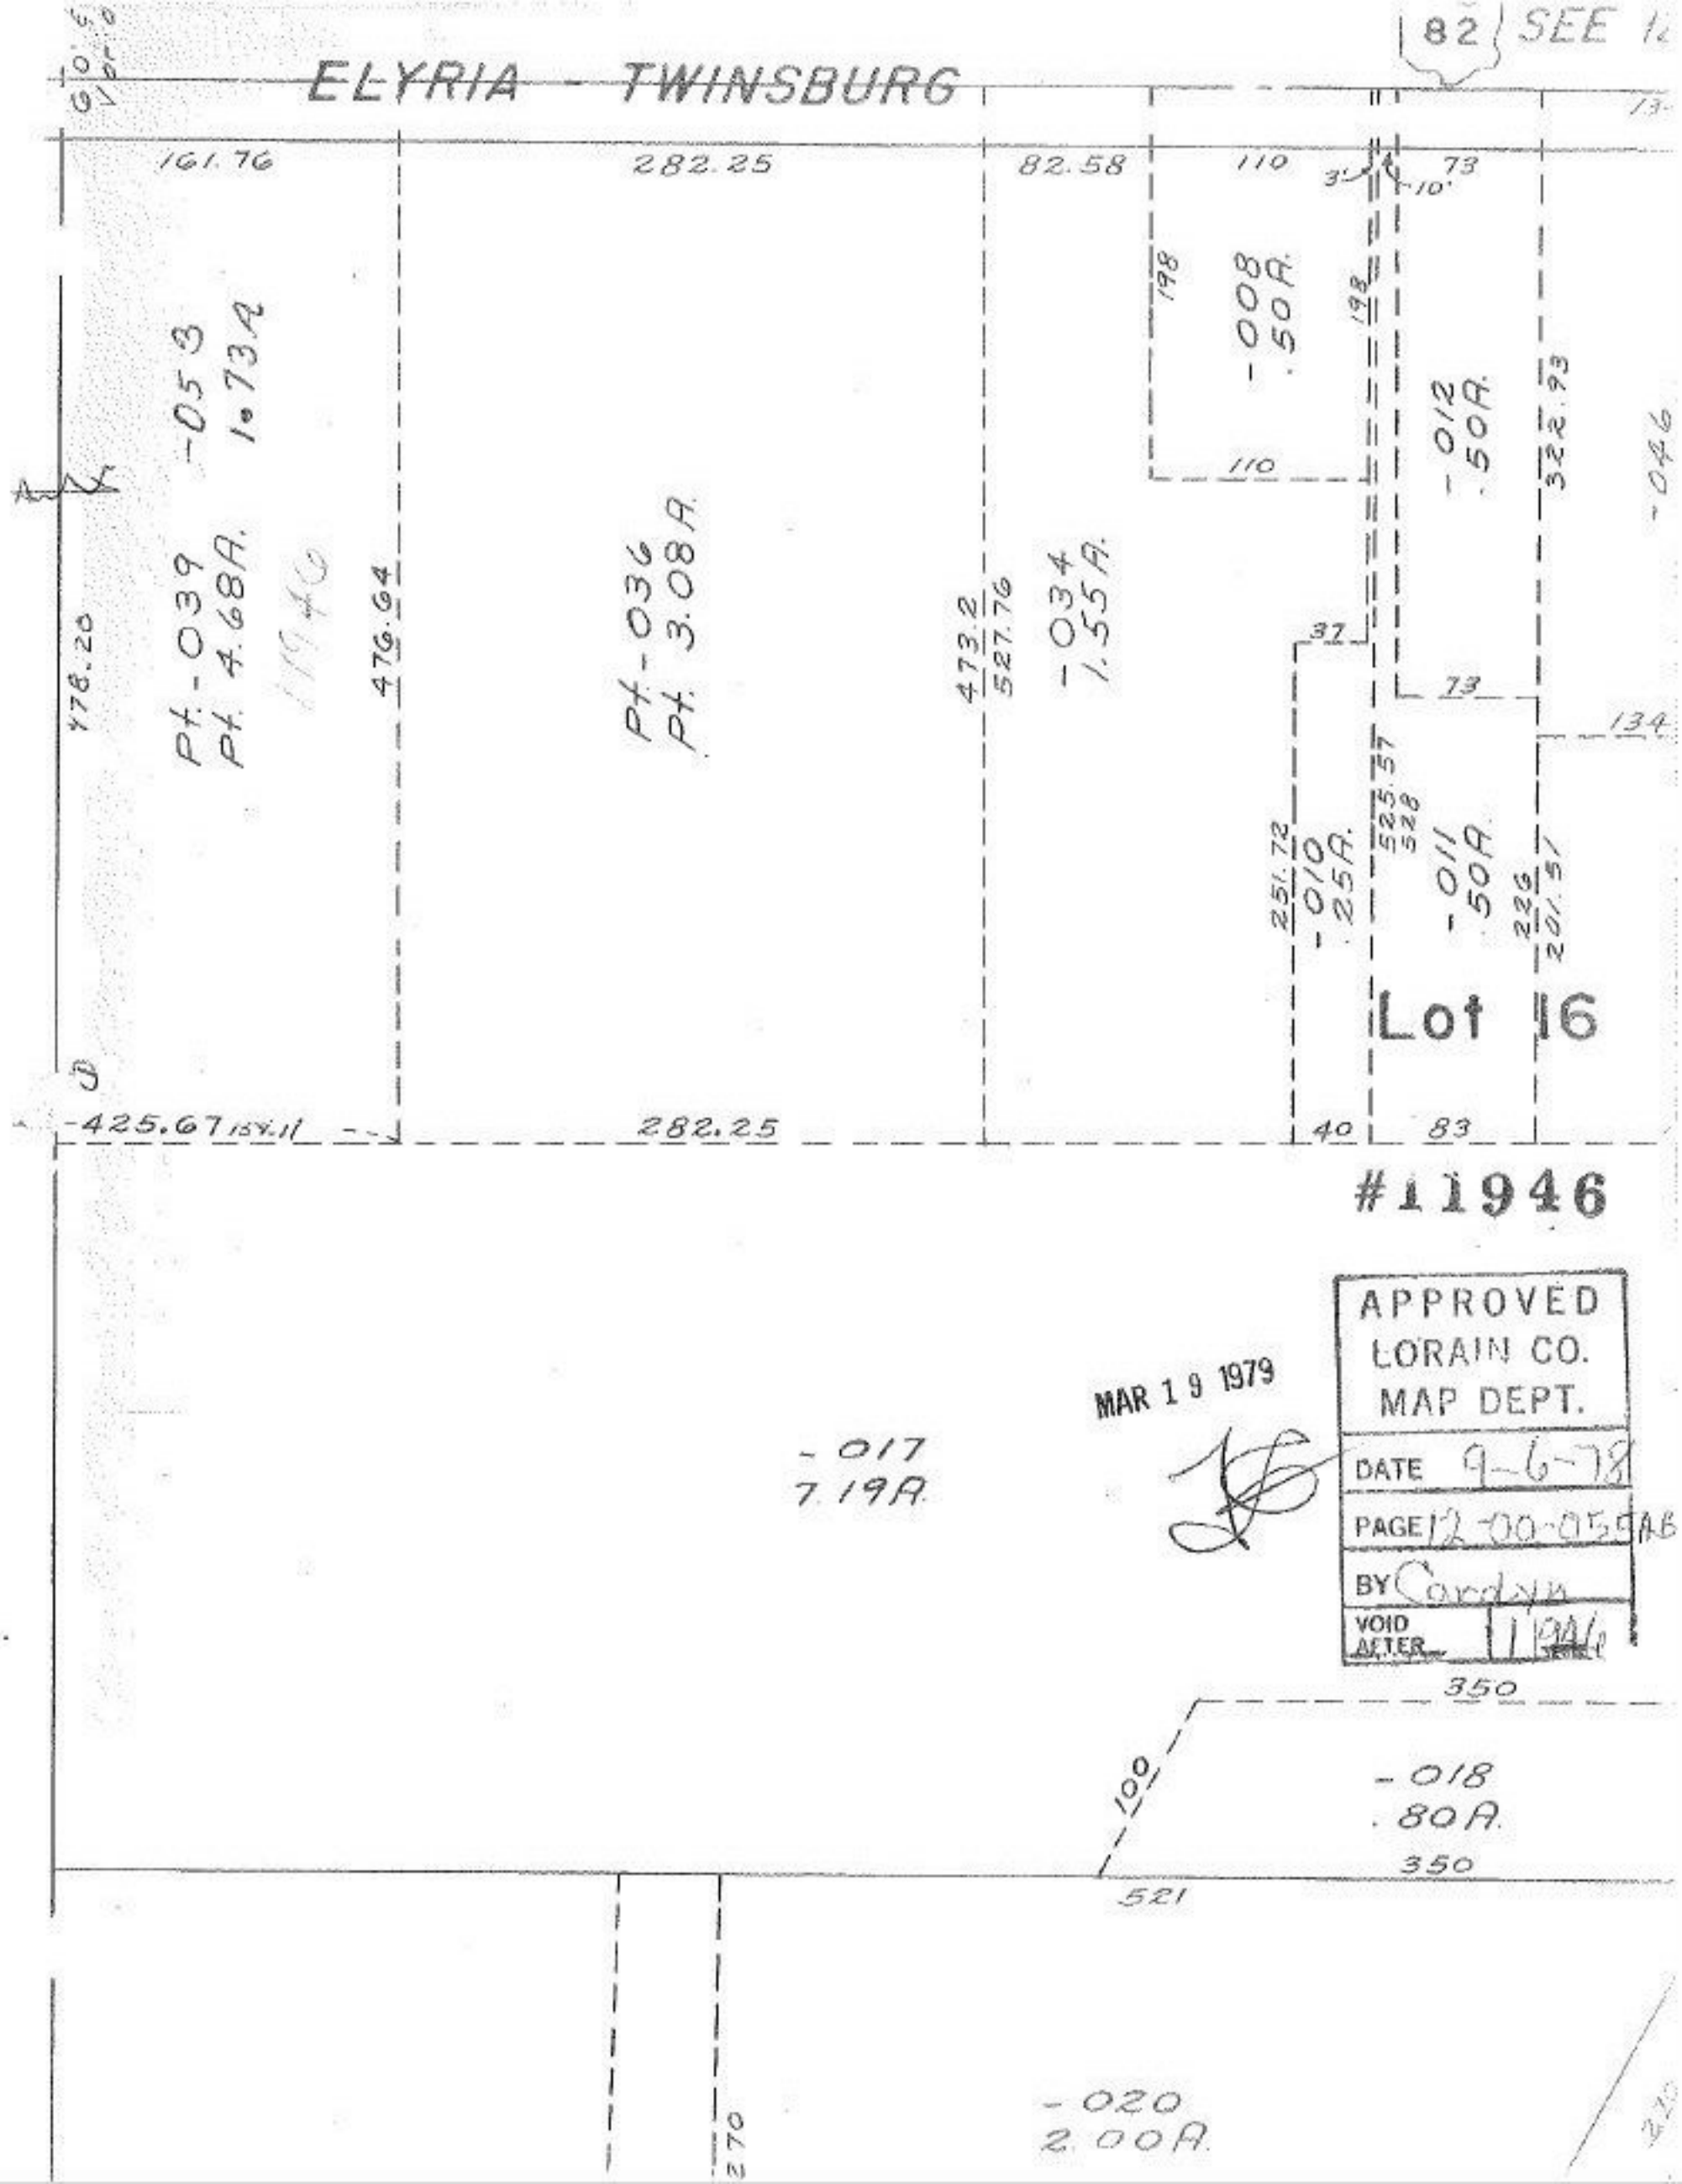

ELYRIA - TWINSBURG
82
SEE 12
161.76
282.25
82.58
110
73
3'
10'
198
-008
.50A.
198
110
-012
.50A.
322.93
-046
-053
1.73A
Pt.-039
Pt. 4.68A.
476.64
Pt.-036
Pt. 3.08A.
473.2
527.76
-034
1.55A.
37
73
134
478.20
251.72
-010
.25A.
525.57
528
-011
.50A.
226
201.51
Lot 16
-425.67
282.25
40
83
#11946
APPROVED
LORAIN CO.
MAP DEPT.
DATE 9-6-78
PAGE 12-00-055AB
BY Cordyn
VOID AFTER 11946
MAR 19 1979
-017
7.19A.
350
100
-018
.80A.
350
521
-020
2.00A.
270