#11948

10-00-008-D

(114) Pt -036
Pt. 9.26R.

APPROVED
LORAIN CO.
MAP DEPT.
DATE 9-18-78
PAGE 10-00-008-C-D
BY Carolyn
VOID AFTER 11948

T.M
3-8-79

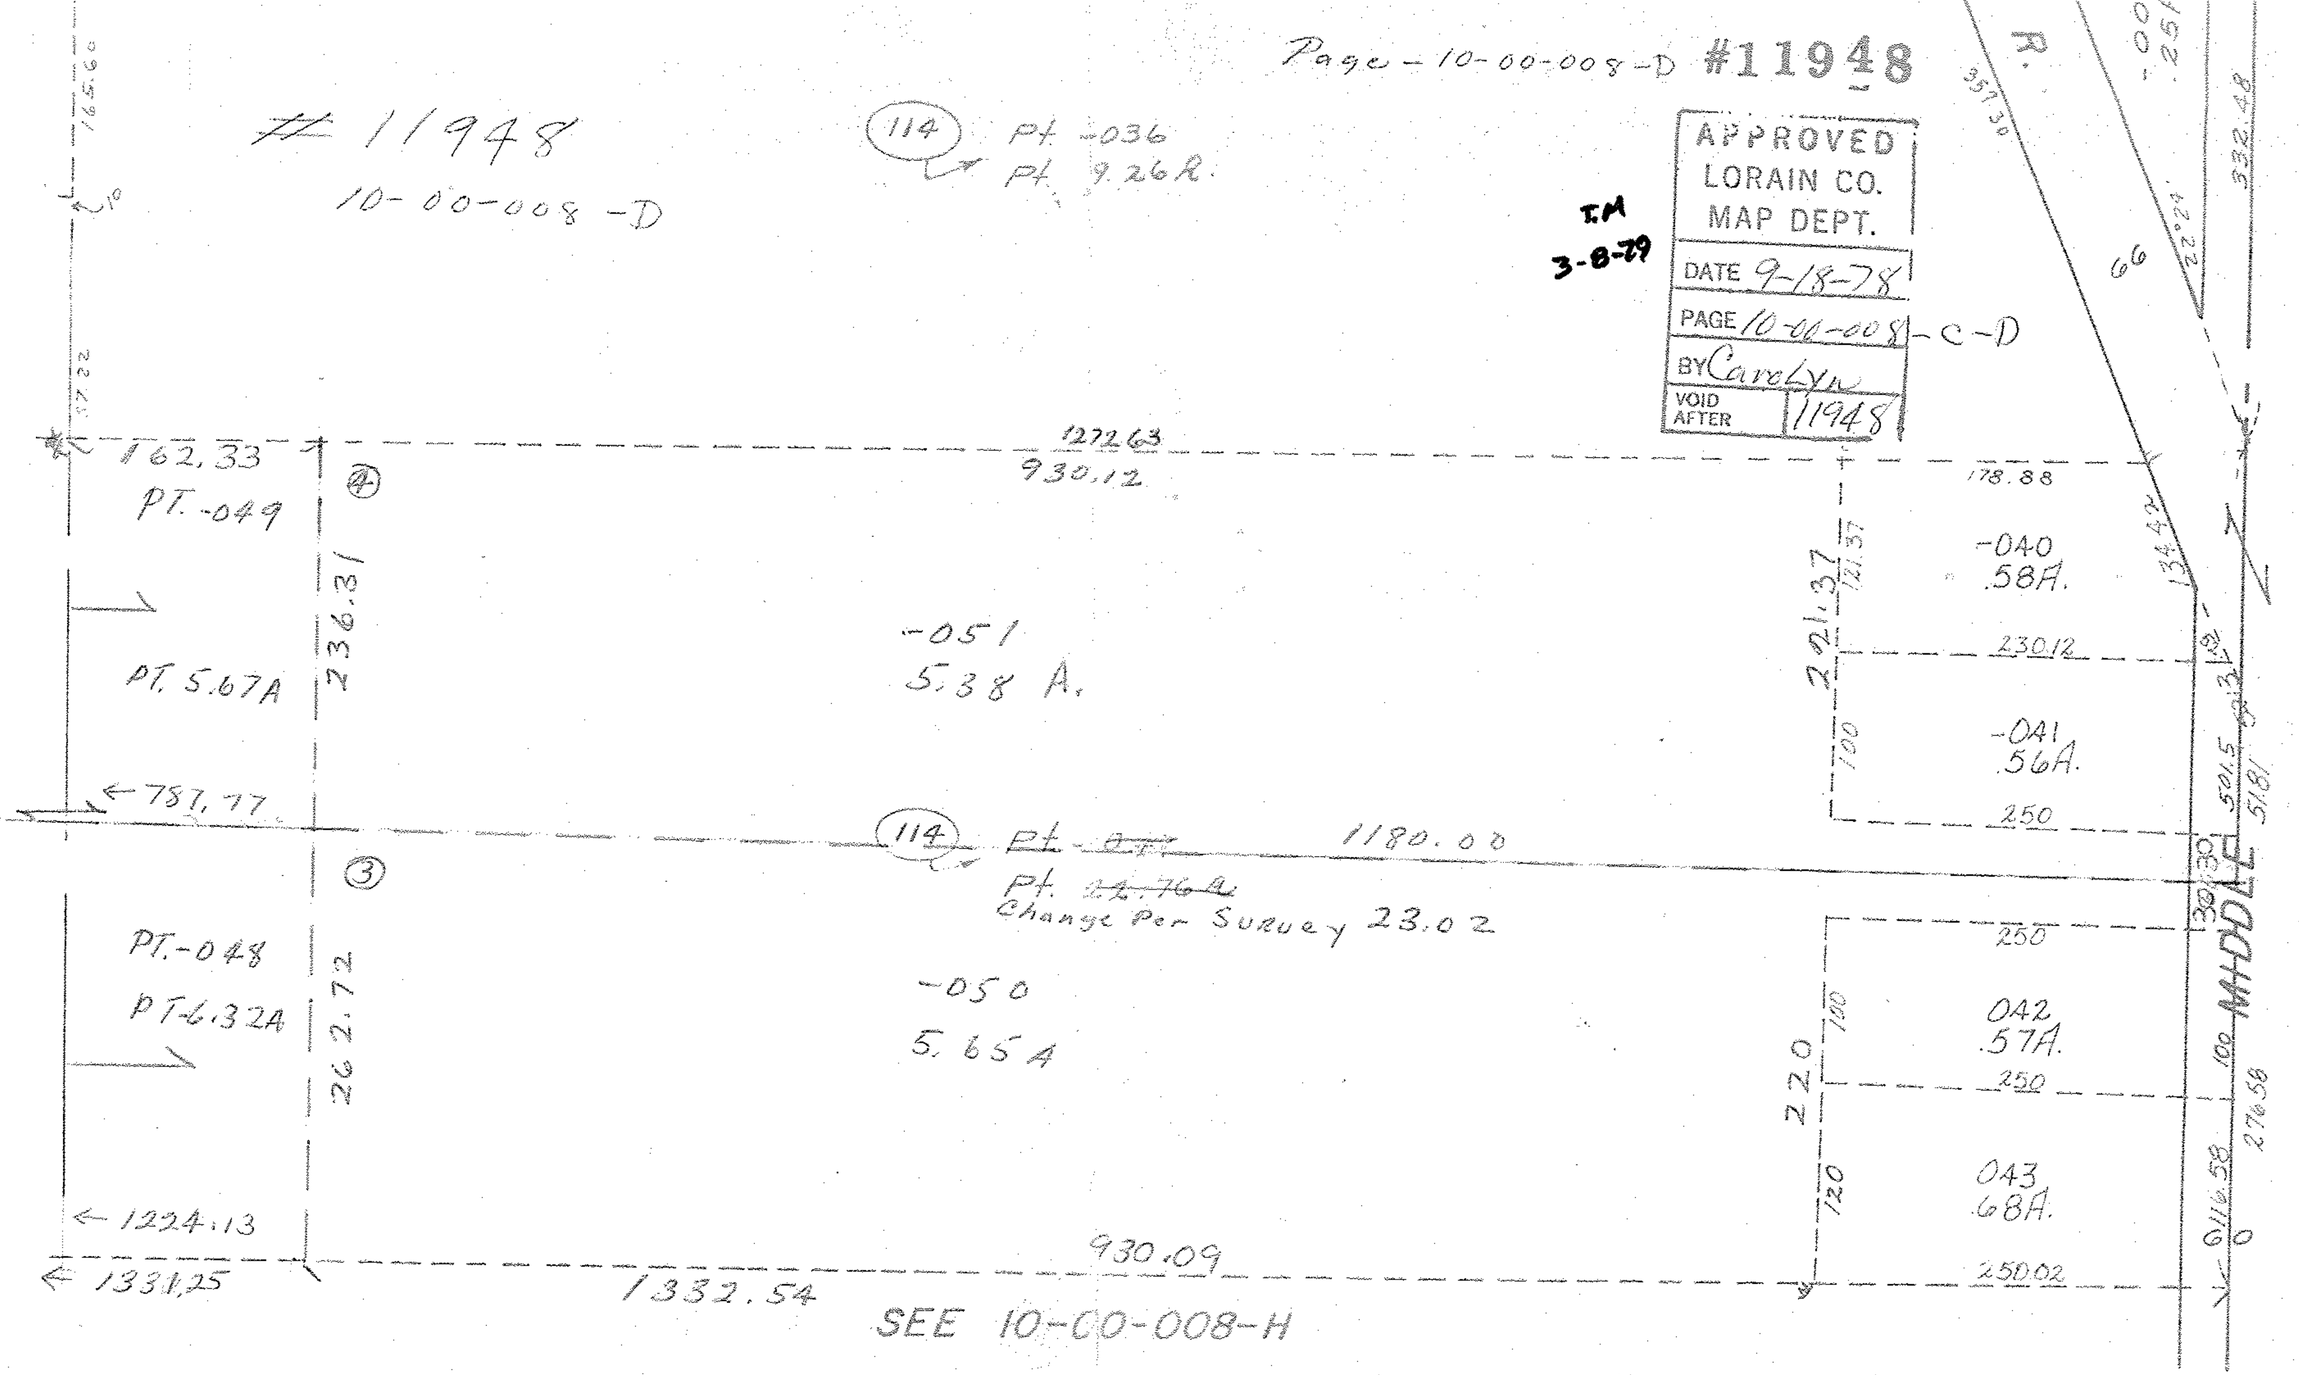

CARLISLE TWP