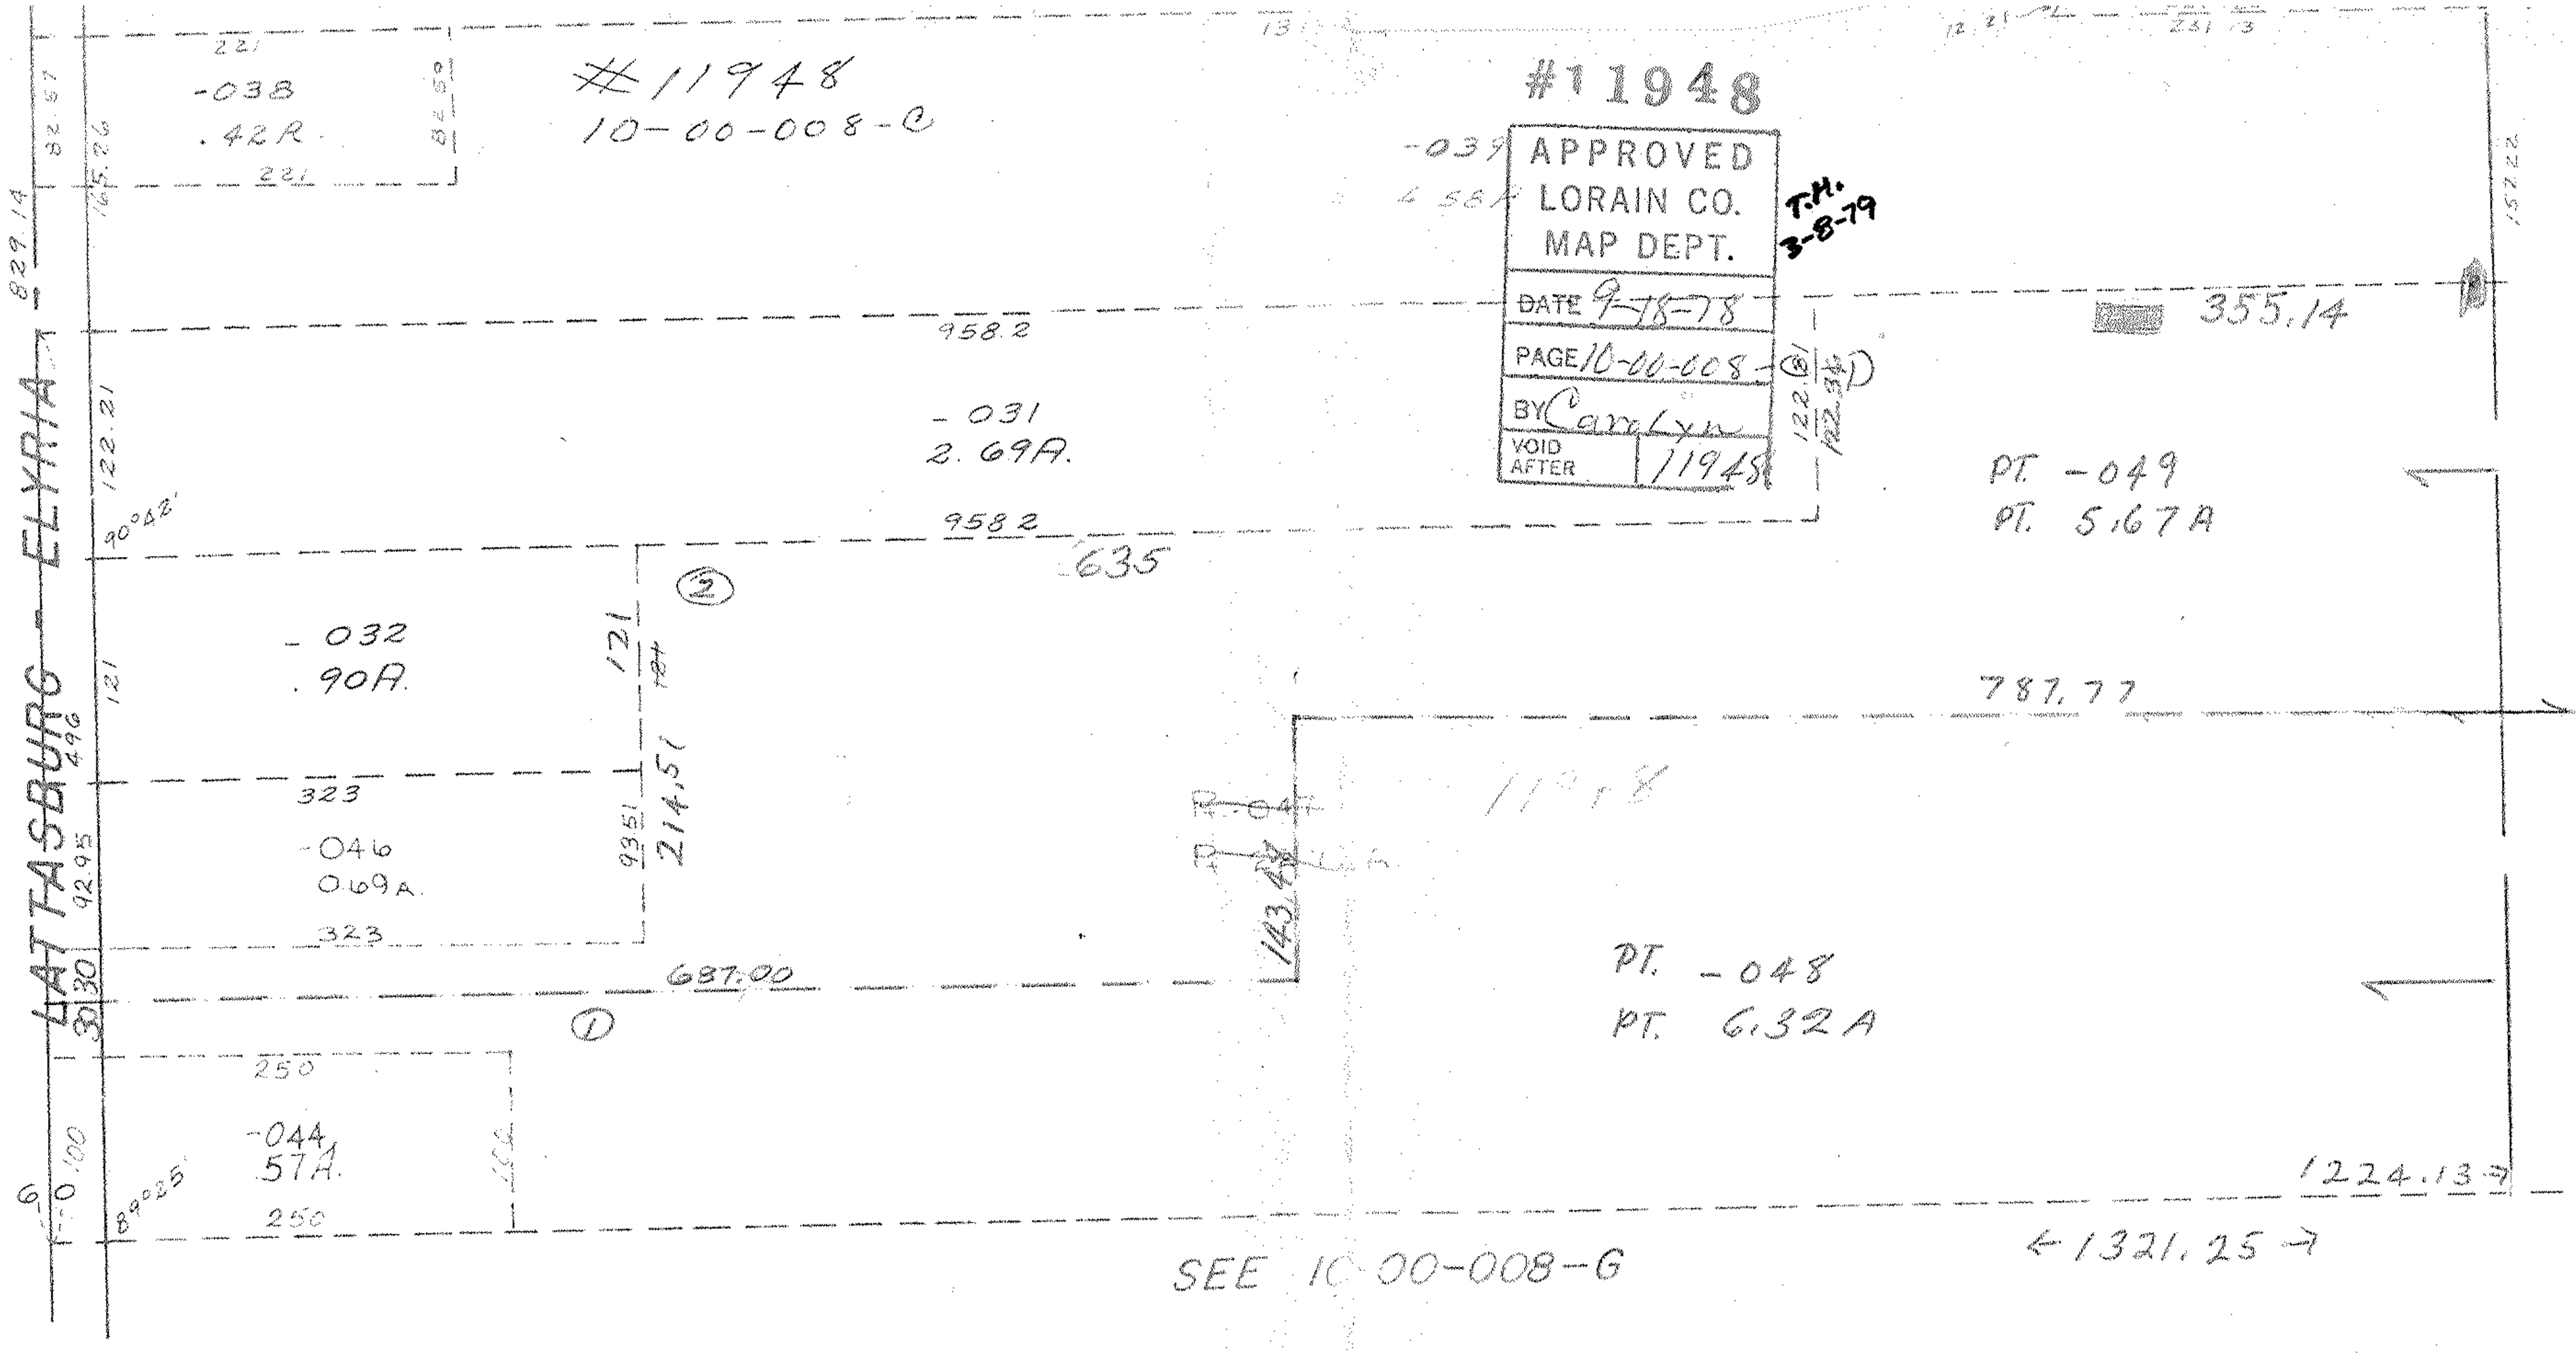

CARLISLE TWP.

008-C

SCALE: 1" = 100'

W.1/2 N.E 1/4 SEC. 8