#11970

#11970

APPROVED
LORAIN CO.
MAP DEPT.

DATE 9-8-78

PAGE 9-00-086 A

BY T. McRae

VOID AFTER
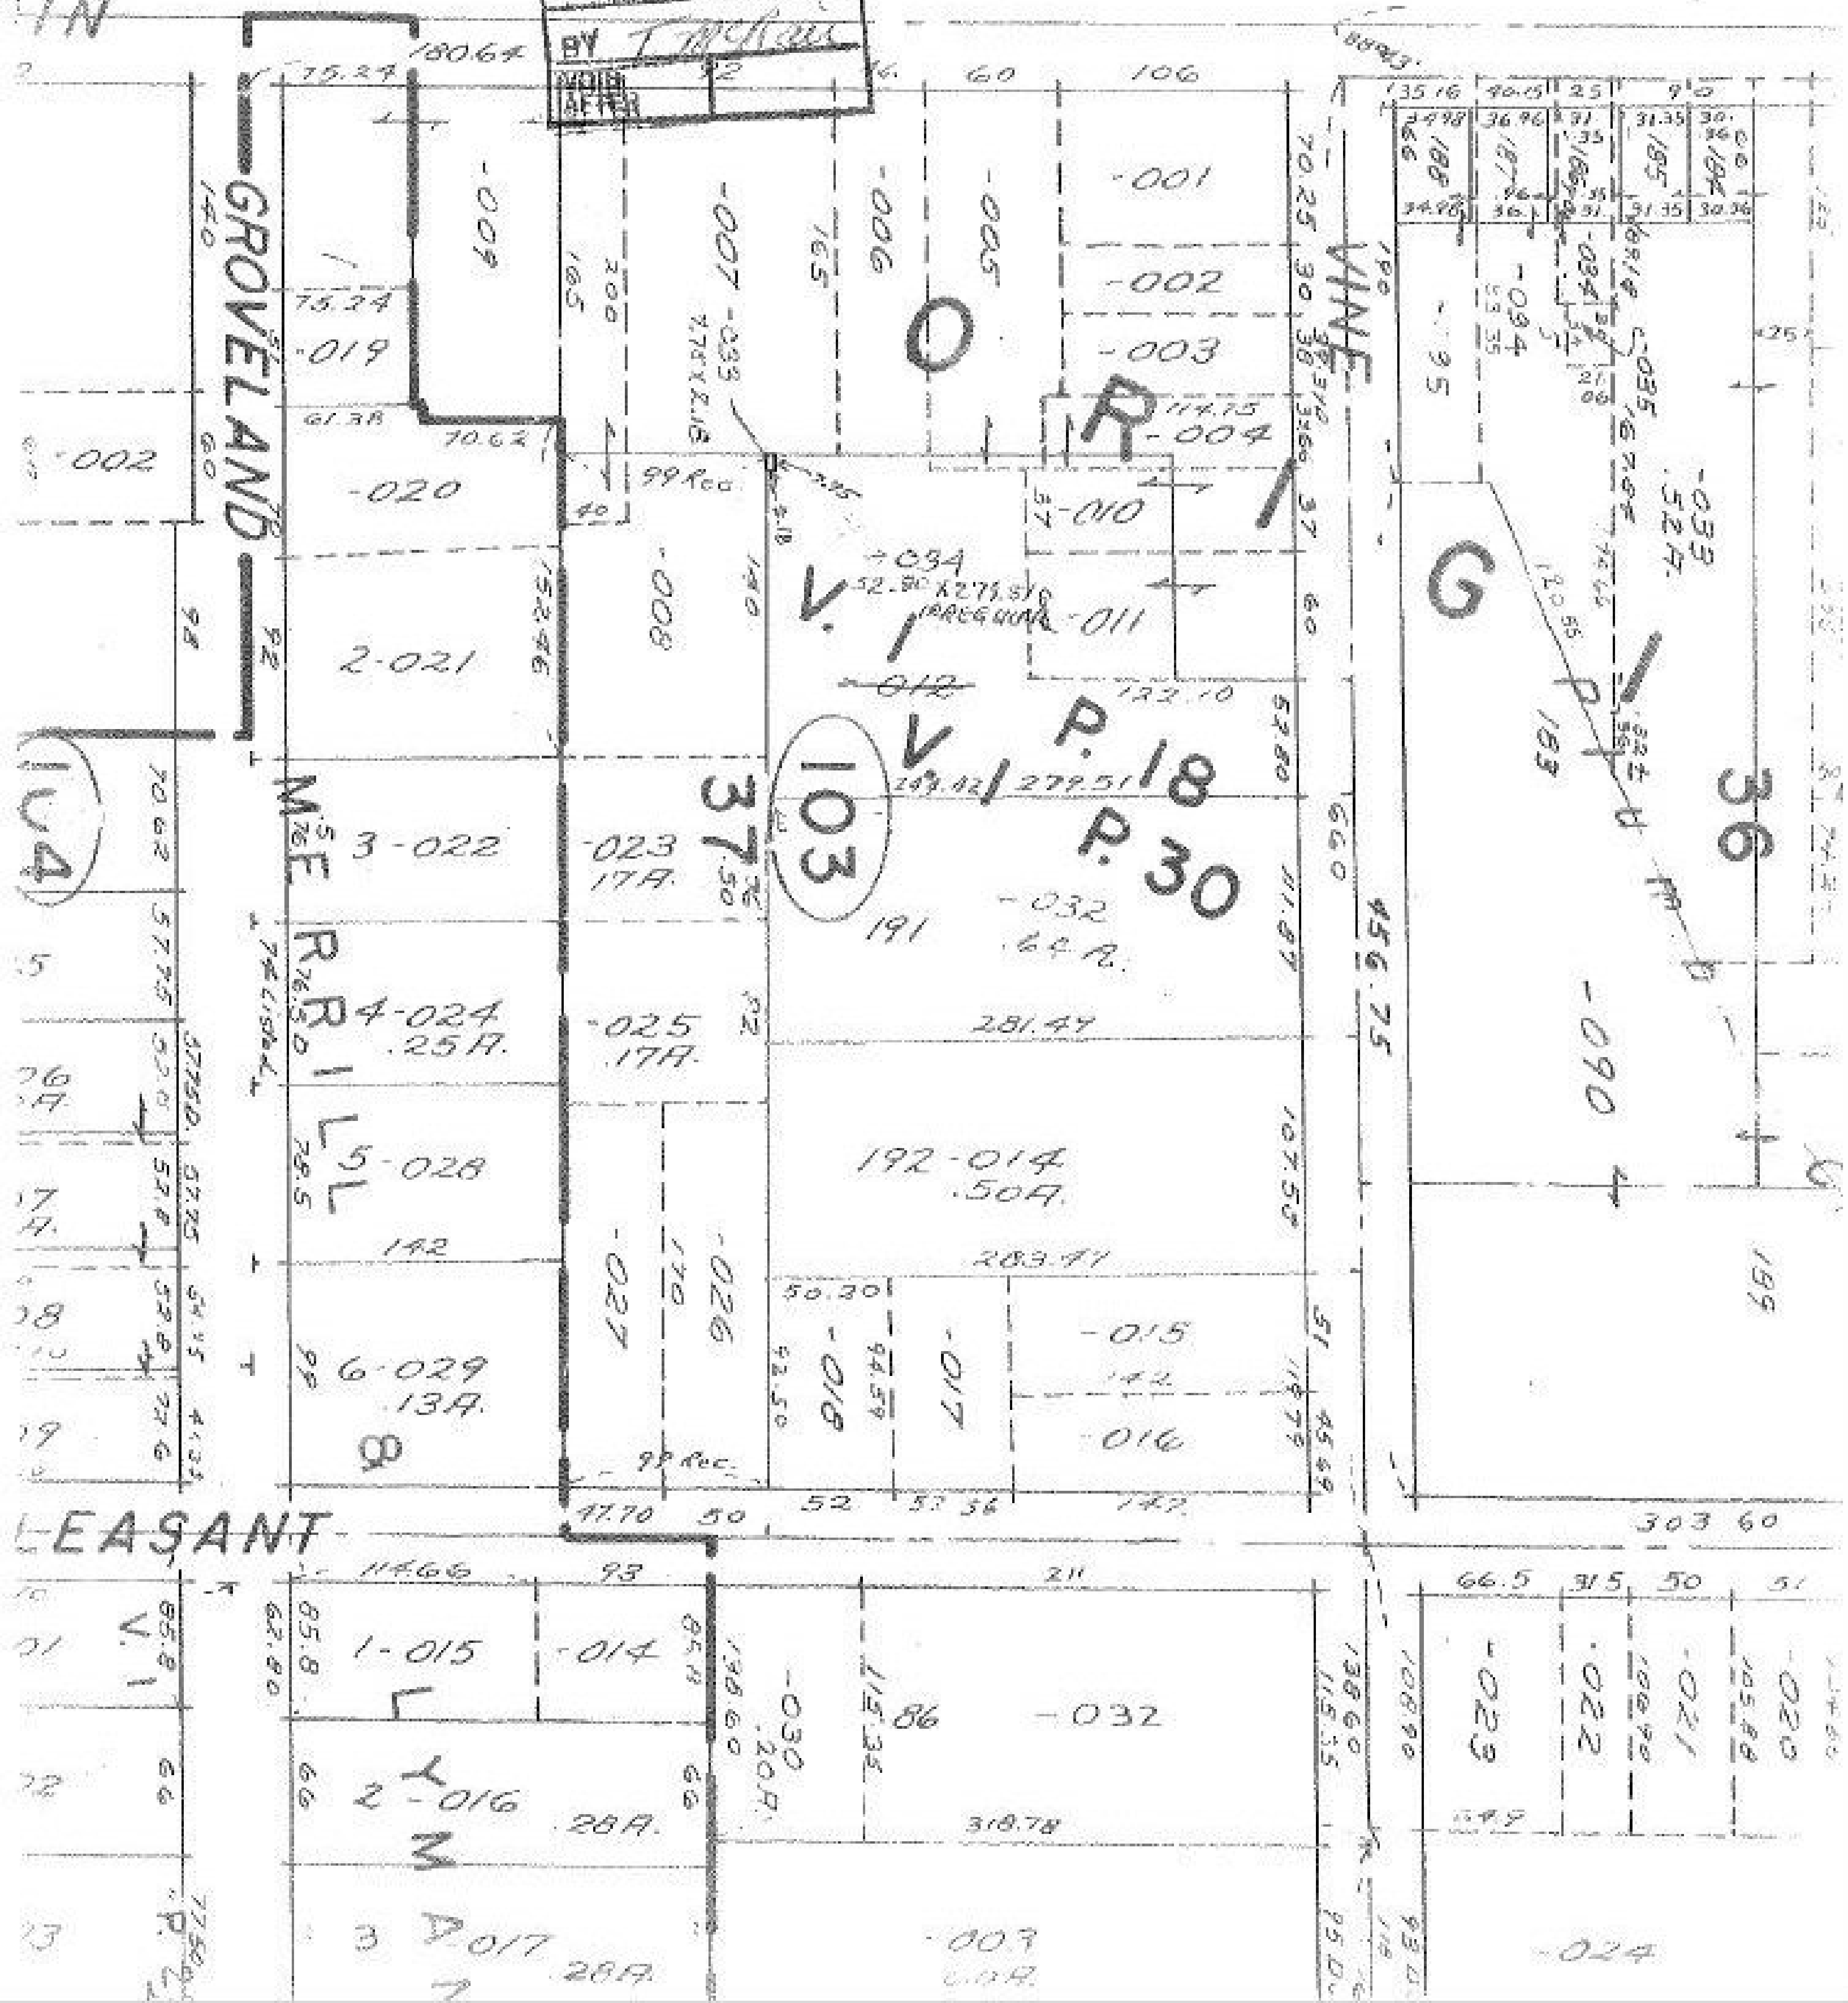
T.M.
3-13-79