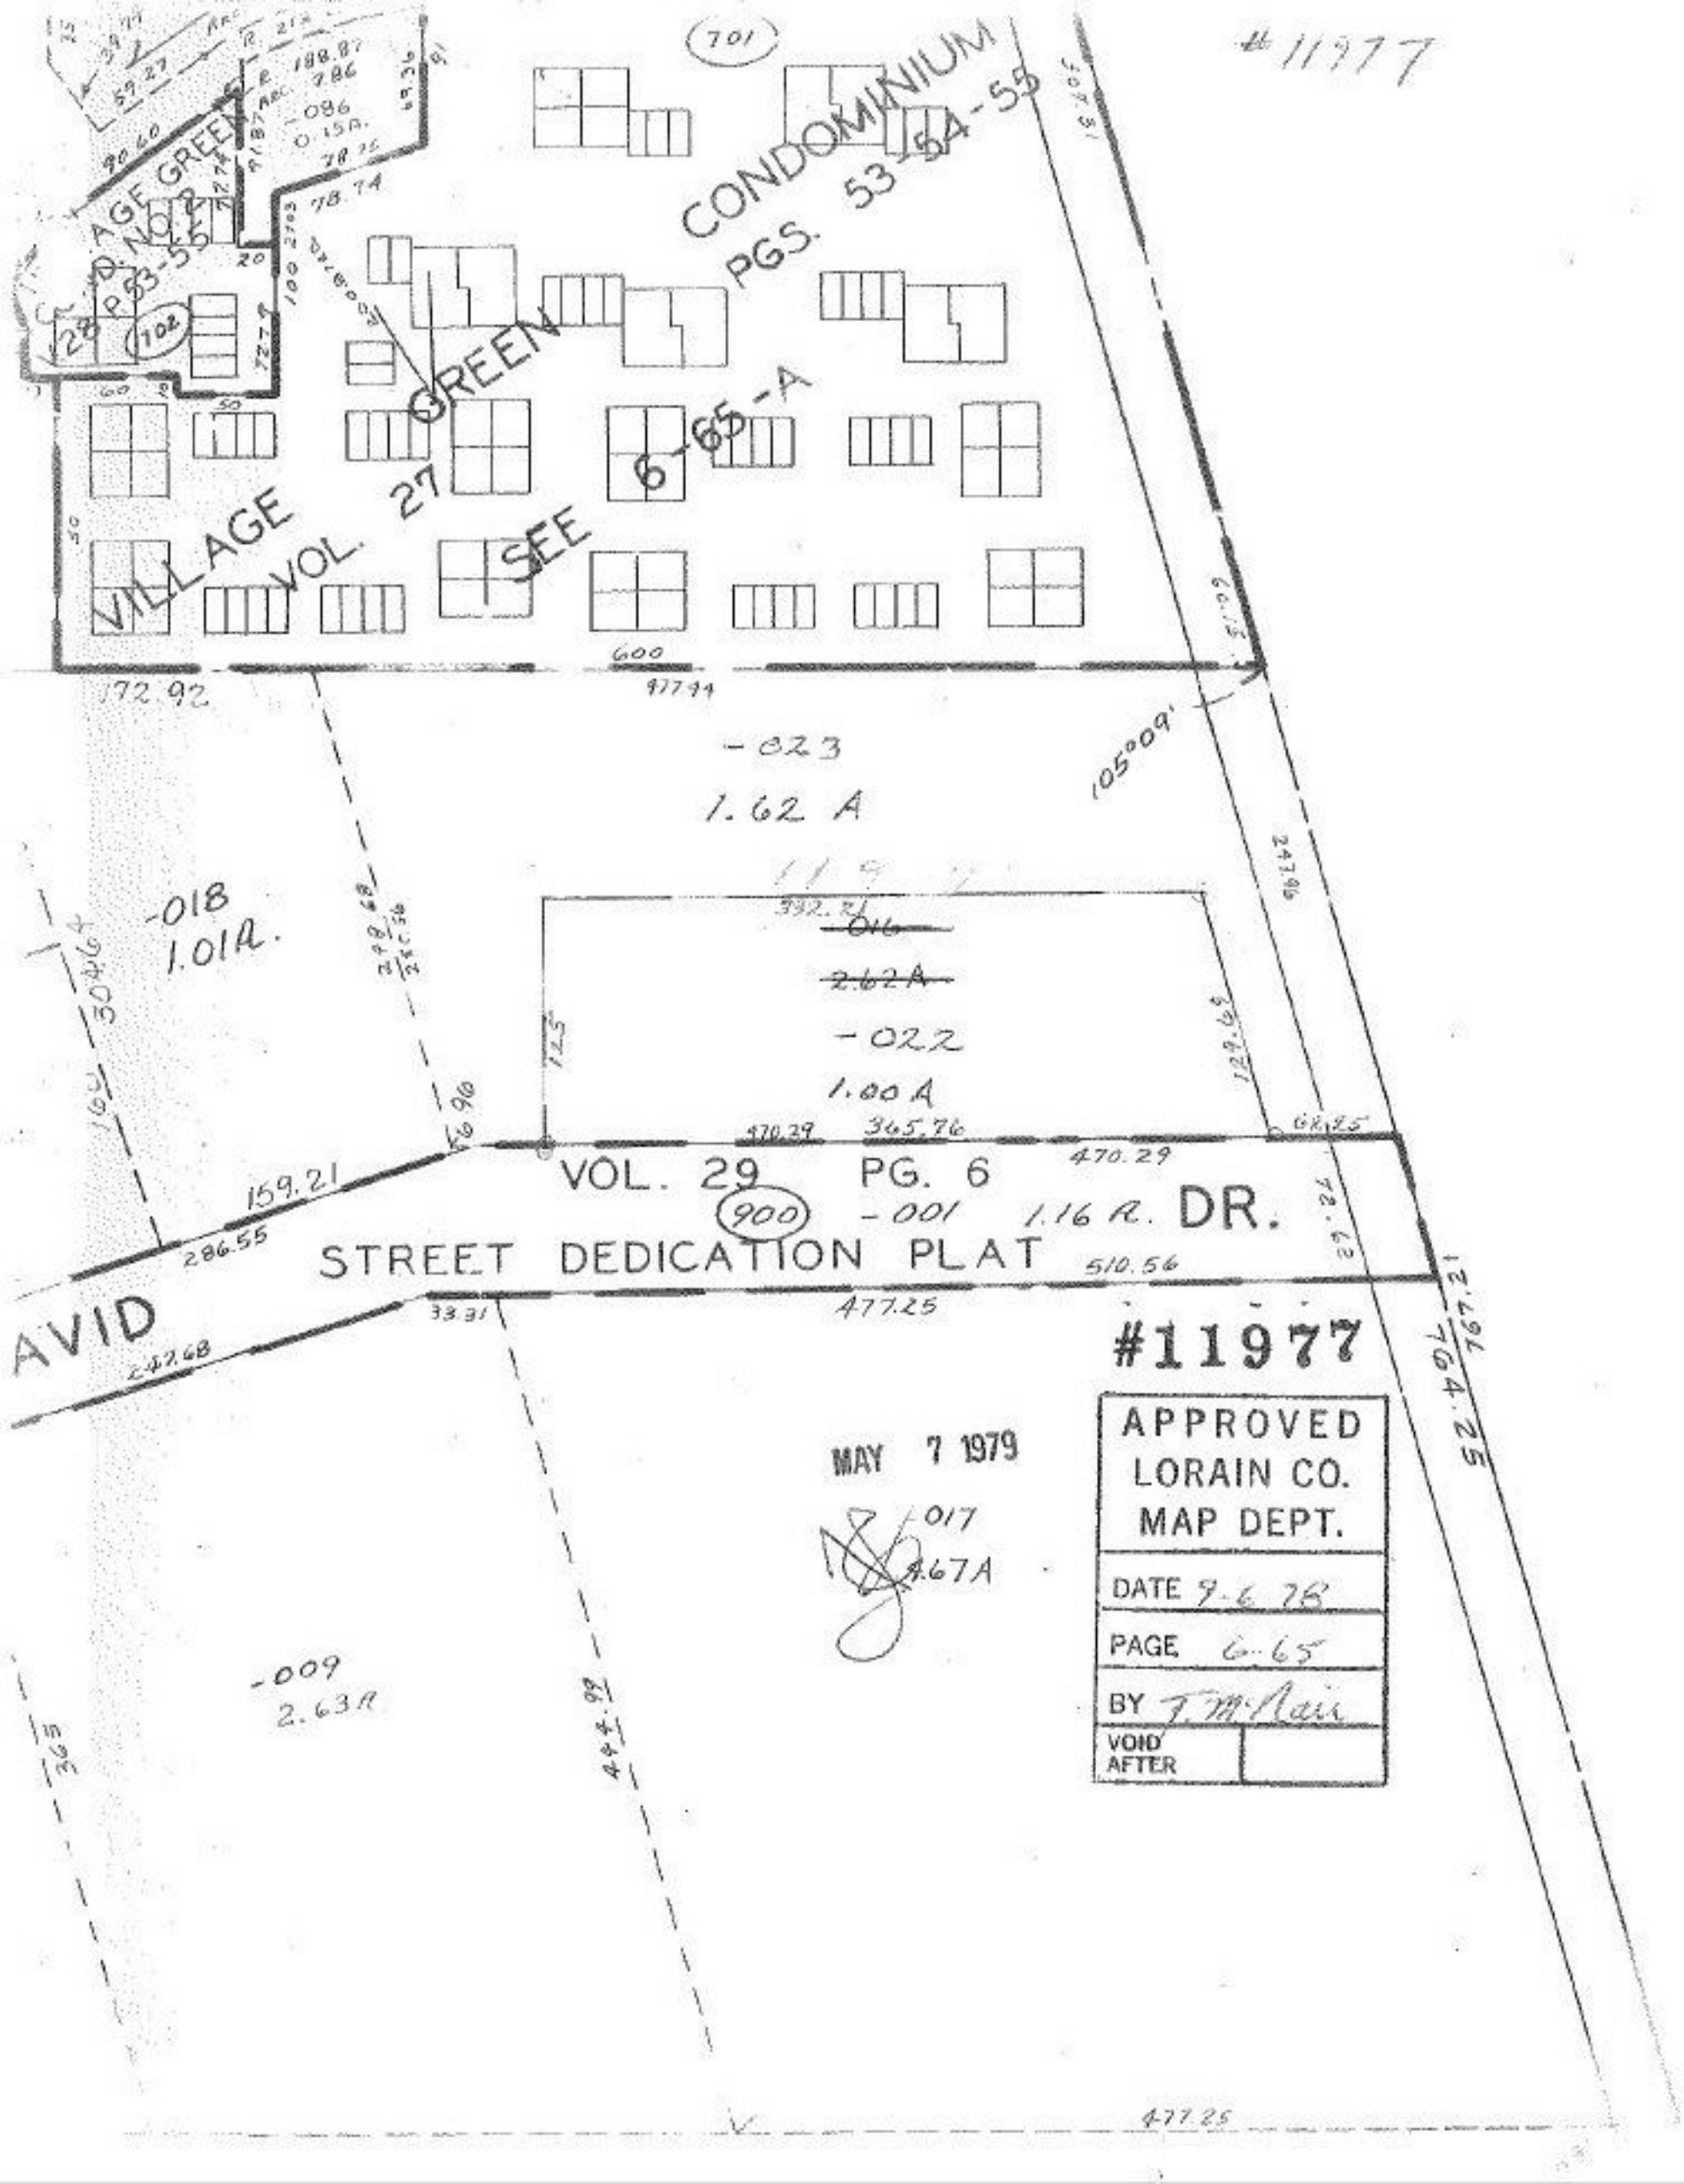

#11977
701
CONDOMINIUM
PGS. 53-54-55
VILLAGE GREEN
VOL. 27
SEE 6-65-A
VILLAGE GREEN
NO. 2
P. 53-55
702
600
172.92
477.44
-023
1.62 A
105°09'
-018
1.01A.
-016
2.62A
-022
1.00 A
470.29
365.76
470.29
VOL. 29 PG. 6
900
-001
1.16 A.
DR.
159.21
286.55
STREET DEDICATION PLAT
510.56
477.25
AVID
247.68
33.31
#11977
APPROVED
LORAIN CO.
MAP DEPT.
DATE 9-6-78
PAGE 6-65
BY T. McNair
VOID AFTER
MAY 7 1979
-017
4.67A
-009
2.63A
444.99
365
477.25