PARENT PARCEL: 04-00-022-102-026, -053, -055, -060

CHILD PARCEL: 04-00-022-102-074 THRU -079

STARTING POINT: AT A MON BOX AT THE NORTHEAST CORNER OF SEC.22

12-00278

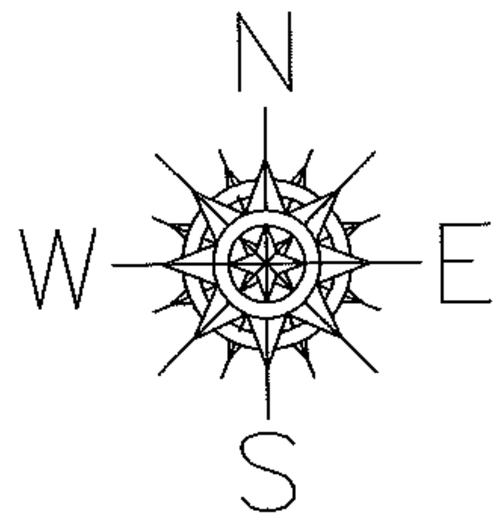

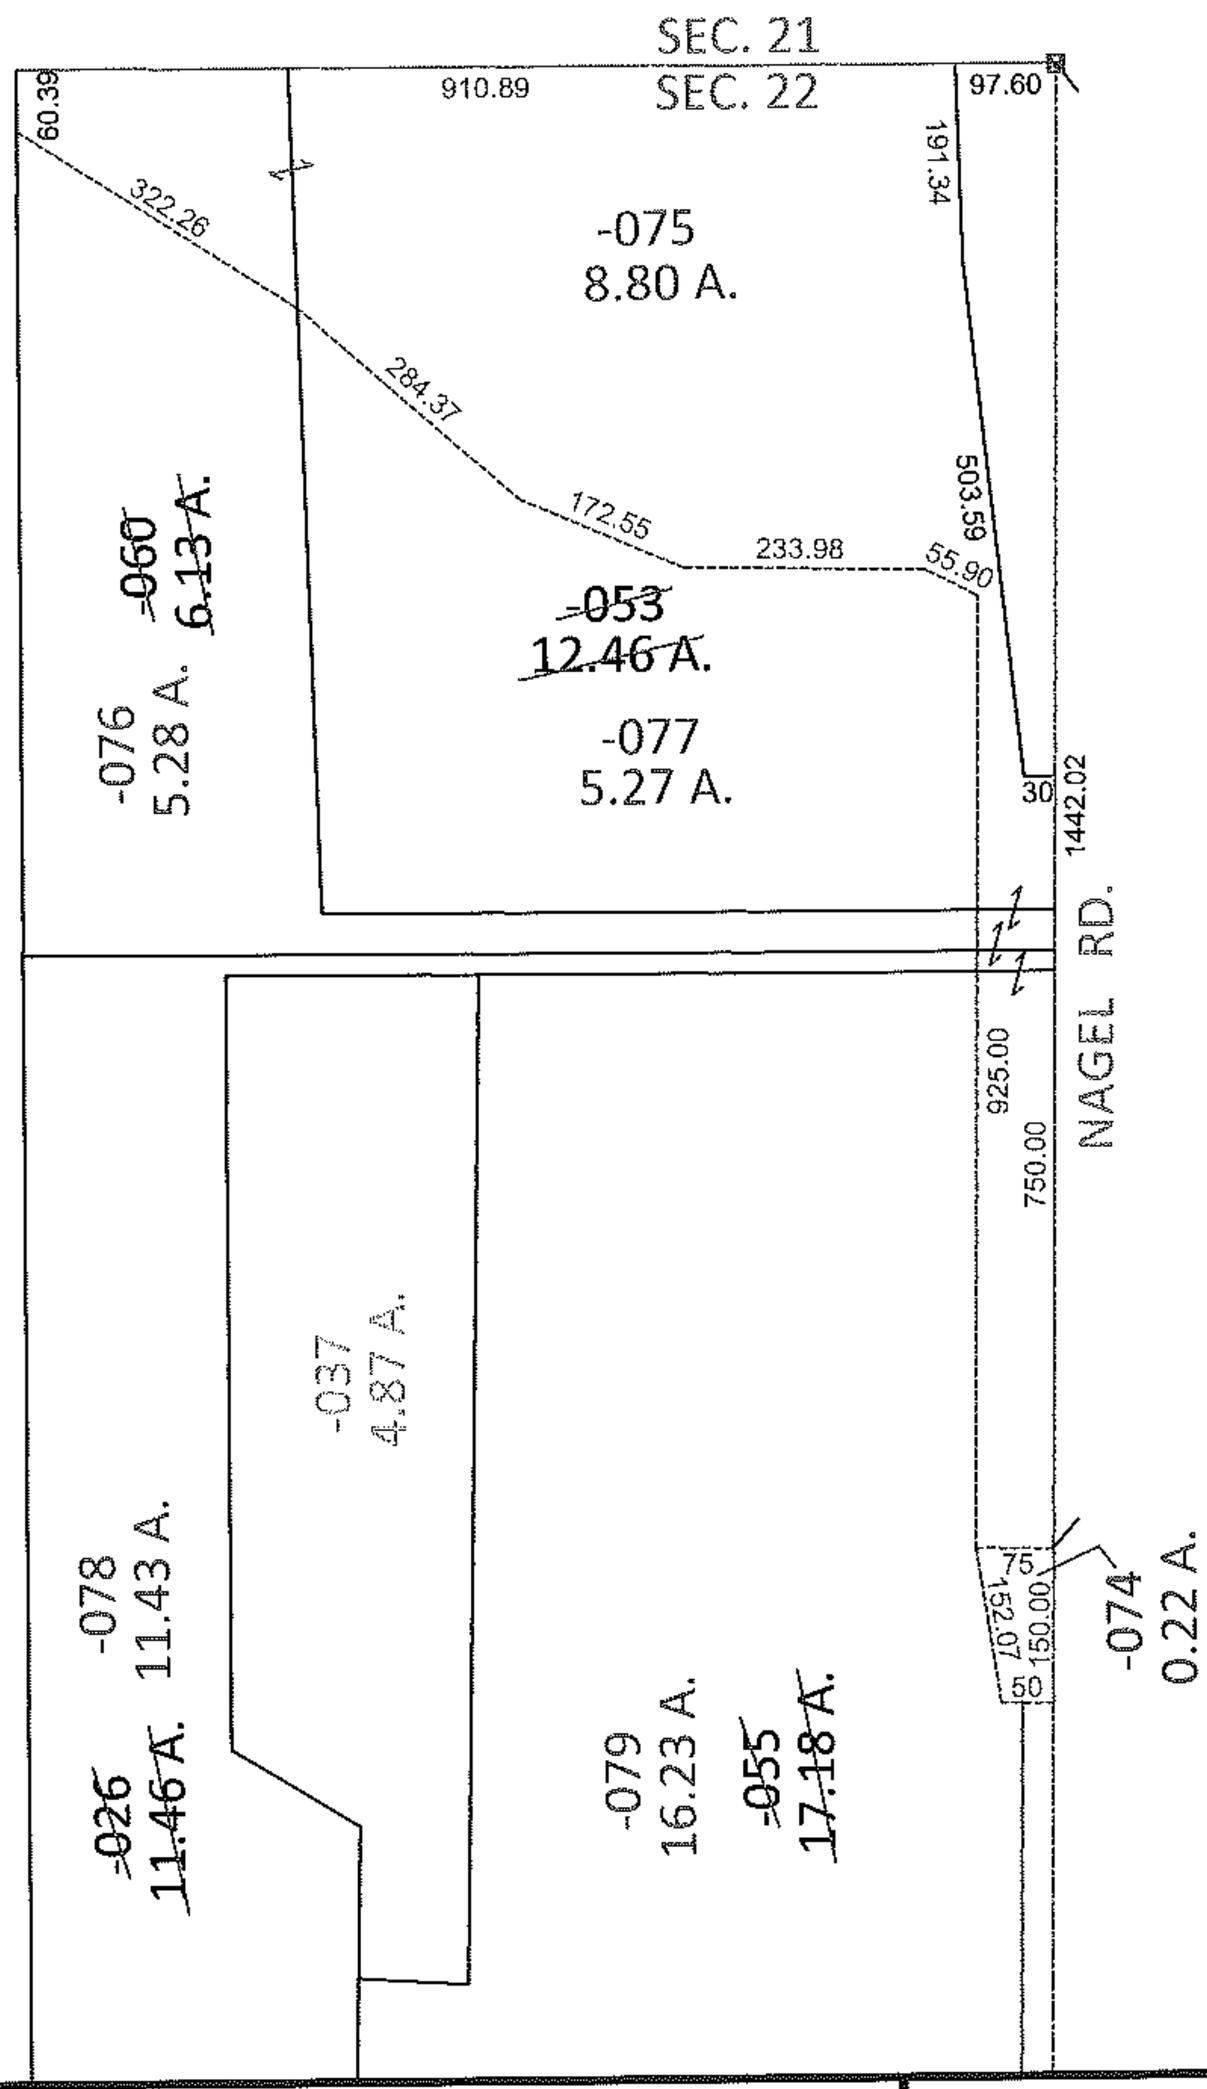

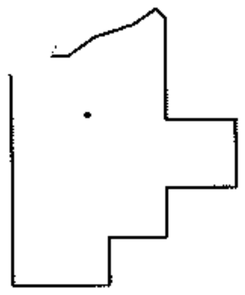

SPLITS/DEEDS PROCESSED

LORAIN COUNTY TAX MAP DEPARTMENT
226 MIDDLE AVE. ELYRIA, OHIO

SURVEYED BY: WILLIAM J. SALA

CLOSURE: .01:10,000

MAP PAGE(S): 4-00-022-D & H

APPROVED BY: RRM DATE: 5-4-12

SCALE: 1"= 300 PRIOR INST.: 19970493429