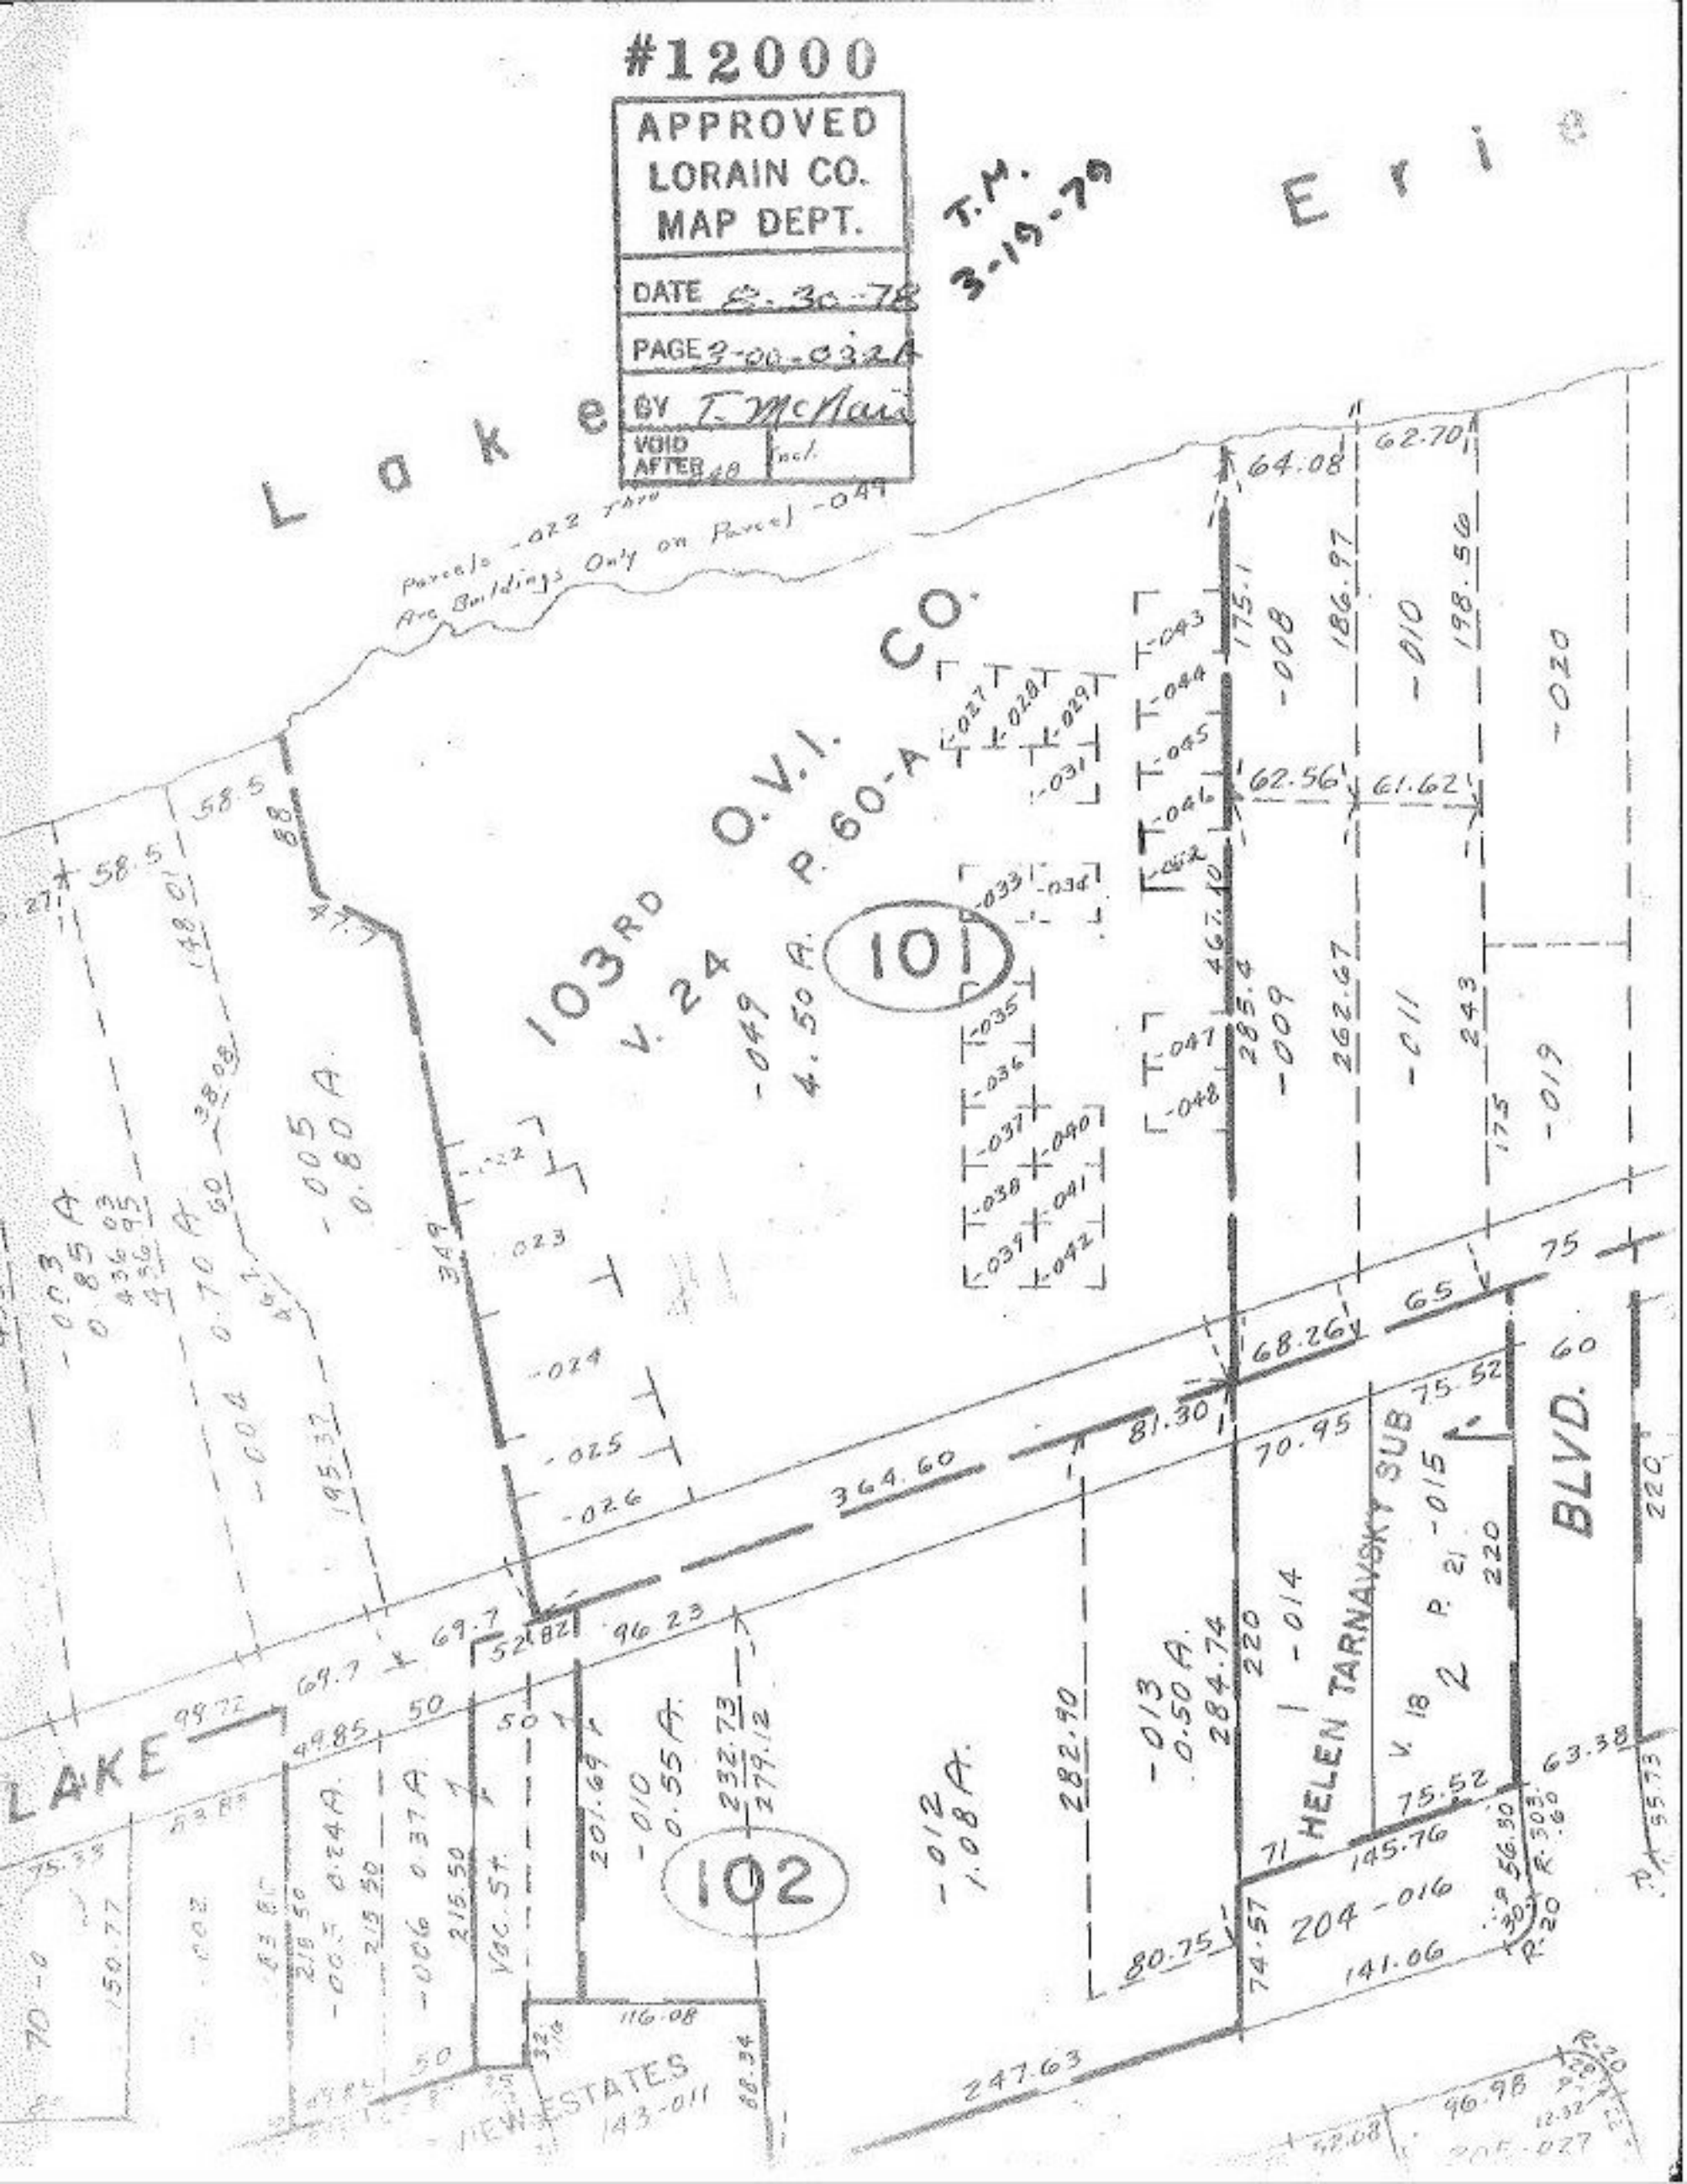
#12000
APPROVED
LORAIN CO.
MAP DEPT.
DATE 8-30-78
PAGE 3-00-032A
BY T. McNair
VOID AFTER
Incl.
T.M. 3-19-79
Lake Erie
Parcels -022 Thru
Are Buildings Only on Parcel -049
103RD O.V.I. CO.
V. 24 P. 60-A
101
102
LAKE
BLVD.
HELEN TARNAVSKY SUB
V. 18 P. 21
VIEW ESTATES
143-011
204-016
-049
4.50 A.
-005
0.80 A.
-010
0.55 A.
-012
1.08 A.
-013
0.50 A.
-014
-015
-008
-009
-010
-011
-019
-020
364.60
247.63
80.75
74.57
145.76
141.06
63.38
75.52
70.95
68.26
81.30
96.23
52.82
69.7
99.72
49.85
50
58.5
62.70
64.08
62.56
61.62
175.1
186.97
198.56
467.10
285.4
262.67
243
175
220
284.74
282.90
201.69
232.73
279.12
116.08
88.34
96.98
52.08
-043
-044
-045
-046
-047
-048
-027
-028
-029
-031
-033
-034
-035
-036
-037
-038
-039
-040
-041
-042
-022
-023
-024
-025
-026
349
88
47.7
148.01
38.08
195.37
150.77
70-0
75.33
83.83
-003
0.85 A.
-004
0.70 A.
-005
0.24 A.
-006
0.37 A.
215.50
Vac. St.
R-20
R-30
R-60
R-303
R-20